
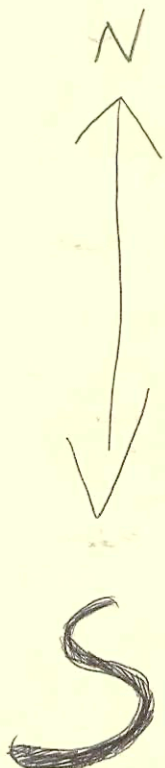


DIST. F - S.S. NO. 20 - 1920

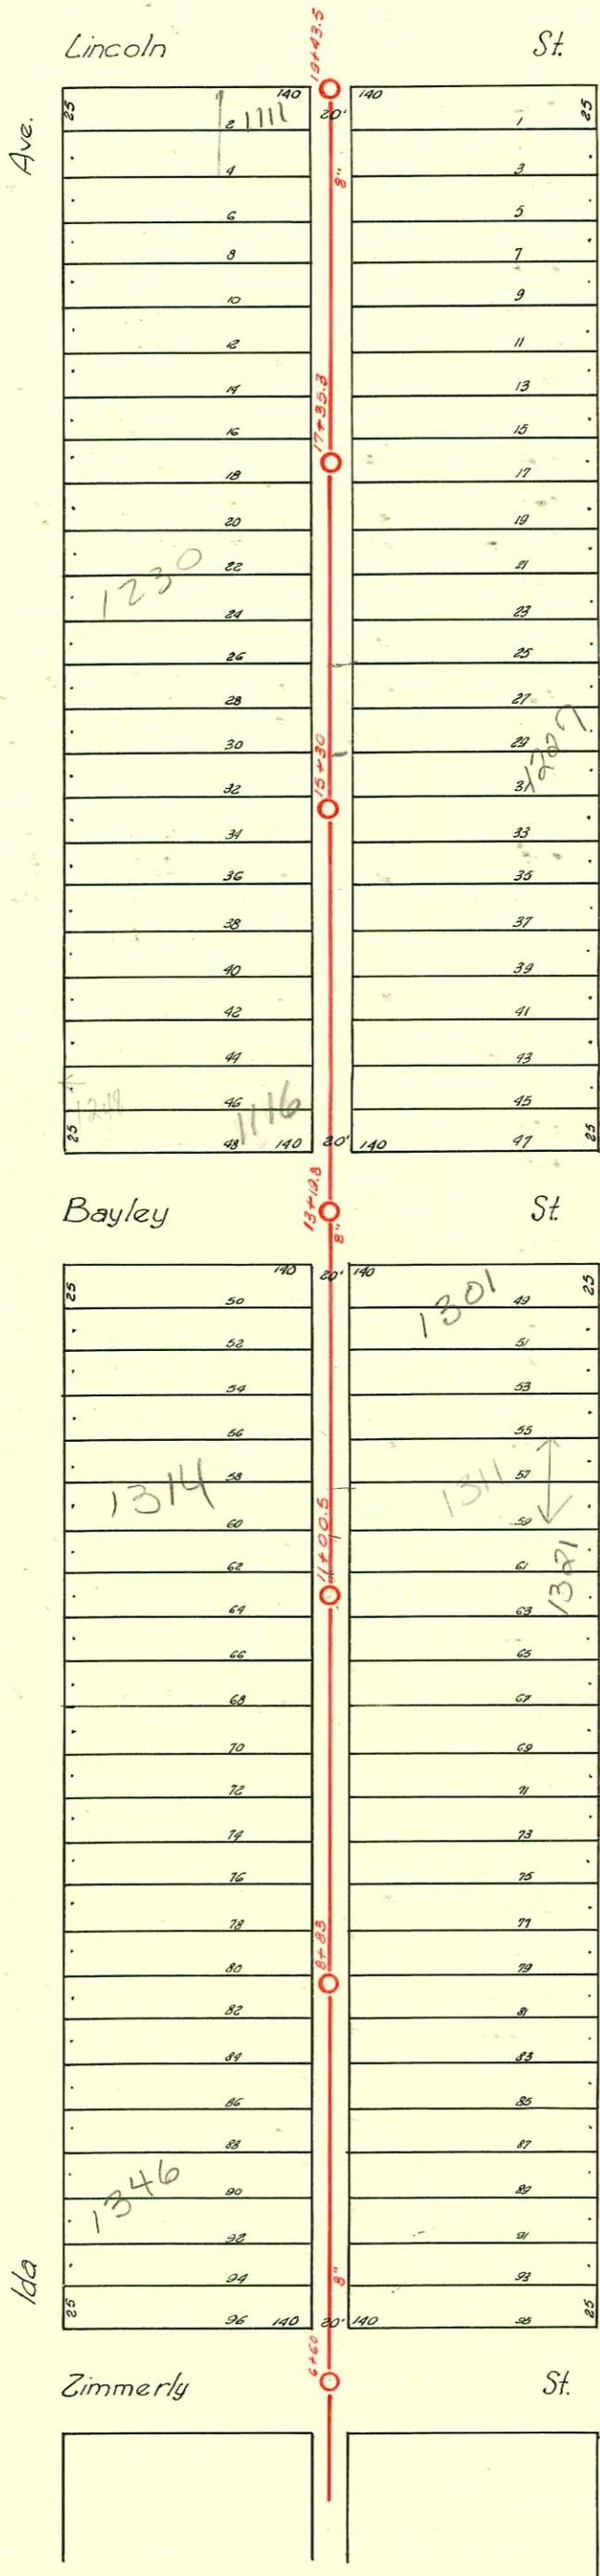

D-106

CONSTRUCTION RECORD						SERVICE RECORD						
STATION	ELEVATION		Depth	MANHOLE	4-INCH "Y" BRANCHES		No. of Permit		House Number		DATE OF PERMITS	
	Ground	Grade			North West	South East	North West	South East	North West	South East	North West	South East
				6+60								
7	104.38	97.38	7.00		+93	+90.5	#1512		1348 Ida		6-30-24	
					+20.5 4" 40 PVC +46	+18 +43.5	#2003- 02714 1507	#665	1346 R Sec Ida below 1351	1353 Laura	10-22-03 6-30-24	4-3-24
					+73	+70.5		#735	1344 Ida	Laura		4-8-24
					+99.5	+97	#529		Ida		6-22-26	
8	105.16	97.48	7.68	8+83	+23.5	+23	#1255	#736	1342 Ida	1349 Laura	1-14-47	4-8-24
					+51	+48.5		#1149				
					+77.5	+75						
9	104.26	97.58	6.68		+03.5	+01	#1254 877		1338 Ida 1318 Ida		1-14-47 8-8-25	
					+29	+26.5		#79	1330 Ida		2-16-25	
					+55.5	+53		#1060		1333 Laura		8-14-29
					+82	+79.5						
10	103.91	97.68	6.23		+05.5	+03	#1611 1503		1326 Ida		1-20-67 6-23-24	
					+33.5	+31		#705		1327 Laura		4-7-24
					+58	+55.5	#1557	#706	1324 Ida	1323 Laura	7-7-24	4-7-24
					+85	+82.5						
11	103.71	97.78	5.93	11+00.5	+10	+07.5	#4619	#325	1320 Ida	1321 Laura	5-11-51	5-6-81
					+36.5	+34	#3820	#509	1314 Ida 1319 Ida	1311 Laura	7-14-41	3-18-24
					+63.5	+61	#1487	#189			6-25-24	5-31-46
					+87	+84.5						
12	104.11	97.88	6.23		+13.5	+11	#148	#471	1304 Ida	1303 Laura	2-20-28	3-13-24
					+41	+38.5	#1843	#398	1302 Ida	1301 R Laura	8-12-24	3-4-24
					+63							
13	104.60	97.98	6.62	13+19.3	+57	+54.5	#965	#639	1248 Ida	1245 Laura	11-17-71	4-1-24
					+83	+80.5	#16064		116.E. Bayley		8-2-74	
14	105.15	98.08	7.07		+08.5	+06	#417	#538	1246 Ida	1248 Laura	3-6-24	3-24-24
					+35.5	+33	#817	#482	1244 Ida	1247 Laura	4-14-24	
					+60	+57.5						
					+86.5	+84						
15	105.53	98.18	7.35	15+30	+11.5	+09	#818	#431	1242 Ida	1243 Laura	8-14-24	8-7-46
					+37.5	+35	#1236		1232 Ida		9-22-22	
					+63.5	+61	#46	#480	1206 Ida	1237 Laura	1-19-28	8-7-46
					+88	+85.5	#1607		1234 Ida		11-25-22	
16	105.88	98.28	7.60		+15	+12.5		#435		1225 Laura		3-7-24
					+41.5	+39		#309		1227 Laura		6-20-46
					+67	+64.5						
					+93	+90.5						
17	106.17	98.38	7.79	17+35.3	+18.5	+16	#365	#320	1220 Ida	1223 Laura	6-2-93 5-4-26	6-21-46
					+45	+42.5		#1015	1214 Ida	1217 Laura	3-4-24	10-27-47
					+70	+67.5						
					+95	+92.5						
18	106.45	98.48	7.97		+21.5	+19	#379	#269	1208 Ida	1211 Ida	11-20-00 3-4-24	1-24-91 4-12-83
					+46.5	+44	#17112	#400	1206 Ida	1207 Laura	11-20-09 5-13-63	3-5-24
					+71	+68.5	#1365	#15			11-28-60	1-6-30
					+96	+93.5						
19	106.45	98.58	7.87	19+43.5	+17	+14.5	#348		1202 Ida		3-3-24	
					+38	+35.5		#1640			12-1-22	

2003-02314-9/4/03-1230 S. Ida - overnight SVC - City Wye repair 49' of MH 17+35.3 (16+86.3) 4" Fred Co - 4" 40 PVC
 Replace entire line - twin co, 2H22
 2003-02714-10/22/03-1346 S Ida - Bob Scott - tied back to claytile, aprx 10' from main - twin co, 4" SCH40
 1/4" fall - 4" wye for future bldg

C 1803 1326 Ida - Donald Thompson 1-20-67 top (10+08.5)

#2289 - Top - 1211 Laura - 9-18-45 - Burgan P/bg. Co. S 7618-4-12-23 - 20 Manning
 #612 - Top - 1111 E. Lincoln - 8-5-48 - Howard Covan - wye app 19+01.5 4" SH40
 #2017 - Top - 1115 E. Bayley - 8-19-50 - Millard - Stigers
 #7075 - Top - 1118 E. Zimmerly - 1-16-52 - Joe McDonald
 #4520 - Top - 1111 E. Lincoln - 3-19-53 - Randall P/bg.
 #3769 - Trailer - 1335 Laura - 3-7-55 - Coleman P/bg.
 #495 - 6" wye - 1344 Ida - Frederick P/bg. - 4-17-56
 #2447 - Trailer - 1330 Ida - Bradie - 9-19-56 - private line connection
 11721 Top (1122 E. Bayley) Frederick 10-28-59 (13+58) Seal off C 28227-7/27/91