


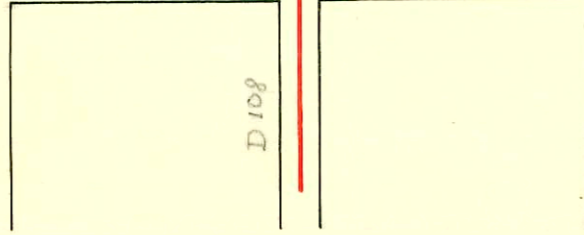
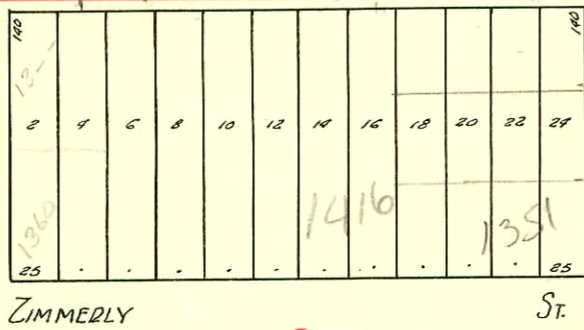


DIST. F-3.5. NO. 20-1920

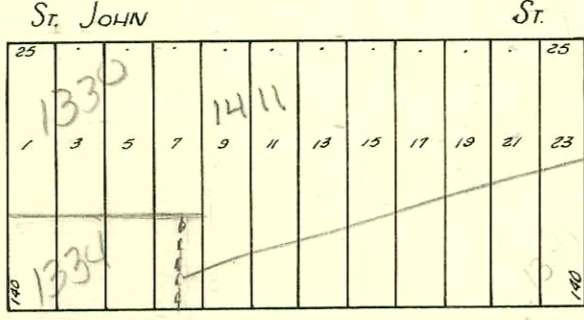

1334 S. LULU  
PRIVATE ESMIT  
E 10' of S 50' of  
LOT 7 granted  
TO 1330 S. LULU  
12/16/02

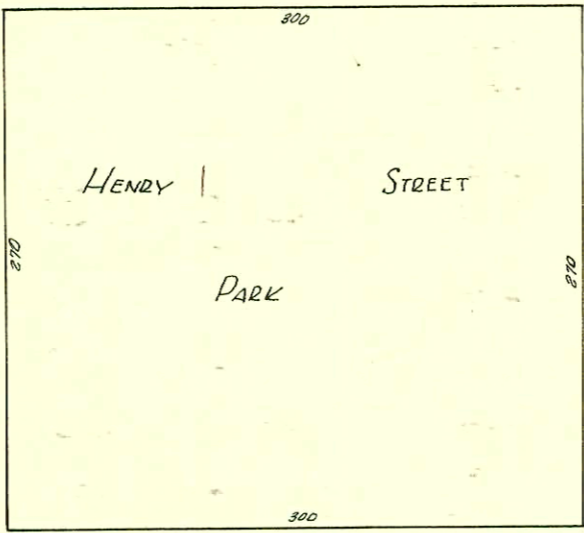

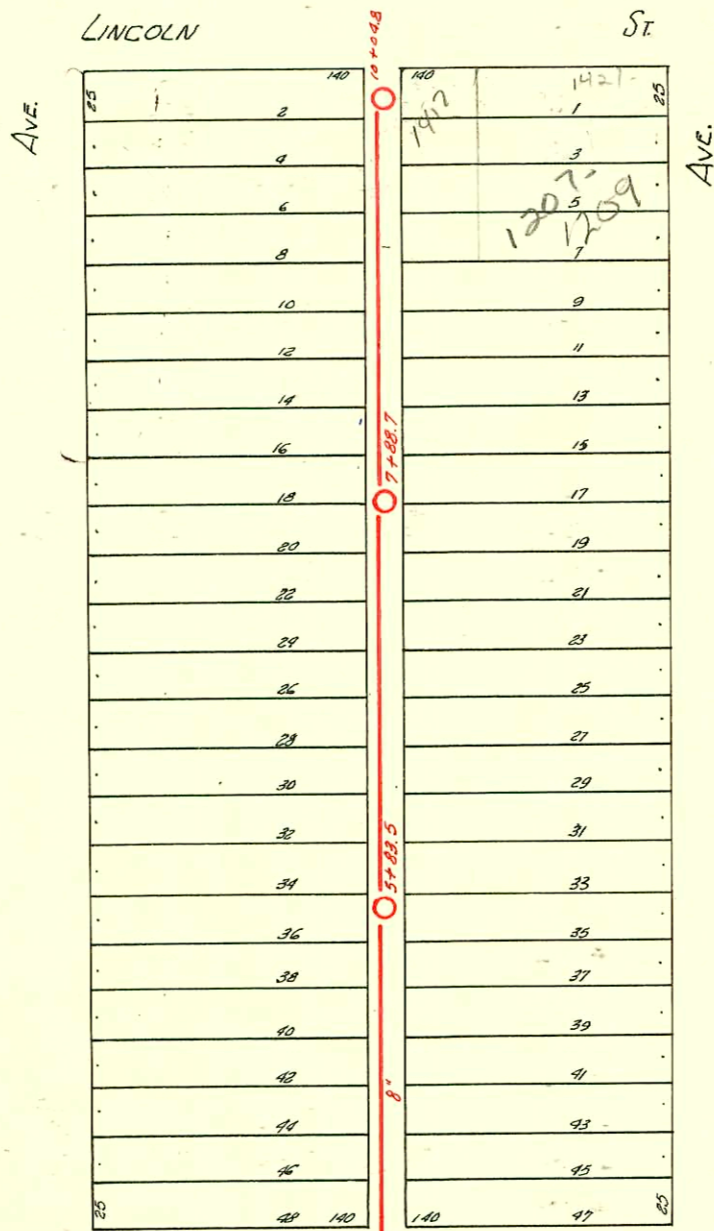