


LAT. R - DIST. C - S.S. NO 20-1920

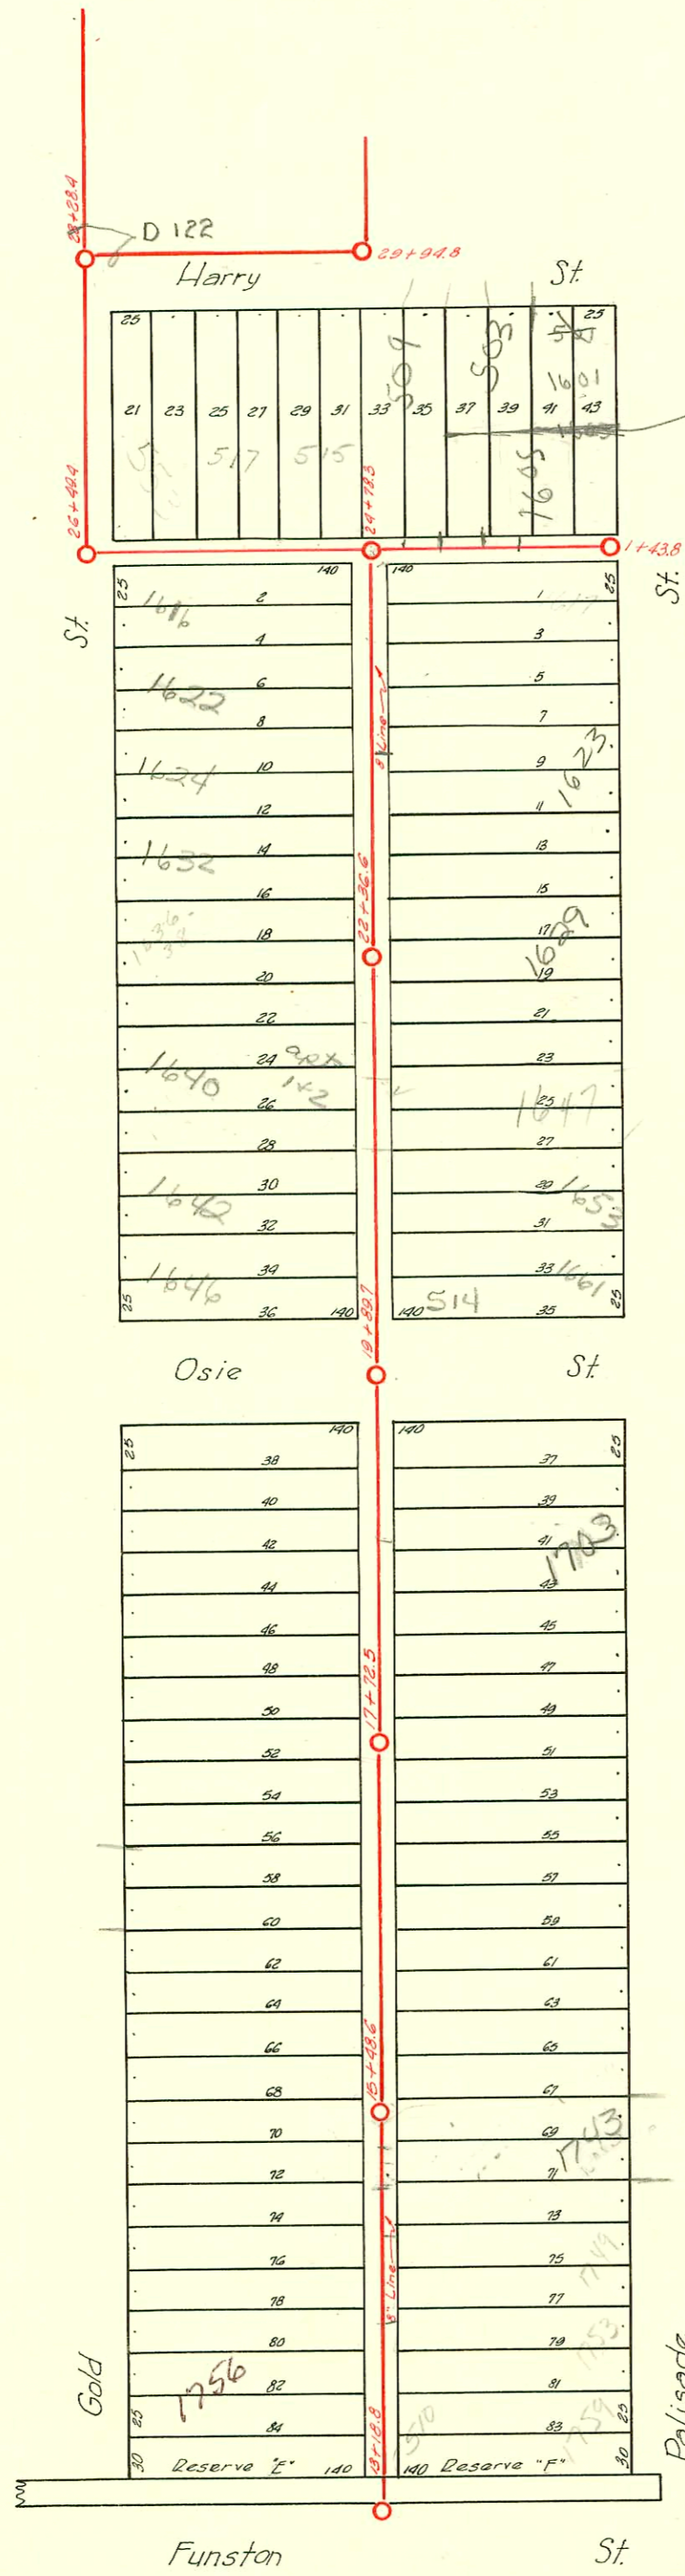

see attd mail

1999-00704-9/17/99-1704 S Gold-Roof Pibg- 4" SCH 40 - Install 4" CO 4" SCH 40

CONSTRUCTION RECORD						SERVICE RECORD						
STATION	ELEVATION		Depth	MANHOLE	4-INCH "Y" BRANCHES		No. of Permit		House Number		DATE OF PERMITS	
	Ground	Grade			North West	South East	North West	South East	North West	South East	North West	South East
					13 +49.5	+47	# 1473		1756 Gold			10-16-29
					13 +85.5	+73				510 W. Funston		2-9-25
14+00	103.42	97.66	5.76		14 +00.5				1732 Gold	1735 Palisade		5-2-49
					+27.7	+25.2	# 155	# 1753				7-30-24
					+52.5	+50						
					+78.7	+76.2						
15+00	103.28	97.72	5.56	486	15 +04.5	15 +02			1739 ?			5-12-24
					15 +22.5	15 +27	# 1077		1733 Palisade	1743 Palisade		12-8-25
					15 +58.5	+55	# 1007	# 1314	1749 Gold	1743 Gold	508 1000	3-16-71
					15 +83	+80.5	# 575		1740 Gold			8-6-29
									1739 Palisade			6-5-30
16+00	103.09	97.78	5.31		16 +03.5	+05	# 6421		1756 Gold			9-11-53
					+34.5	+32				1731 Palisade		9-19-50
					+60	+57.5	P 6039		1730 Gold			7-23-66
					+86.5	+84	# 1038	# 2974	1728 Gold	1717 Palisade		8-12-29
17+00	103.27	97.84	5.43	+72.5	17 +13.3	+11.3	# 2084		1726 Gold			3-6-52
					+37.5	+35				1721 Palisade		6-21-46
					+63.5	+61						
					+89.5	+87	# 1025		1720 Gold			8-8-29
18+00	103.94	97.90	6.04		18 +13	+11.5				1711 Palisade		12-10-24
					+40.5	+38						
					+65.3	+62.8	# 1525	# 416	1706 Gold	1703 R Palisade		9-28-48
19+00	104.03	97.96	6.07	+82.7	18 +92.5	18 +90						10-24-29
					19 +27.5	19 +15	# 2896	# 928	1702 Gold	1701 Palisade		4-3-46
					+43.5	+41						4-23-27
20+00	103.22	98.01	5.21		20 +23.5	20 +21						
					+48.5	+46	# 1314	# 639	1646 Gold	1661 Palisade		8-23-49
					+73.5	+71	# 1313	# 2531	1642 Gold	1640 Palisade		8-23-49
						+99						2-4-46
21+00	104.09	98.07	6.02		+01.5	+						
					+27.5	+25						
					+57	+51.5	# 5727	# 716	1644 Gold	1637 Palisade		8-18-76
					+78.5	+76	# 1343		1650 Gold			9-20-29
22+00	104.15	98.13	6.02	+36.6	22 +05.5	+03				1633 Palisade		5-14-29
					+31	seal off	# 5729	# 1842	1636 Gold	1629 Palisade		5-10-21
					+59.5	+57						8-12-24
					+82.5	+80	# 2530	# 1631	1632 Gold	1621 Palisade		11-21-49
23+00	104.22	98.19	6.03		23 +09.5	+07				1625 Palisade		6-27-27
					+35.5	+33	# 1055		1624 Gold			8-13-29
					+60.9	+58.4	# 353			1623 Palisade		4-30-26
					+85.5	+83	# 2531		1622 Gold			11-21-49
24+00	104.27	98.25	6.02		+13.5	+11				1619 Palisade		9-27-52
					+41.9	+39.4	# 1318	# 33624	1616 Gold	1613 Palisade		12-10-25
					+60	+57.5						6-21-65
					+92.5 N		# 877		515 W. Harry			10-17-27
25+00	104.35	98.31	6.04		+16.5 N							
					+38 N							
					+63 N							
					+86 N		# 2690		553 W. Harry			12-11-24
26+00	104.97	98.37	6.60	+49.4	+11 N							
27+00	104.48	98.44	6.04									
28+00	104.52	98.50	6.02	+28.4								
29+00	105.0±	98.56	6.44	+94.8								
0+00	=24+78.3	98.40	5.87±	0+00	+18 N		# 377		509 W. Harry			5-12-27
					+41 N		11076		509 W. Harry			8-10-59
					+64.5 N		# 1401		507 W. Harry			3-22-39
					+88 N							8-6-24
1+00	104.52	98.60	5.92	+43.8	+14 N		# 1083		1603 Palisade			10-1-25

#6027 - Tap-514 W. Osie-10-4-41-Howard Self  
 #4506 - Tap-1617 Palisade-3-18-53-Joe's Pkg. Co. (seal off house)  
 #4938 - Tap-1702 Gold-5-31-55-J.C. Severs  
 1121 Tap 1708 Gold 7-30-59 Byers Pkg. 18764.7  
 #24935-3-14-50-1743 S. Palisade (New House built using same wye as orig. house which was upset at (-wye 574. #15+27.0))