


DIST. 5-55. NO. 20
1920
SCALE 1"=150'

SAN SEWER EXT TO PT OF RES A HARVEY'S ADDN
BUILT BY: (PVT)
PROJ. N^o 468-76-245-80000-000-000-008
BOOKED 3-11-82 FROM DCD 197

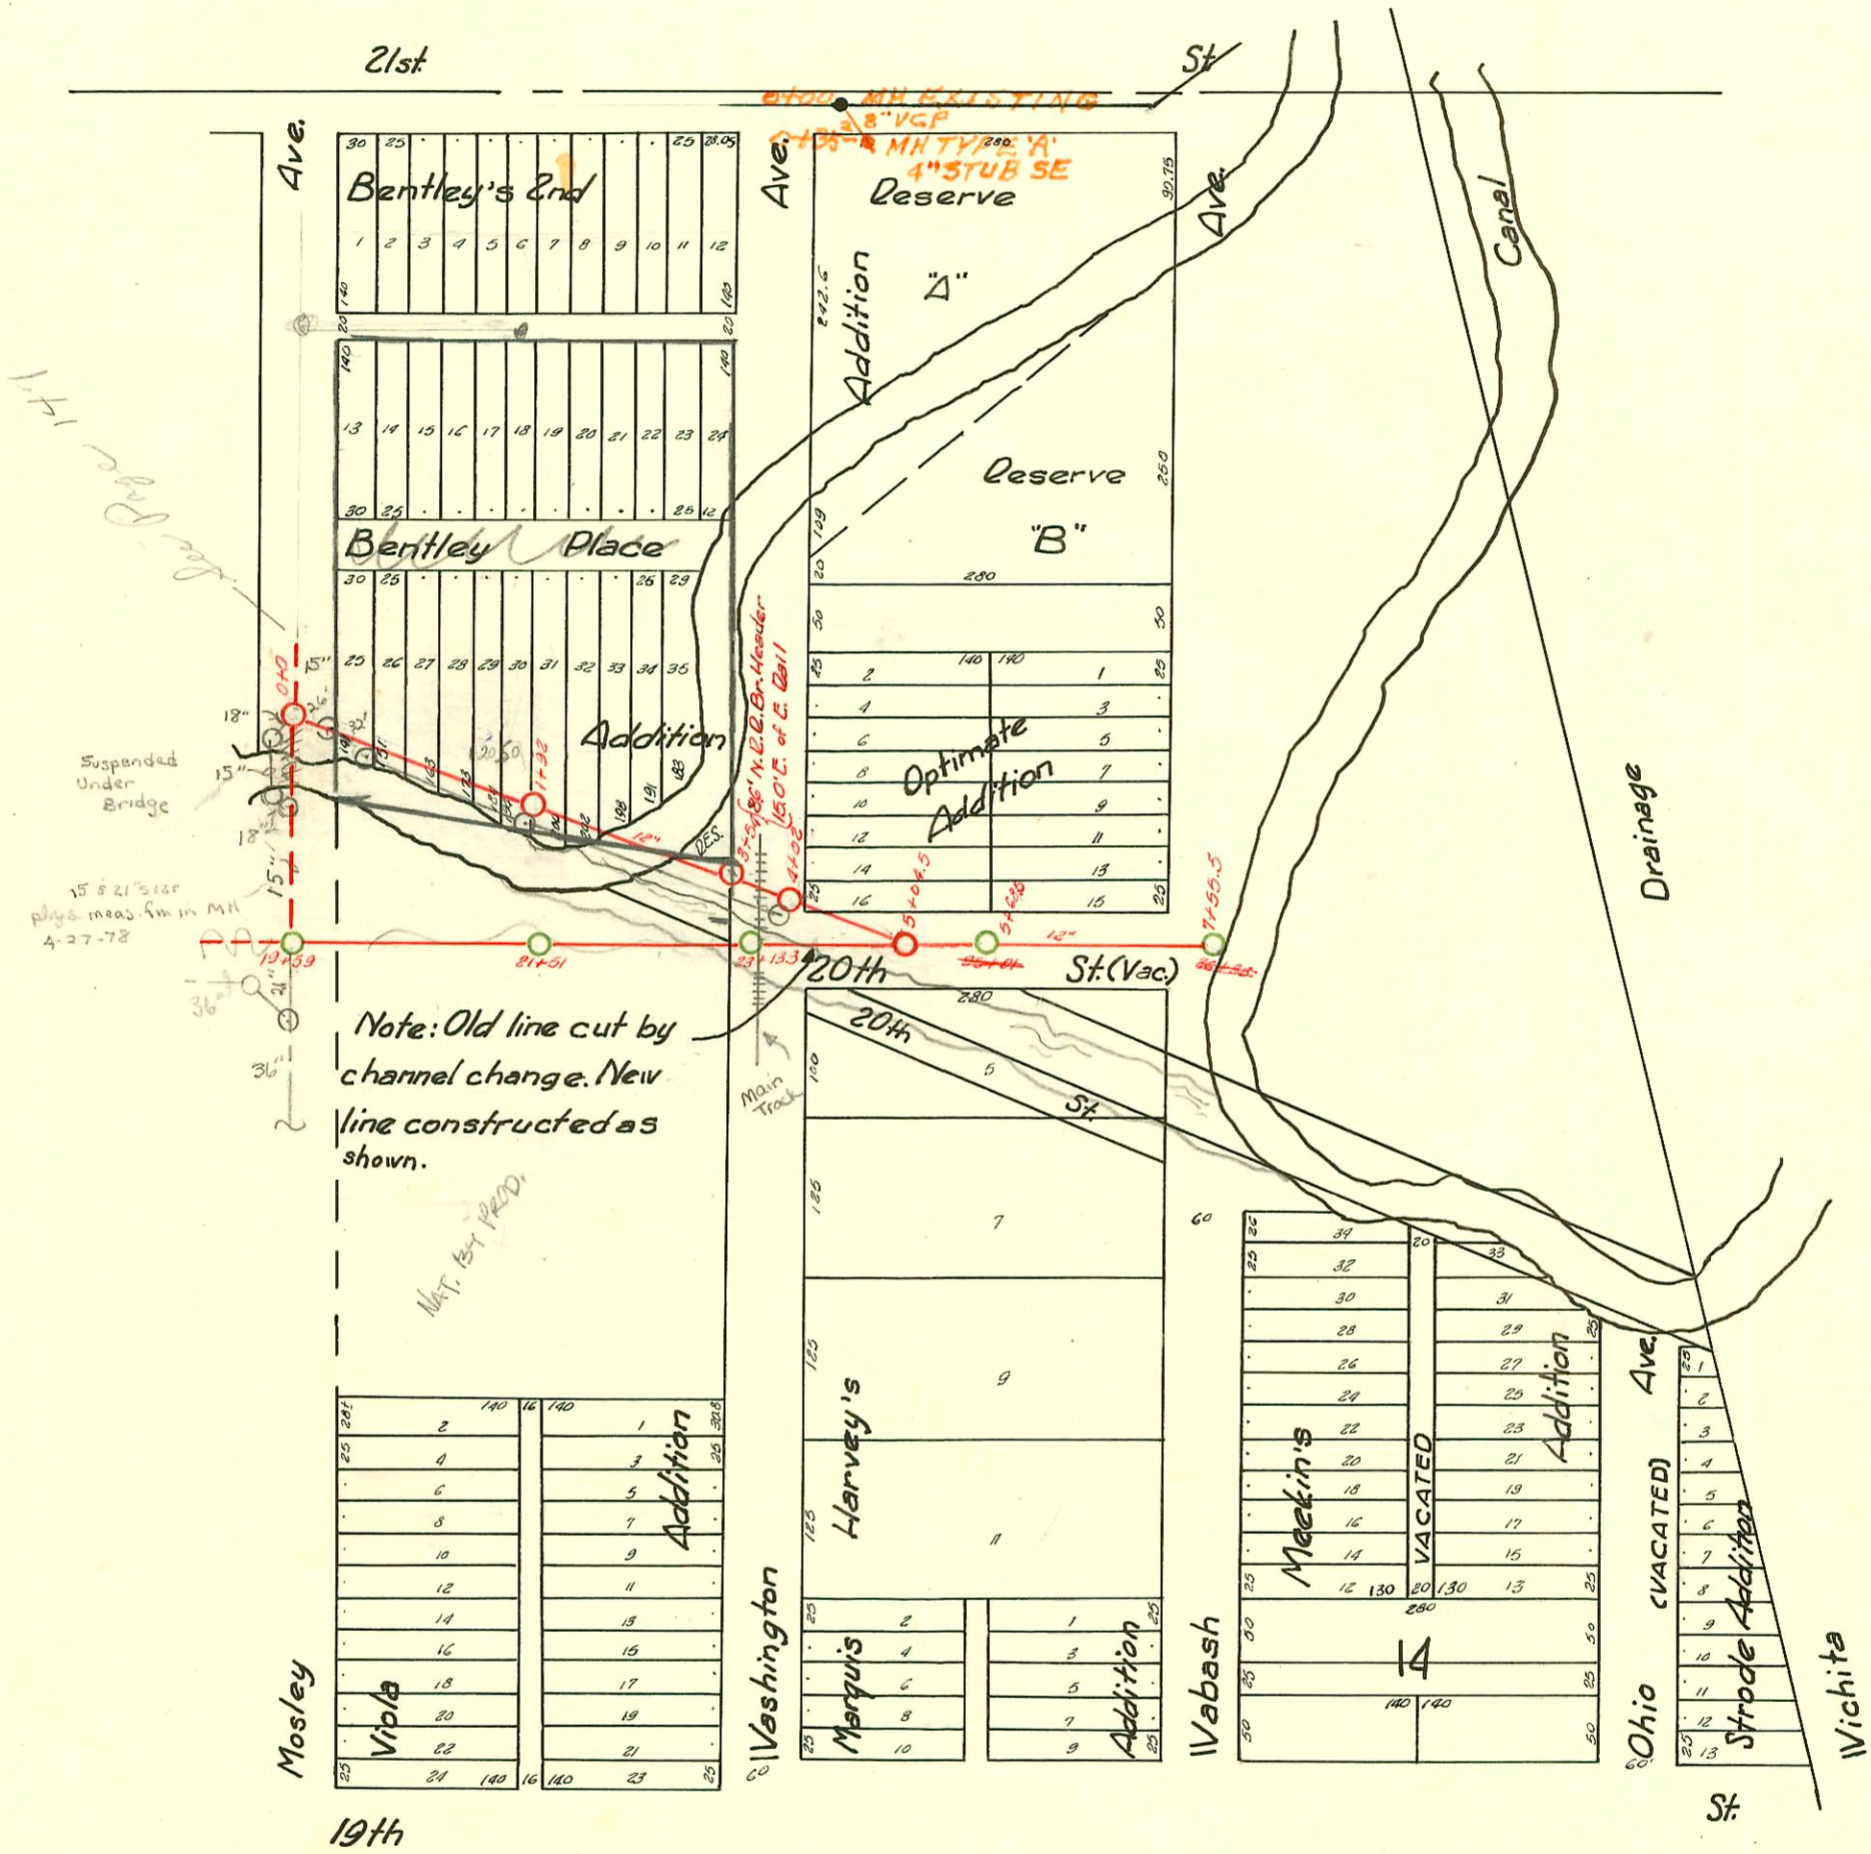

* NOTE Based upon info submitted to office
sewer line drawn in pencil is more accurate

- 96-19345-7 11-19-96 ⁵¹⁰ 2050 N Mosley (small office bldg to be wrecked) - McCullough
- # 615 ⁵¹⁰ 2050 N Mosley 6-24-80 - George Pearson jr. 17920 - 1470 = 45 west
 - # 616 ⁵¹⁰ 2050 N Mosley 6-24-80 - George Pearson jr. 17920 - 1150 = 77 west
 - # 617 ⁵¹⁰ 2050 N Mosley 6-24-80 - George Pearson jr. 17920 - 0780 = 106 west
 - # 618 ⁵¹⁰ 2050 N Mosley 6-24-80 - George Pearson jr. 17920 - 0780 = 111 west

CONSTRUCTION RECORD						SERVICE RECORD						
STATION	ELEVATION		Depth	MANHOLE	4-INCH "Y" BRANCHES		No. of Permit		House Number		DATE OF PERMITS	
	Ground	Grade			North West	South East	North West	South East	North West	South East	North West	South East
19+00	121.85	113.31	8.54									
	121.03	113.87	7.16	+59								
20+00	121.27	113.91	7.36									
21+00	121.35	114.01	7.34	+51								
22+00	121.02	114.11	6.91									
23+00	120.60	114.21	6.39	+13.3								
24+00	120.82	114.31	6.51									
25+00	120.93	114.41	6.52	+01								
26+00	121.10	114.51	6.59	+488								
<p><i>Reported cannot find info on reported line</i></p>												
NATIONAL BY-PRODUCTS SAN SEWER												
0+00	121.2	114.51	6.7	0+00	0+87.5 N6"					2136 N 180-100		
1+00	122.2	114.91	7.3		1+41.3 N6"					311 E 21st St		
	123.5	115.21	8.3	1+75.5		6" STUB S 8" STUB E						
SAN SEWER EXT. TO PT OF RES A HARVEYS ADDN.												
0+00	123.1	116.64	6.4									
	123.0	116.77	6.2	0+35.2		4" STUB SE						
LAT RELOG DISTY SS No 20 (FARM CREDIT BANK)												
0+00	114.1	107.54	6.6	0+00								
1+00	114.6	107.58	7.0					12260	245 N. Wood		10-11-84	
2+00	114.5	107.62	6.9									
3+00	114.7	107.67	7.0									
	115.0	107.67	7.3	3+11.9								
		107.73										
4+00	114.8	108.01	6.8									
	115.9	108.18	7.7	4+55.6								
				0+0	MH Tap			c63726	2050 N. Mosley		11-9-77	
				1+9.2	MH Tap			c63725	2050 N. Mosley		11-9-77	

897-Tap-914 Bentley-10-20-27-F. X. Hoff
 # 682-Tap-911 Bentley-8-29-47-Carl McKee
 # 683-Private Line-911 Bentley-Earl McKee-8-29-47
 # 1741-Tap-211 East 21st-12-16-48-Calhoun Pkg. Co. 4-20-76 211 Kenney 54887
 # 11361 Tap-2050 N. Mosley - Rev Robertson 8-31-59 (2+86) 94' east of 0+0
 # C 3215 Tap-2050 N. Mosley - (addr) - Bill Bradford - 5-23-67 (2+22)