


DIST. I
S.S. NO. 20
1922

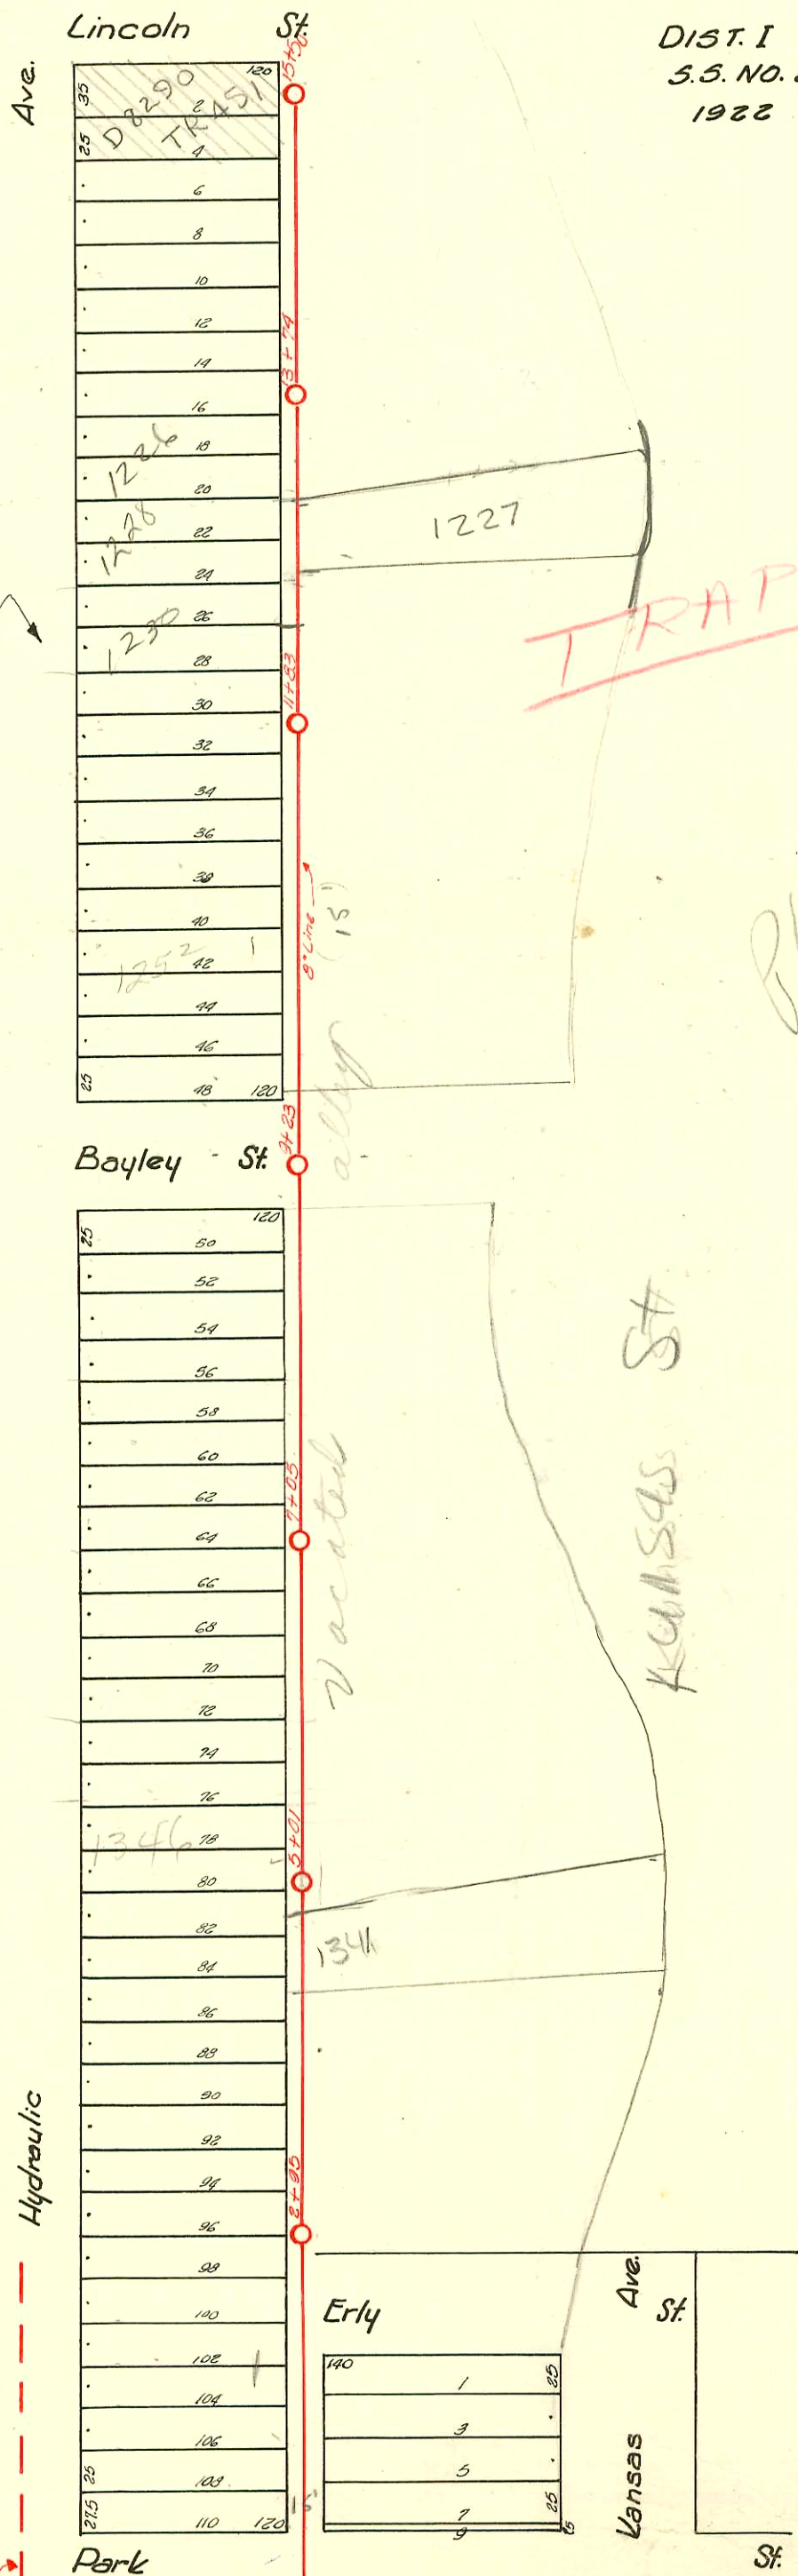

2-14-21 - There are two (2) lines in alley East of Hydraulic between Lincoln & Boyley. One has been abandoned.

ally (15')

vacated

KANSAS ST.

Sta. 0+79 from bk. of Walk South and 127.5 ft. E. of E. P. L. of Hydraulic.

183'

D-151

CONSTRUCTION RECORD							SERVICE RECORD					
STATION	ELEVATION		Depth	MANHOLE	4-INCH "Y" BRANCHES		No. of Permit		House Number		DATE OF PERMITS	
	Ground	Grade			North West	South East	North West	South East	North West	South East	North West	South East
M.H. in Hyd.	102.36	96.56	5.80	0+78	1+37	1+34.5	# 86	# 714	1406 Hydraulic	1375 Kansas	1-31-24	9-25-46
0+78	102.44	96.77	5.67		+62.5	+60						
1+0	102.67	96.87	5.80		+87.8	+85.3						
2+0	102.91	96.97	5.94		2+13	2+10.5	# 7		1402 Hydraulic	1367 Kansas	1-8-24	
					+38.5	+36		# 1263				12-13-38
					+63	+60.5						
3+0	103.56	97.07	6.49	2+95	+87.5	+85	# 1577		1362 Hydraulic	1361 Kansas	5-18-39	
					3+12.9	3+10.4	# 1353	# 530	1356 Hydraulic		9-13-23	11-6-41
					+37.5	+35						
					+631	+606	# 62	# 1262	1352 Hydraulic	1353 Kansas	1-13-23	12-13-38
4+0	103.87	97.17	6.70		+89.2	+86.7	# 554	# 760	1350 S. Hydraulic	1347 Kansas	4-17-23	12-9-41
					4+13.9	4+11.4						
					+38.5	+36						
					+63.5	+61	# 890	# 1261	1348 Hydraulic	1341 Kansas	6-13-23	12-13-38
5+0	104.61	97.27	7.34	5+01	+89.2	+86.7	# 995	# 216	1335 Hydraulic	1335 Kansas		9-26-41
					5+13.5	5+11					7-7-23	
					+37.5	+35						
					+63.5	+61	# 1269	# 1230	1332 Hydraulic	1327 Kansas	9-27-23	11-29-38
6+0	105.21	97.37	7.84		+88.5	+86	# 840		1326 Hydraulic			
					6+13.5	6+11					6-8-23	
					138.9	+36.4						
					+64	+61.5	# 1297		1324 Hydraulic		8-31-23	
7+0	105.86	97.47	8.37	7+00	+88.5	+86	# 943	# 1245	1313 Hydraulic	1315 Kansas	6-25-23	12-6-38
					7+13.5	7+11						
					+38.8	+36.3						
					+63.5	+61		# 1963		1309 Kansas		
8+0	105.98	97.57	8.41		+89.5	+87	# 1366		1312 Hydraulic			
					8+14.5	8+12						
					+40.5	+38	# 703		1304 Hydraulic	1301 Kansas	5-9-23	
					+66.5	+64	# 702	# 3101	1302 Hydraulic	1301 Kansas	5-9-23	2-6-41
9+0	106.41	97.67	8.74	9+23	+91.1	+88.6	# 1461		1256 Hydraulic		10-4-23	
					9+24.6	9+22.1		# 3075		1720 E. Bayley		1-24-31
10+0	106.97	97.77	9.20		+90	+87.5						
					10+16	10+13.5						
					+41.4	+38.9	# 323	# 4100	1248 Hydraulic	1251 Kansas	8-17-36	8-19-41
					+68	+65.5						
11+0	108.76	97.87	10.89		+93.3	+90.8	# 232	# 3080	1242 Hydraulic	1245 Kansas	5-18-37	1-29-41
					11+18	11+15.5						
					+436	+41.1						
				11+83	+69.6	+67.1	# 28		1238 Hydraulic		2-4-25	
					+89.5	+87		# 1313		1237 Kansas		3-27-42
12+0	106.66	97.97	8.69		12+16	12+13.5						
					+41	+38.6	# 1587	# 1840	1030 S. Hyd.	1233 Kansas	10-29-23	3-21-42
					+65.5	+63	# 1634		1223 Hydraulic		11-7-23	
					+90.5	+88		# 1103		1223 Kansas		3-9-42
13+0	106.04	98.07	7.97		13+15.5	13+13	# 1658		1226 Hydraulic		11-13-23	
					441.5	+39		# 7102		1219 Kansas		3-3-42
				13+74	+66.5	+64	# 820		1214 Hydraulic		4-15-24	
					+91.5	+89						
14+0	105.48	98.17	7.31		14+17.2	14+14.7	# 1670	# 1964	1210 Hydraulic	1210 Kansas	11-13-23	11-8-39
					+42.1	+39.6		# 1057		1209 Kansas		2-13-42
					+67.5	+65						
					+92.5	+90	# 1611		1204 Hydraulic	1201 Kansas	11-2-23	
15+0	104.26	98.27	5.99		15+18	15+15.5	# 2368	# 773	1202 Lincoln	1201 Kansas	9-13-20	12-15-41
15+50	103.91	98.32	5.59	15+50	+47.5	+45	# 413		1202 Hydraulic		3-26-23	

395 - Tap - 1252 S. Hydraulic - 9-29-36 - F.R. Hayes Pkg. Co.
 # 397 - Tap at G+31-1321 S. Kansas - 5-1-41 - Horley Diggins
 # 4243 - Tap - 1375 S. Kansas - 3-31-51 - Kendall Pkg. Co.


CONSTRUCTION RECORD

SERVICE RECORD

STATION	ELEVATION		Depth	MANHOLE	4-INCH "Y" BRANCHES		No. of Permit		House Number		DATE OF PERMITS	
	Ground	Grade			North West	South East	North West	South East	North West	South East	North West	South East
M.H. in Hyd.	102.36	96.56	5.80	0+78	1+37	1+34.5	# 86	# 714	1302 Hydraulic	1375 Kansas	1-31-24	9-25-46
0+78	102.44	96.77	5.67		+62.5	+60						
1+0	102.67	96.87	5.80		+87.8	+85.3						
2+0	102.91	96.97	5.94		2+13	2+10.5	# 7		1402 Hydraulic		1-8-24	
					+38.5	+36		# 1263	1367 Kansas			12-13-38
					+63	+60.5						
3+0	103.56	97.07	6.49	2+95	+87.5	+85	# 1577		1362 Hydraulic	1361 Kansas	5-18-39	
					3+12.9	3+10.4	# 1353	# 530	1356 Hydraulic		9-13-23	11-6-41
					+37.5	+35						
					+631	+606	# 63	# 1262	1352 Hydraulic	1353 S. Kansas	1-13-23	12-13-38
					+89.2	+86.7						
4+0	103.87	97.17	6.70		4+13.9	4+11.4	# 554	# 760	1350 S. Hydraulic	1347 Kansas	4-17-23	12-9-41
					+38.5	+36	# 890	# 216	1348 Hydraulic	1341 R. Greenstpg Kansas	6-13-23	2-18-43
					+63.5	+61	# 216		1355 R. Kansas		8-27-41	9-26-41
					+89.2	+86.7	# 995		1328 Hydraulic		7-7-23	
5+0	104.61	97.27	7.34	5+01	5+13.5	5+11	# 1269	# 1230	1352 Hydraulic	1327 Kansas	8-27-23	11-29-38
					+37.5	+35						
					+63.5	+61	# 840		1326 Hydraulic		6-2-23	
					+88.5	+86	# 1297		1324 Hydraulic		3-31-23	
6+0	105.21	97.37	7.84		6+13.5	6+11	# 943	# 1245	1313 Hydraulic	1315 Kansas	6-25-23	12-6-38
					+38.8	+36.4						
					+64	+61.5	# 16067	# 1963	1312 Hydraulic	1309 Kansas	4-7-26	
					+88.5	+86	# 1366					
8+0	105.93	97.57	8.41		8+14.5	8+12	# 103		1304 Hydraulic	1301 Kansas	5-9-23	
					+40.5	+38	# 702	# 3101	1303 Hydraulic		5-9-23	2-6-41
					+66.5	+64	# 1461		1256 Hydraulic		10-4-23	
					+91.1	+88.6	# 3075		1720 E. Bayley			1-24-31
9+0	106.41	97.67	8.74	9+23	9+14.6	9+13.1	# 323	# 4100	1343 Hydraulic	1301 Kansas	8-17-36	8-19-41
					+90	+87.5						
10+0	106.97	97.77	9.20		10+16	10+13.5	# 232	# 3080	1242 Hydraulic	1245 Kansas	5-18-37	1-28-41
					+41.4	+38.9	# 28		1238 Hydraulic	1237 Kansas	2-4-25	
					+68	+65.5	# 1313					3-27-42
					+93.3	+90.8						
11+0	108.76	97.87	10.89	11+83	11+18	11+15.5	# 1587	# 1240	1090 S. Hyd.	1233 Kansas	10-29-23	3-21-42
					+436	+41.1	# 1634		1223 Hydraulic		11-7-23	
					+69.6	+67.1	# 1103		1233 Hydraulic	1231 Kansas	11-13-23	3-3-42
					+89.5	+87	# 1102		1219 Hydraulic	1218 Kansas	4-15-24	3-3-42
12+0	106.66	97.97	8.69		12+16	12+13.5	# 920		1214 Hydraulic			
					+41	+38.6	# 1670	# 1964	1210 Hydraulic	1210 Kansas	11-13-23	11-8-39
					+65.5	+63	# 1057	# 2373	1209 Kansas		2-13-42	
					+90.5	+88						
13+0	106.04	98.07	7.97	13+74	13+15.5	13+13	# 1611	# 23838	1204 Hydraulic	1201 Kansas	11-2-23	11-6-41
					+41.5	+39	# 2363	# 773	1202 Hydraulic		9-13-23	12-15-41
					+66.5	+64	# 413		1202 Hydraulic		3-26-23	
					+91.5	+89	# 4135				9-5-73	
14+0	105.48	98.17	7.31		14+17.2	14+14.7						
					+42.1	+39.6						
					+67.5	+65						
					+92.5	+90						
15+0	104.26	98.27	5.99		15+18	15+15.5						
15+60	103.91	98.32	5.59	15+50	+47.5	+45						

395-1sp-12525 Hydraulic - 9-29-36-T.P. Hayes Pkg. Co.
 # 3907-1sp at 6+31-13213 Kansas - 5-1-41-Honay Riggs
 # 1243-1sp-13755 Kansas - 3-31-51-Kendall Pkg. Co.

D-151B

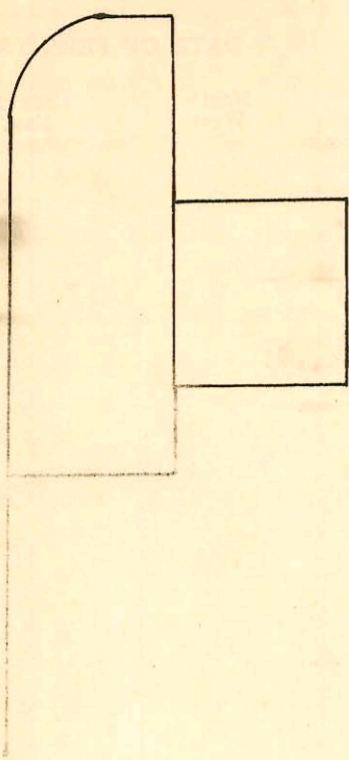

2003-00424 2118103 1841 S Kansas - Always Plug - City Wye repair 65.9' 50' MH 5101(4735.0)
4"40PVC, 2TWINCO, 1H22, 1H45, shallow

SWR2002-00368 2112102 1227 S Kansas Redd. Rootr - 2 Fernco, 1H45, 1TWINCO, 4"40 PVC

