


Do not issue any permits to connect to this sewer without OK. from Wilton or Penner  
12-15-70

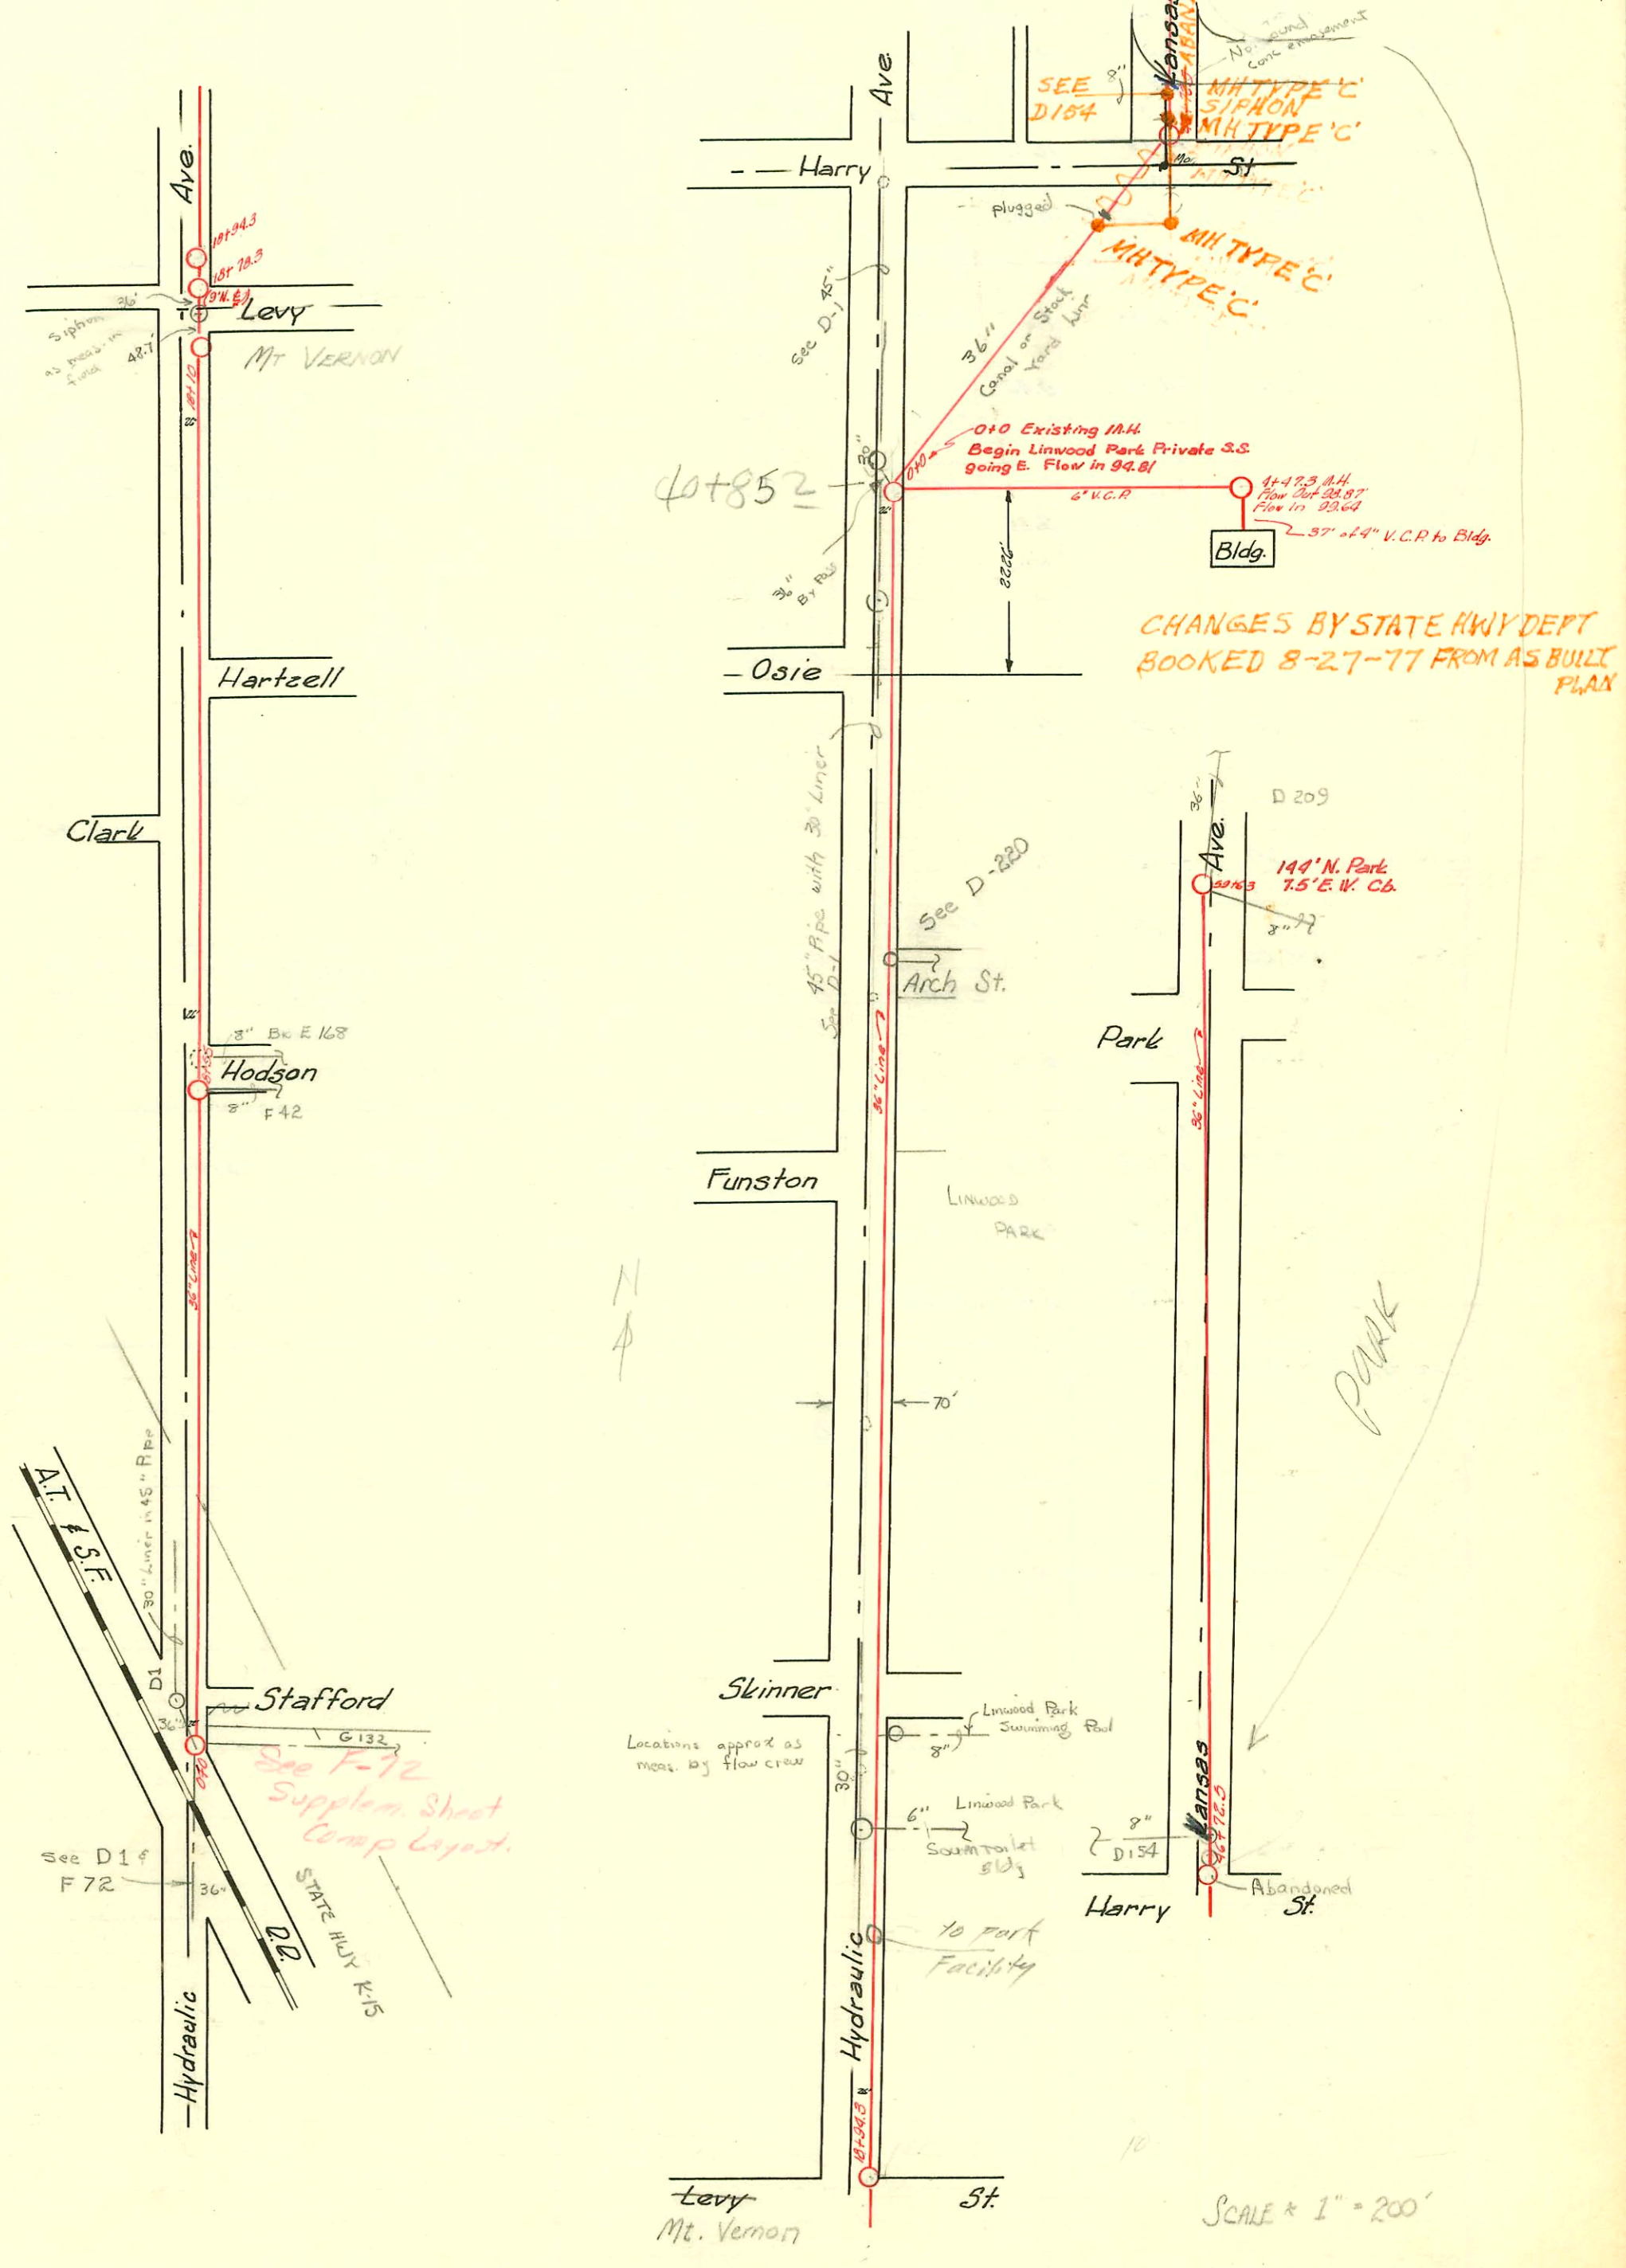

CHANGES BY STATE HWY DEPT  
BOOKED 8-27-77 FROM AS BUILT  
PLAN

SCALE \* 1" = 200'

D-208

CONSTRUCTION RECORD						SERVICE RECORD						
STATION	ELEVATION		Depth	MANHOLE	4-INCH "Y" BRANCHES		No. of Permit		House Number		DATE OF PERMITS	
	Ground	Grade			North West	South East	North West	South East	North West	South East	North West	South East
0+0	97.80	86.34	11.46									
1+0	98.05	86.48	11.63									
2+0	97.65	86.50	11.15									
3+0	97.65	86.58	11.07									
4+0	97.60	86.66	10.94									
5+0	97.50	86.74	10.76									
6+0	97.70	86.82	10.88									
7+0	97.85	86.90	10.95									
8+0	97.70	86.98	10.72									
		87.02		8+55								
9+0	98.11	87.06	11.05									
10+0	97.61	87.12	10.97									
11+0	97.36	87.22	10.14									
12+0	97.36	87.30	10.06									
13+0	97.36	87.38	9.98									
14+0	97.46	87.46	10.00									
15+0	97.81	87.54	10.27									
16+0	97.86	87.62	10.24									
17+0	97.76	87.70	10.06									
18+0	97.92	87.78	10.14									
		87.79		18+10								
				18+78.3								
				18+94.3								
19+0	98.47	87.86	10.61									
20+0	98.66	87.94	10.72									
21+0	99.46	88.02	11.44									
22+0	99.36	88.10	11.36									
23+0	99.26	88.18	11.08									
24+0	99.46	88.26	11.20									
25+0	99.36	88.34	11.02									
26+0	99.36	88.42	10.94									
27+0	99.68	88.50	11.18									
28+0	99.98	88.58	11.40									
29+0	100.38	88.66	11.72									
30+0	100.38	88.74	11.64									
31+0	101.38	88.82	12.56									
32+0	100.88	88.90	11.98									
33+0	99.58	88.98	10.60									
34+0	99.28	89.06	10.82									
35+0	99.48	89.14	10.34									
36+0	99.58	89.22	10.36									
37+0	99.67	89.30	10.37			37+55						
38+0	99.67	89.38	10.29									
39+0	99.67	89.46	10.21									
40+0	99.97	89.54	10.43									
		89.61		40+85.2								
41+0	99.78	89.62	10.16									
42+0	98.98	89.70	9.28									
43+0	99.38	89.78	9.60									
44+0	100.98	89.86	11.12									
45+0	101.28	89.94	11.34									
46+0	100.38	90.02	10.36									
		90.08		46+72.5								
47+0	100.39	90.12	10.27									
48+0	100.99	90.20	10.79									
49+0	101.19	90.28	10.91									
50+0	101.19	90.36	10.83									
51+0	101.19	90.44	10.75									
52+0	101.39	90.52	10.87									
53+0	101.49	90.60	10.89									
54+0	101.59	90.68	10.91									
55+0	102.12	90.76	11.36									
56+0	102.02	90.84	11.18									
57+0	102.32	90.92	11.40									
58+0	102.92	91.00	11.92									
59+0	102.72	91.08	11.64									
		91.13		59+63								

C12305-1901 S. Kansas - Community Center Bldg. - 6-12-79 - 11 ft. on swimming pool line (11.6 EAST OF M.H.)

1999-01480 #563-1602 S. Hydraulic (Greenhouse) 12-31-31 - Wichita Exc - 4" SCH 40 Tied to MH 1-6x4 WVE - CO every 100'