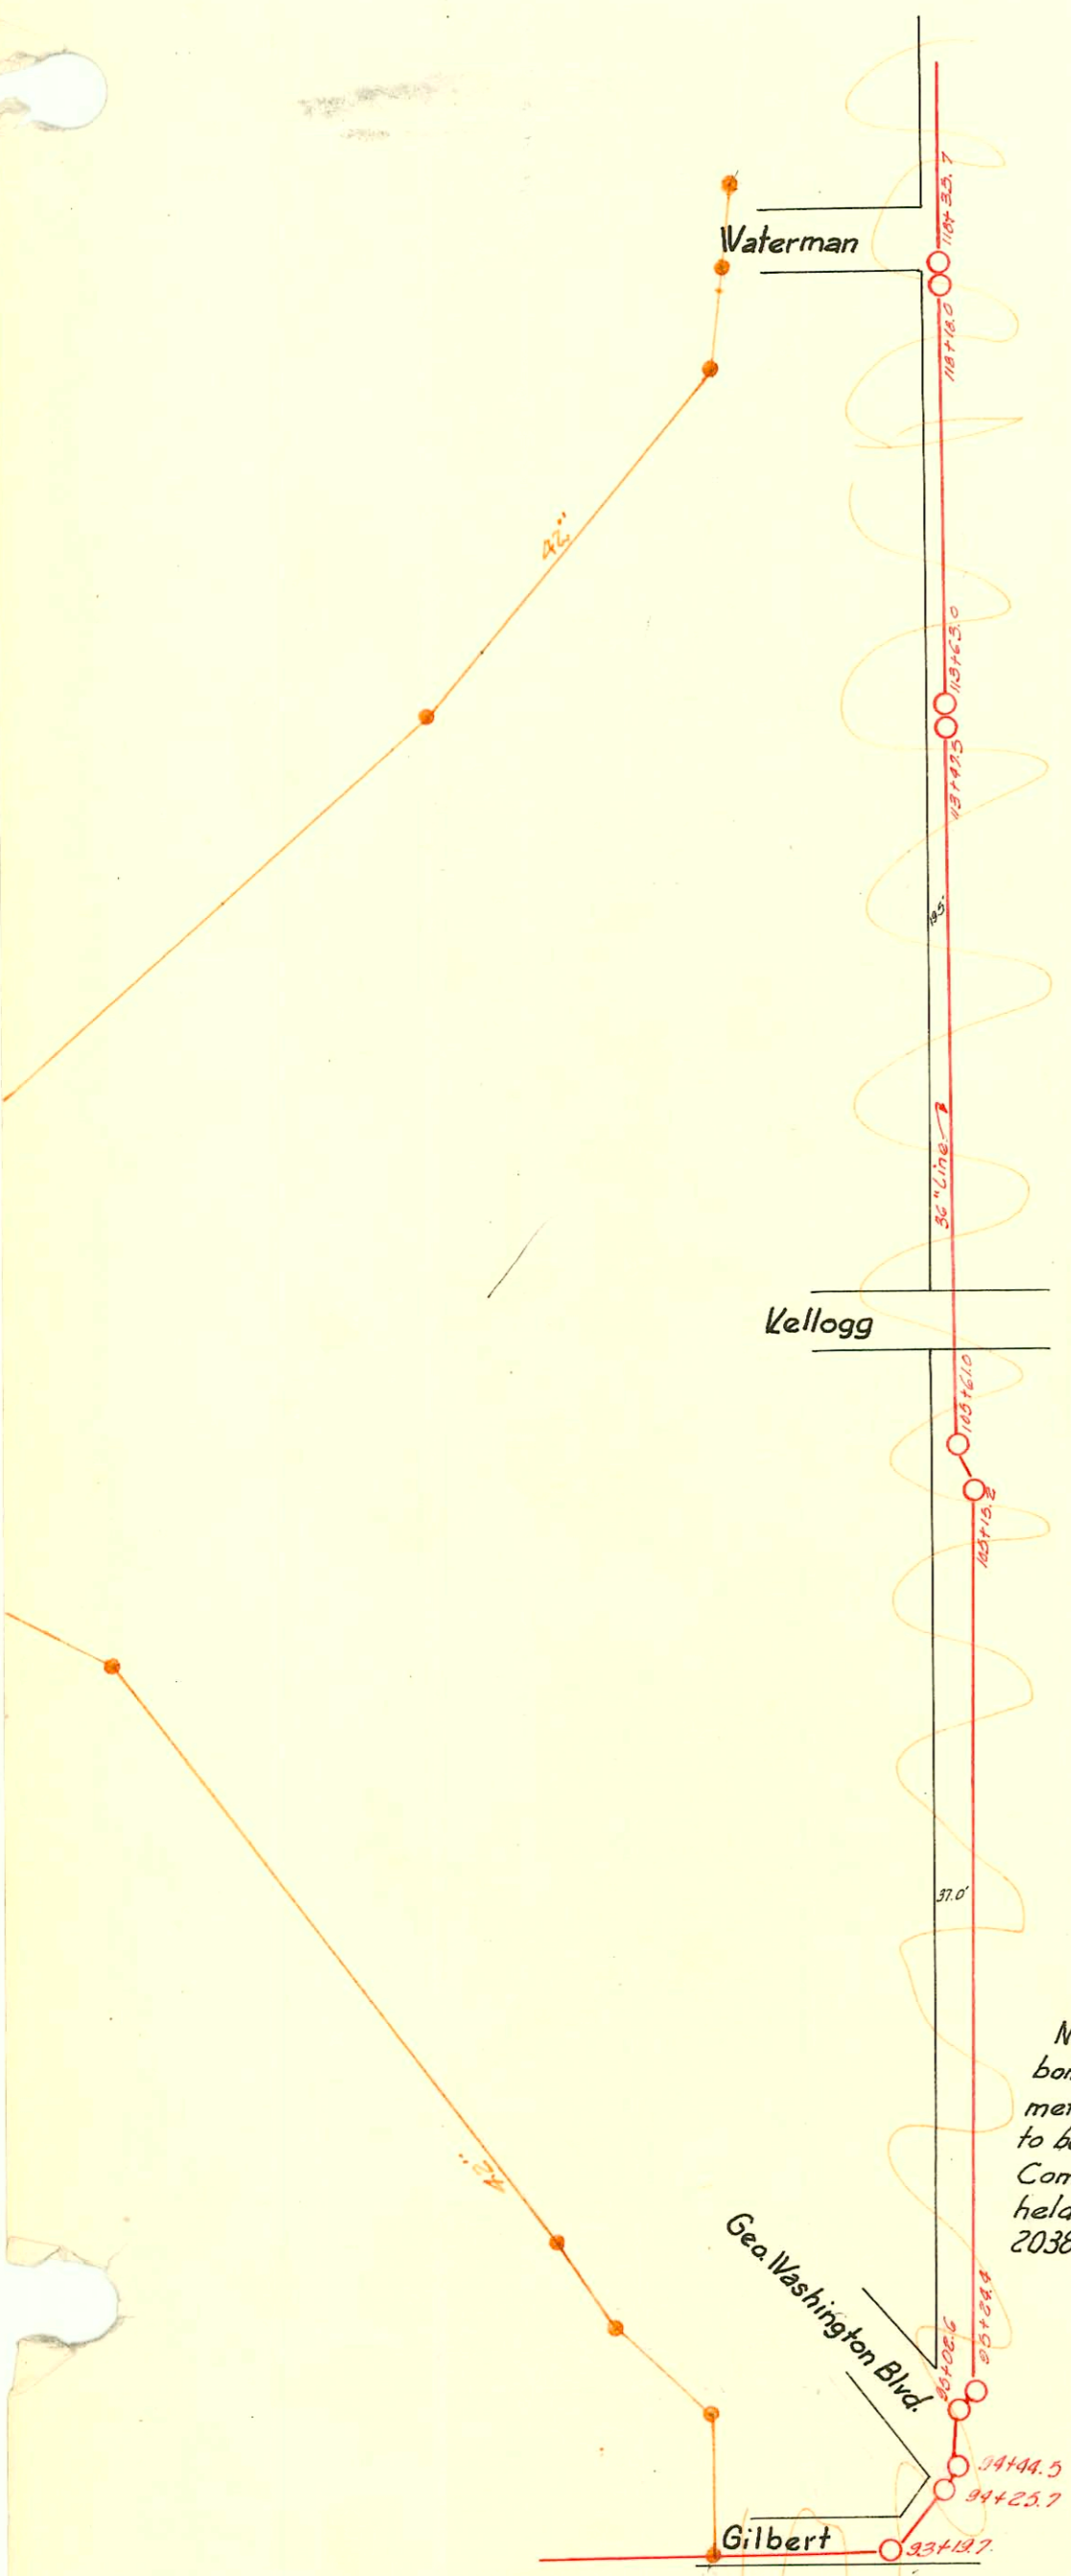
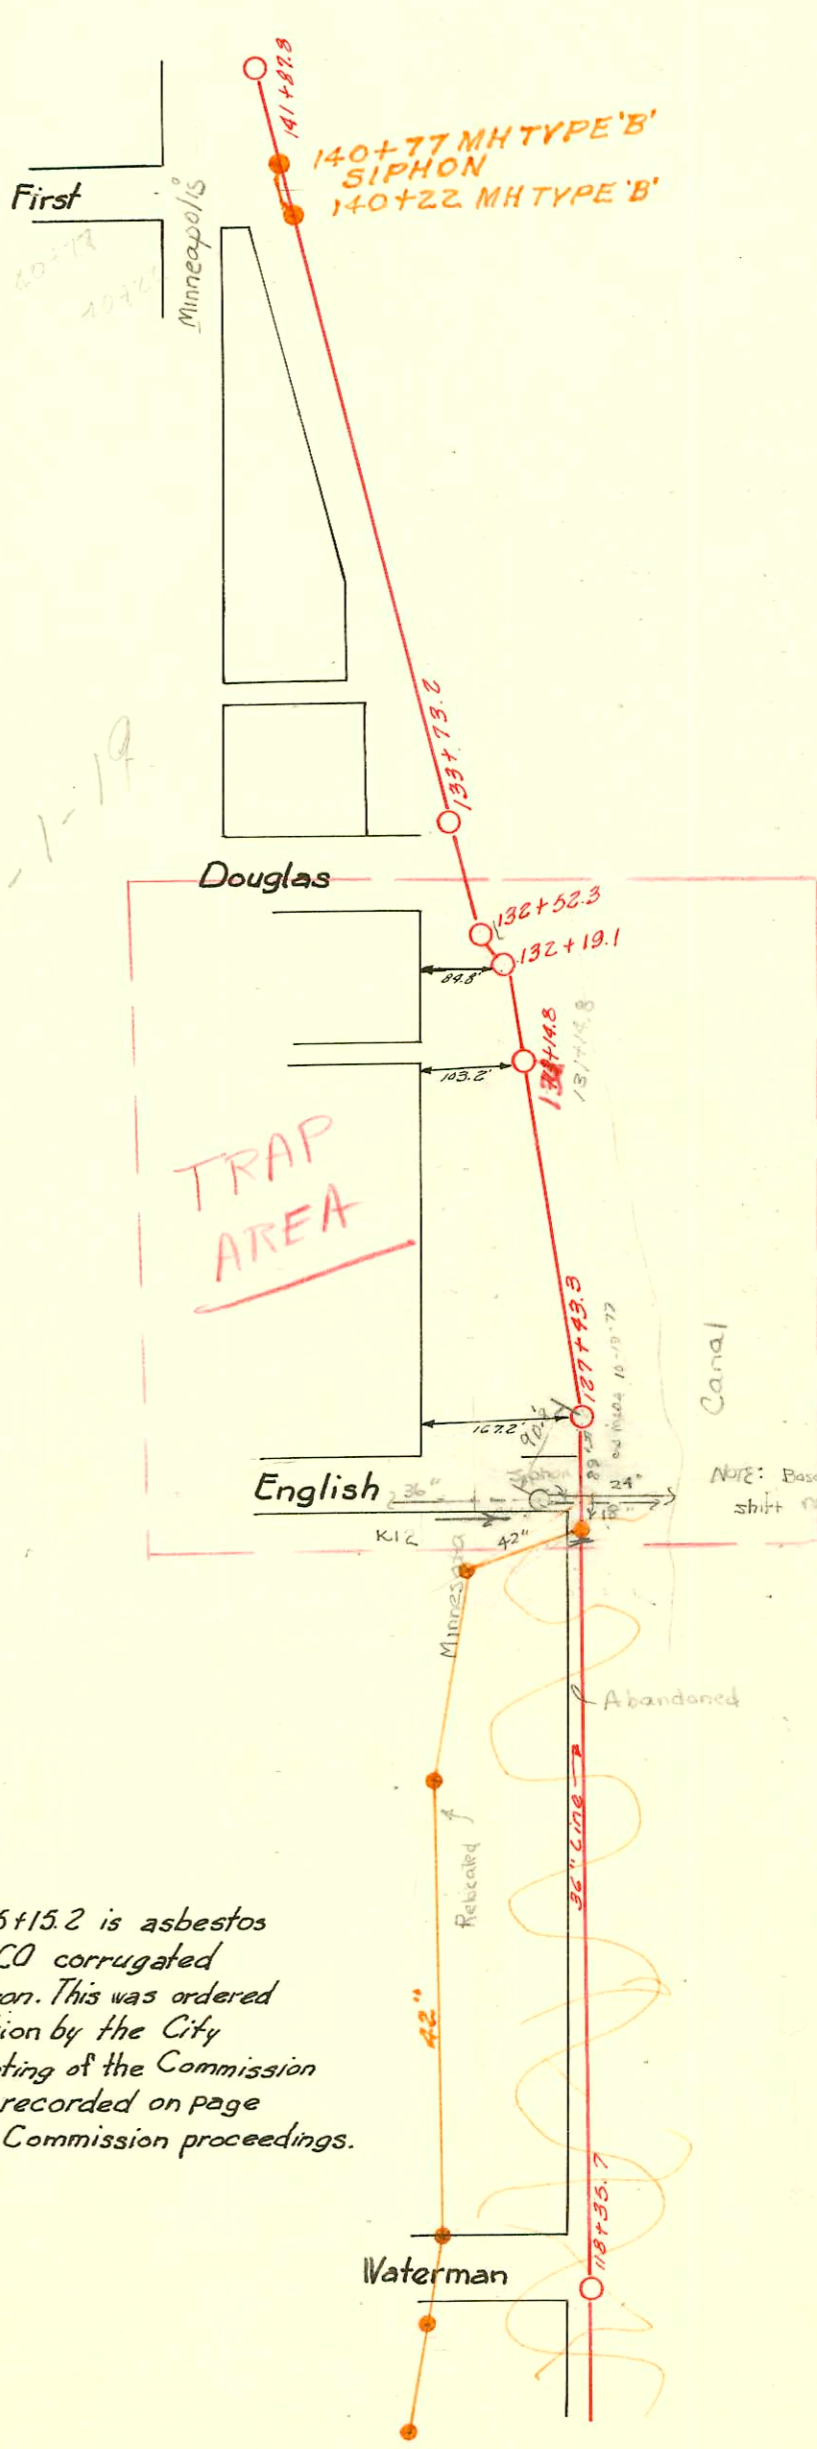

 SCALE 1"=200'

RELOCATION OF PART OF SS N^o20
 MADE BY STATE HIGHWAY DEPT.
 PROJ. N^o 35W-87 I 35W-1 (33) 46
 BOOKED 5-9 -78 FROM AC PLANS



5
#20
Plan 6-12-1-19



Note: Sta. 95+24.4 to Sta. 105+15.2 is asbestos bonded, paved invert AR/MCO corrugated metal pipe 12 gage ingot iron. This was ordered to be installed as a test section by the City Commission at a regular meeting of the Commission held on October 3, 1938 and recorded on page 2038 of Journal "Y" of the Commission proceedings.

1" = 200'

