


1 = 200

Sewer Rehab & Mosley Relief Sewer
 Dist 1 & 20, North of Douglas
 468-80-990-80271-000-001
 Built By Stannard Const
 Booked 8-8-85 From As Built

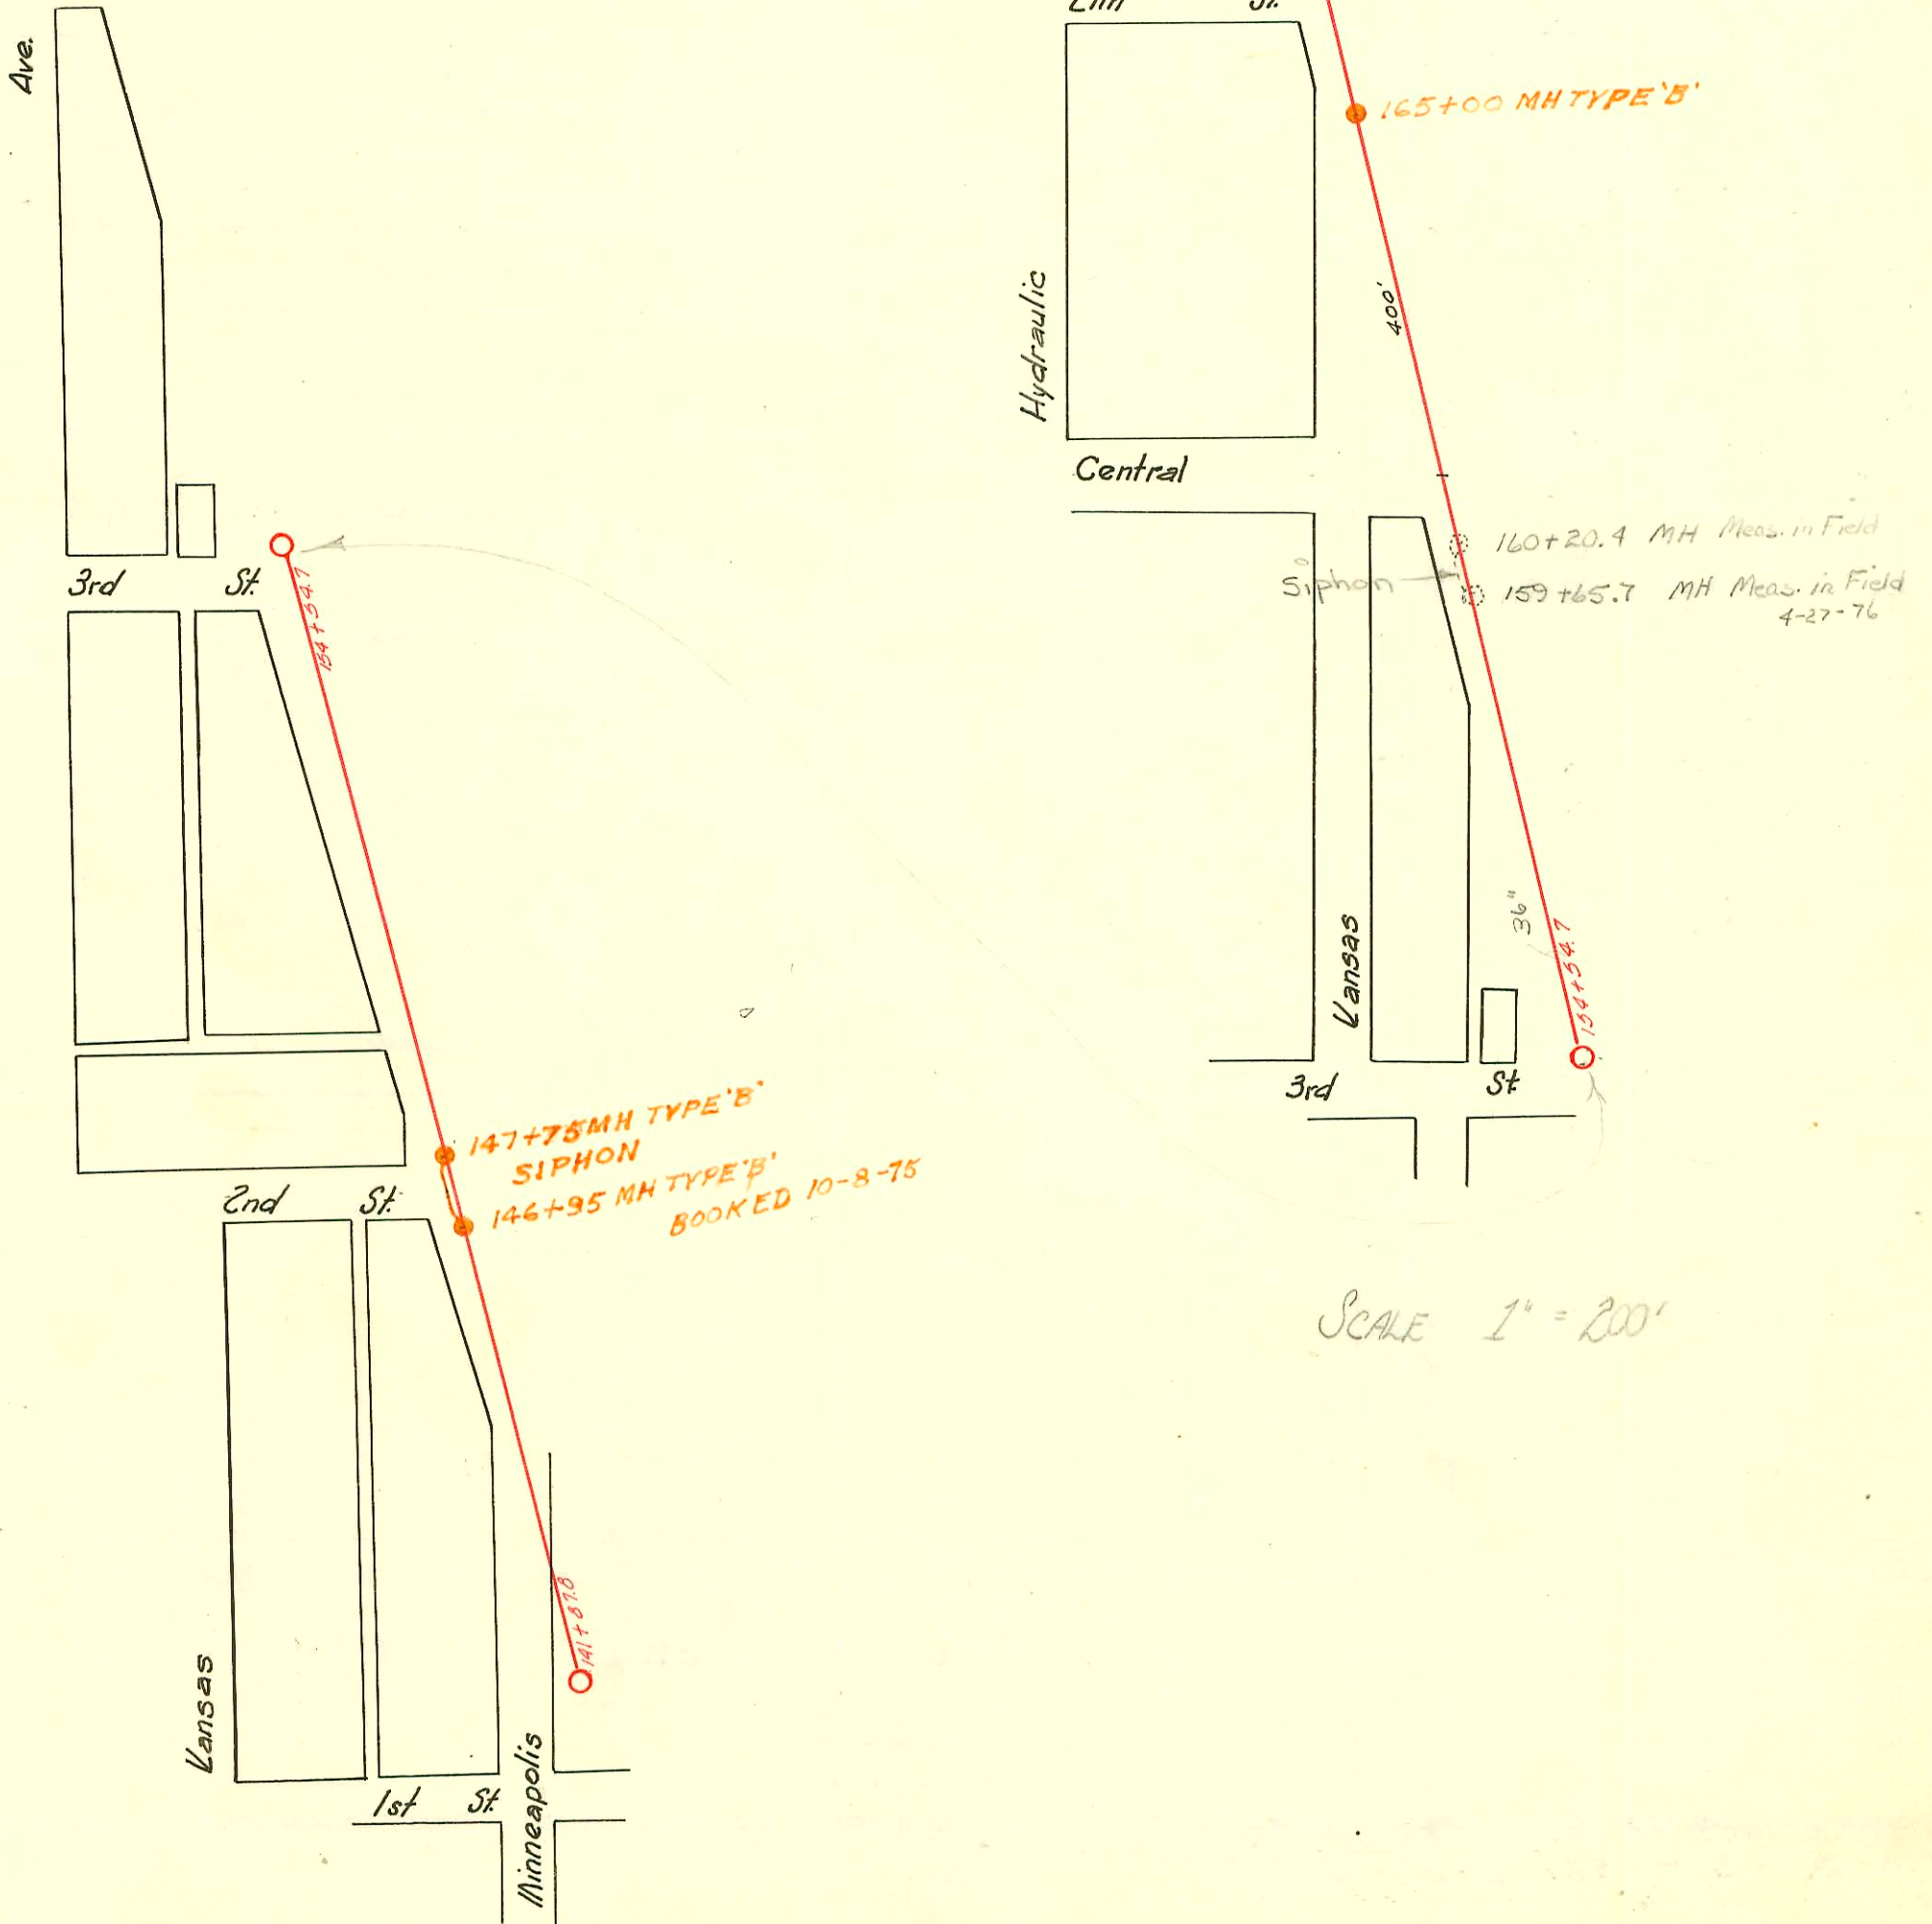

SCALE 1" = 200'

CONSTRUCTION RECORD						SERVICE RECORD						
STATION	ELEVATION		Depth	MANHOLE	4-INCH "Y" BRANCHES		No. of Permit		House Number		DATE OF PERMITS	
	Ground	Grade			North West	South East	North West	South East	North West	South East	North West	South East
				141+87.0								
142+0	109.00	97.46	11.54									
143+0	108.10	97.52	10.58									
144+0	109.30	97.59	11.71									
145+0	109.40	97.66	11.74									
146+0	110.90	97.73	13.17									
147+0	110.50	97.80	12.70	146+95								
148+0	111.00	97.87	13.13	147+50								
149+0	111.00	97.94	13.06									
150+0	110.80	98.01	12.79									
151+0	110.70	98.08	12.62									
152+0	110.70	98.15	12.55									
153+0	110.80	98.22	12.58									
154+0	110.90	98.29	12.61									
	111.50	98.33	13.17	154+54.7								
155+0	111.60	98.36	13.24									
156+0	111.80	98.43	13.37									
157+0	111.40	98.50	12.90									
158+0	111.50	98.57	12.93									
159+0	111.70	98.64	13.06									
160+0	111.90	98.71	13.19									
161+0	112.00	98.78	13.22									
162+0	112.90	98.85	14.05									
163+0	112.50	98.92	13.58									
164+0	112.60	98.99	13.61									
165+0	112.50	99.06	13.44	165+00								
166+0	112.80	99.13	13.67									
167+0	113.00	99.20	13.80									
168+0	113.20	99.27	13.93									
169+0	113.40	99.34	14.06									
170+0	113.80	99.41	14.39	169+60								
171+0	114.80	99.48	15.32									
172+0	115.10	99.55	15.55									
173+0	115.30	99.62	15.68									
174+0	115.30	99.69	15.61									
175+0	115.50	99.76	15.74									
	114.50	99.78	14.72	175+37.2								
176+0	113.00	99.83	13.17									
177+0	111.50	99.90	11.60									
	111.00	99.92	11.08	177+30.0								
178+0	111.30	99.97	11.33									
179+0	109.80	100.04	9.76									
180+0	109.60	100.11	9.49									
181+0	109.90	100.18	9.72									
182+0	110.50	100.25	10.25									
183+0	110.60	100.32	10.28									
184+0	112.60	100.39	12.21									
185+0	113.30	100.46	12.84									
186+0	113.00	100.53	12.47	186+04.3								
	113.00	100.55	12.45	186+13.3								

#2725 - Tap - 1626 E. Mordock - 10-2-40 - Bryant (\$10.00 special fee paid 10-2-40)
 #1622 - Tap - 1884 E. 6th - 6-27-44 - Wichita Pkg. Co.
 #6291 - Tap - 735 N. Hydraulic - 9-9-55 - Kendall (M.H. 177+30.0)