


LATERAL 28 MAIN 4 SOUTHWEST INTERCEPTOR
BUILT BY: UTILITY CONTR. INC.
PROJ. NO 468-76-245-80586-000-000-001
BOOKED 5-23-79 FROM LES 18

SCALE 1"=150'

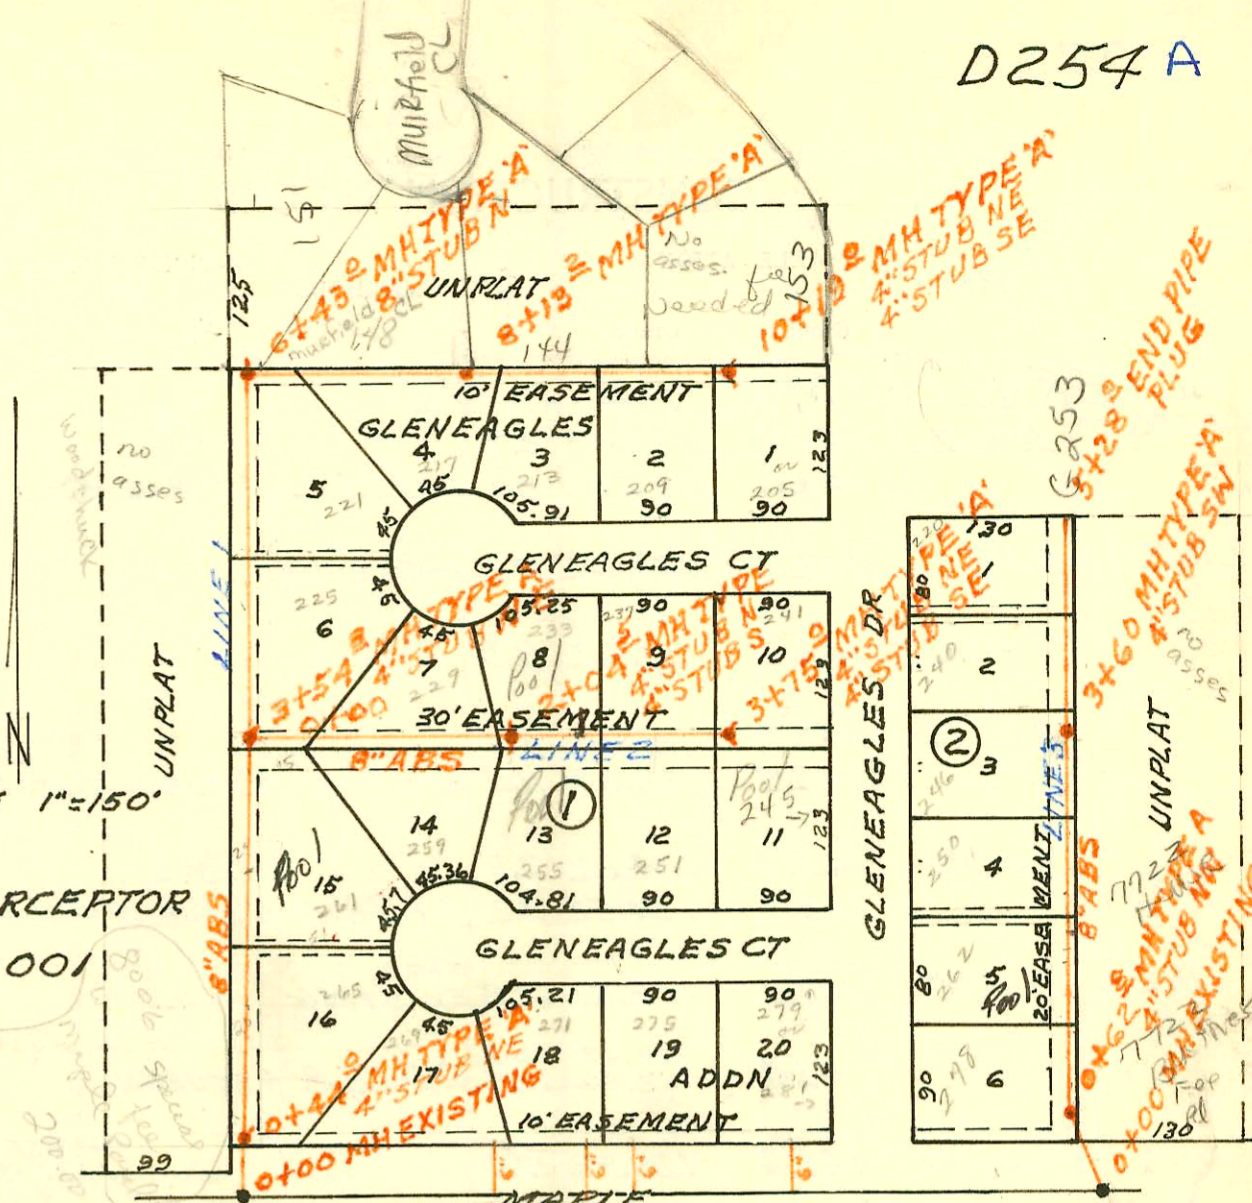

NOTE: FOR ELEV & LOCATION
ALONG MAPLE SEE
M 158

CONSTRUCTION RECORD

SERVICE RECORD

STATION	ELEVATION		Depth	MANHOLE	4-INCH "Y" BRANCHES		No. of Permit		House Number		DATE OF PERMITS			
	Ground	Grade			North West	South East	North West	South East	North West	South East	North West	South East	North West	South East
LAT 27 MAIN 3 SWI LINE 2 CONT														
6	89.1	81.70	7.4	5+98.9		4+94.0		C70972		2208 W 46th S		4-2-79		
6+00	89.1	81.70	7.4			5+62		C70974		2212 W 46th S		4-2-79		
7+00	89.7	81.90	7.8			6+28.4		C70097		2230 W 46th S		1-12-79		
8+00	89.7	82.10	7.6			6+94.9		C70975		2228 W 46th S		4-2-79		
9+00	89.8	82.30	7.5			8+00.1		C70976		2234 W 46th S		4-2-79		
	89.8	82.31	7.5	9+02.1		8+57.7		C70098		2240 W 46th S		1-12-79		
						8+98.2		C70977		2246 W 46th S		4-2-79		
						4" STUB SW								
LINE 3 0+00	89.4	81.10	8.3	0+00=5+68.8 LINE 1		0+45.6		C70025		4710 S. E46th S		10-29-78		
1+00	89.7	81.30	8.4											
2+00	89.7	81.50	8.2			1+89.3		C73860		2107 W. 46th S		8-23-79		
	90.0	81.70	8.3	2+99.2		2+57.3		C73862		2113 W. 46th S		8-23-79		
						2+71.0		C72876		2106 Davis Dr		8-7-79		
								C70964		2112 Lansbury		7-11-79		
3+00	90.0	81.70	8.3			3+22.2		C73861		2119 E 46th S		8-23-79		
4+00	90.0	81.90	8.1			3+33.5		C73856		2118 Davis Dr		8-23-79		
5+00	89.4	82.10	7.3			4+19.8		C72892		2125 W 46th S		7-11-79		
	90.0	82.18	7.8	5+39.4		4+09.9		C73481		2124 Davis Dr		8-7-79		
						4+78.8		C73857		2202 Davis Dr		8-23-79		
6+00	89.7	82.30	7.4			4+85.9		C72893		2203 W 46th S		7-11-79		
						5+61.4		C72894		2209 W 46th S		7-11-79		
7+00	90.0	82.50	7.5			6+19.2		C74608		2213 W 46th S		7-18-80		
	90.3	82.66	7.6	7+79.6		6+92.7		C77000		2219 Davis Dr		12-19-80		
						6+57.4		C77003		2220 Davis Dr		3-25-80		
						7+48.0				2228 Davis Dr		3-25-80		
8+00	90.5	82.70	7.8			7+57.3				2227 W. 46th S		12-18-80		
9+00	91.1	82.90	8.2			8+32.0				2233 W 46th S		12-18-80		
10+00	91.5	83.10	8.4			9+21.0				2239 W 46th S		12-19-80		
	91.0	83.14	7.9	10+20.6		10+67.9				4721 S. BENNETT		4-2-79		
		83.24	7.8			11+30.6				4729 BENNETT		1-12-79		
11+00	91.1	83.40	7.7			11+46.6				2249 W DANZ DR		4-2-79		
	91.0	83.50	7.5	11+50.6		4" STUB SW						4-2-79		
LINE 4 0+00	91.0	83.24	7.8	0+00=10+20.6 LINE 3		0+21.3		C70090		4711 Bennett		1-12-79		
1+00	91.0	83.44	7.6			1+44.7				4705 BENNETT		4-2-79		
	91.0	83.54	7.5	1+52.2		4" STUB SW				2250 W. 46th S		1-12-79		
LATERAL 28 MAIN 4 SOUTHWEST INTERCEPTOR LINE 1														
0+00	142.3	130.38	11.9	0+00 EXISTING										
	142.2	130.51	11.7											
		130.61	11.6	0+44.0		4" STUB NE				2165 Glencastle		4-9-80		
1+00	142.3	130.78	11.5			1+96.6								
2+00	142.6	131.08	11.5			2+09.6				3006 W 71 Maple		4-2-82		
						4" RISER 2+09 E 8' Deep				261 Glencastle		5-16-83		
3+00	142.5	131.38	11.1			3+243.0				614 Glencastle		11-05-79		
	142.3	131.54	10.8	3+54.8		4" STUB NE								
4+00	142.2	131.68	10.5			4+46.1				225 Glencastle		7-11-80		
5+00	142.6	131.98	10.6			5+57.9				321 Glencastle		12-5-80		
						4" RISER 5+16 E 8' Deep				203 S. Wendelchuck		11-9-84		
6+00	142.3	132.28	10.0			6+43.0								
	141.7	132.41	9.3	6+43.0		8" STUB N				151 Muirfield		1-20-81		
		134.00	7.7											
7+00	142.1	134.23	7.9			7+44.2				148 S. Muirfield		2-2-82		
8+00	143.4	134.63	8.8			8+00.1				217 Glencastle		3-22-82		
	143.5	134.68	8.8	8+13.2		8+60.2				213 Glencastle		12-15-82		
						8+94.8						2-5-88		
9+00	143.8	135.03	8.8											

CONT'D NEXT PAGE

see page M155
 C75633 - 275 Alan Eagles - 12-6-79 - Dangers
 C75630 - 281 " " " " - 12-6-79 - " "