


LATERAL 16 MAIN 2 SOUTHWEST INTERCEPTOR  
BUILT BY: MID STATES CONST. CO.  
PROJ. NO 468-76-245-80621-000-000-001  
BOOKED 6-2-79 FROM TCD 35

on map

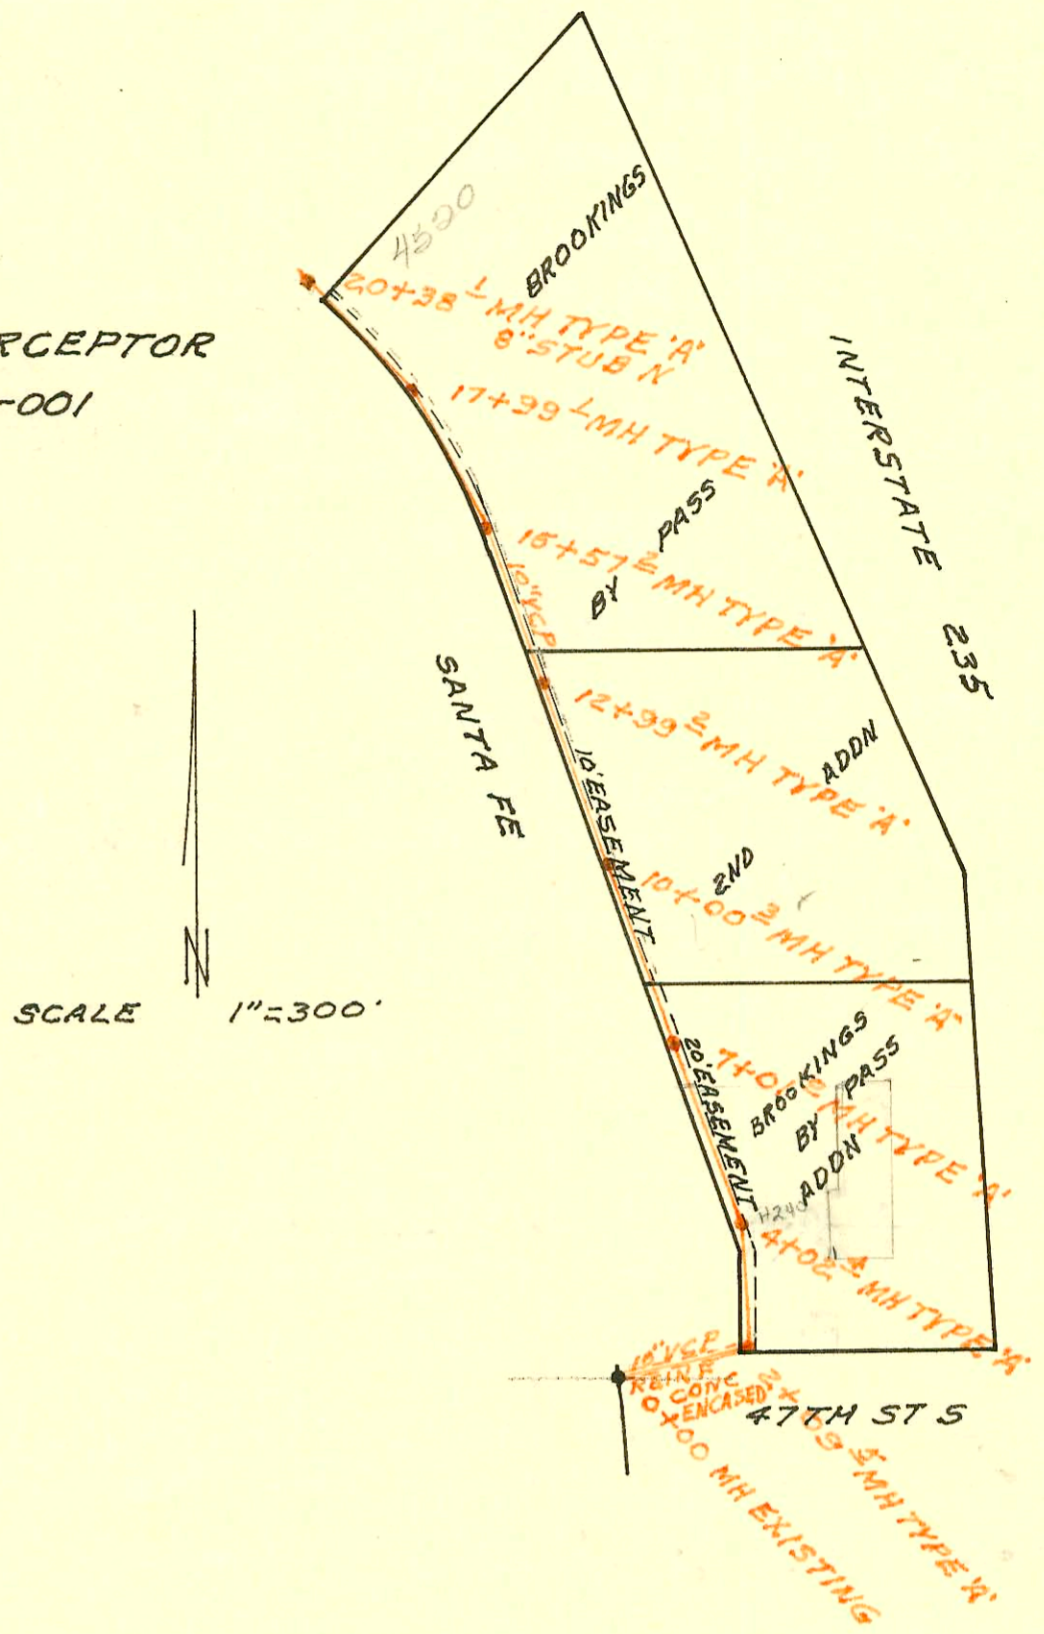

121

CONSTRUCTION RECORD

SERVICE RECORD

STATION	ELEVATION		Depth	MANHOLE	4-INCH "Y" BRANCHES		No. of Permit		House Number		DATE OF PERMITS	
	Ground	Grade			North West	South East	North West	South East	North West	South East	North West	South East
<b>LATERAL 28 MAIN 4 SWI</b>												
LINE 1 CONT 10+00	143.7	135.43	8.3				14052	# 01206 933	153 Glencagles	207 Glencagles 205 Glencagles	6-21-85	9-11-80 8-6-80
	143.6	135.50	8.1	10+19.0	4"STUB NE	4"STUB SE						
LINE 2 0+00	142.3	133.02	9.3	0+00 = 3+54.8 LINE 1								
1+00	143.3	133.42	9.9				1+40.5	C74852	229 Glencagles	259	10-15-79	
2+00	143.9	133.82	10.1				1+77.5 2+55.0 2+92.0	C75360 C73493 C74428	233 Glencagles 251 Glencagles	259 Glencagles 251 Glencagles	8-8-79	11-15-79 9-22-81 11-17-80 9-20-79
3+00	143.7	134.22	9.5				3+48.5	#187	237 Glencagles	245 Glencagles	4-29-80	
	143.7	134.52	9.2	3+75.0	4"STUB NE	4"STUB SE		C73494	C73573	245 Glencagles	8-8-79	8-13-79
LINE 3 0+00	141.3	128.51	12.8	0+00 EXISTING								
	141.4	128.69 128.86	12.7 12.5	0+62.8	4"STUB NW			C73491	278 Glencagles		8-8-79	
1+00	141.4	128.98	12.4				1+89.8 top	1410	362 Glencagles	417 MAPLE (house)	10-3-80	
2+00	140.9	129.28	11.6				2+04.8 top	C72324	250 Glencagles	7722 (BUS) MAPLE	8-8-79	6-13-79
3+00	140.7	129.58	11.1				2+31.5 3+21.6	C73492	246 Glencagles	7722 (BUS) MAPLE	8-8-79	5-26-93
	140.7	129.76	10.9	3+60.0	4"STUB SW	4" RISER		C74632	73-12845 Glencagles		10-4-79	
4+00	140.8	129.88	10.9				4+00.0 4+81.6	C75710 1489	340 Glencagles 220 Glencagles		12-13-79 10-13-80	
5+00	140.5	130.18	10.3									
5+28	140.6	130.26	10.3	PLUGGED								
<b>LATERAL 16 MAIN 2 SWI</b>												
0+00	82.8	72.51	10.3	0+00 EXISTING								
1+00	74.7	72.72	2.0	CONC								
2+00	82.4	72.93	9.5	ENCASED								
	84.5	72.94 73.44	11.6 11.1	2+09.5								
3+00	82.0	73.59	8.4									
4+00	80.6	73.75	6.9									
	85.0	73.76 74.66	11.2 10.3	4+02.4								
5+00	81.7	74.85	6.9									
6+00	81.2	75.05	6.2									
7+00	84.8	75.26	9.5	7+01.0								
8+00	82.3	75.45	6.9									
9+00	82.1	75.65	6.5									
10+00	81.8	75.85	6.0	10+00.3								
11+00	81.8	76.05	5.8									
12+00	82.2	76.25	6.0									
13+00	85.1	76.45	8.7	12+99.2								
14+00	84.4	76.65	7.8									
15+00	84.8	76.85	8.0									
	85.3	76.96	8.3	15+57.2								
16+00	83.8	77.05	6.8									
17+00	82.3	77.25	5.1									

(CONT'D NEXT PAGE)

100<sup>00</sup> fee paid on 7722 Maple - 6-13-79 - Rec. # 463910  
 \$ 2,165<sup>00</sup> fee paid 5-11-93 - 7722 w Maple (Business)  
 Key # 93001140

98-234967 12-9-98 7724 w Maple  
 (convert gar. to living) -

addresses  
 7724 w Maple - house