


LATERAL 26 MAIN 1 SOUTHWEST INTERCEPTOR  
BUILT BY: SHAWNEE CONST. CO.  
PROJ. N<sup>o</sup> 468-76-245-80078-000-000-002  
BOOKED 6-2-79 FROM SRL 13

on map


SCALE 1"=150'

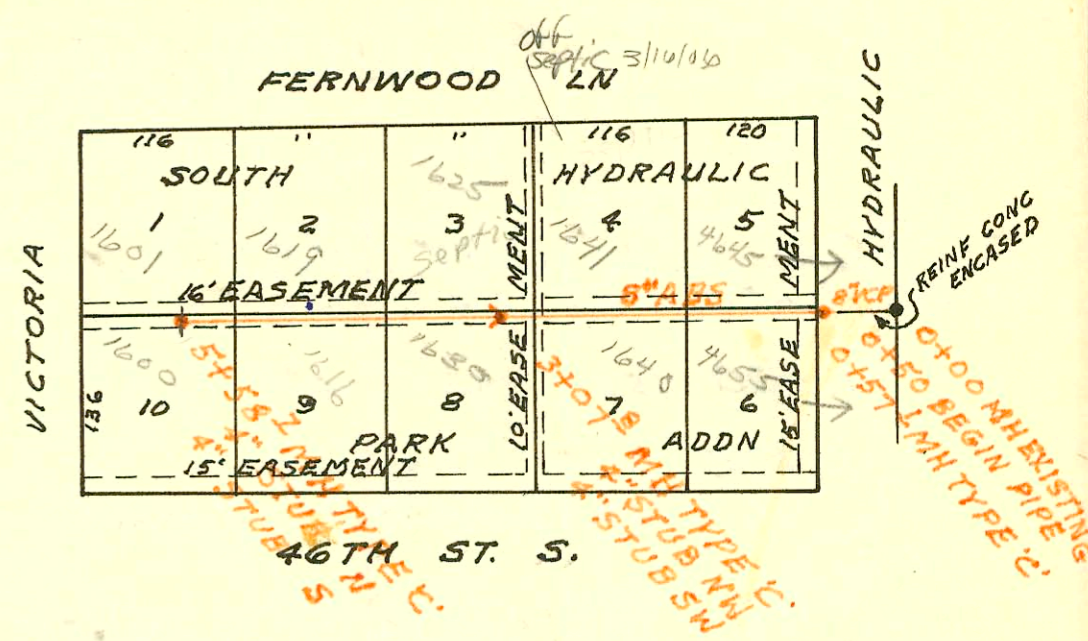

LATERAL 33 MAIN 3 SAN SEWER N<sup>o</sup> 22  
BUILT BY: MID STATES CONST. CO.  
PROJ. N<sup>o</sup> 468-76-245-80241-000-000-001  
BOOKED 6-2-79 FROM LES 14

on map

SCALE 1"=150'

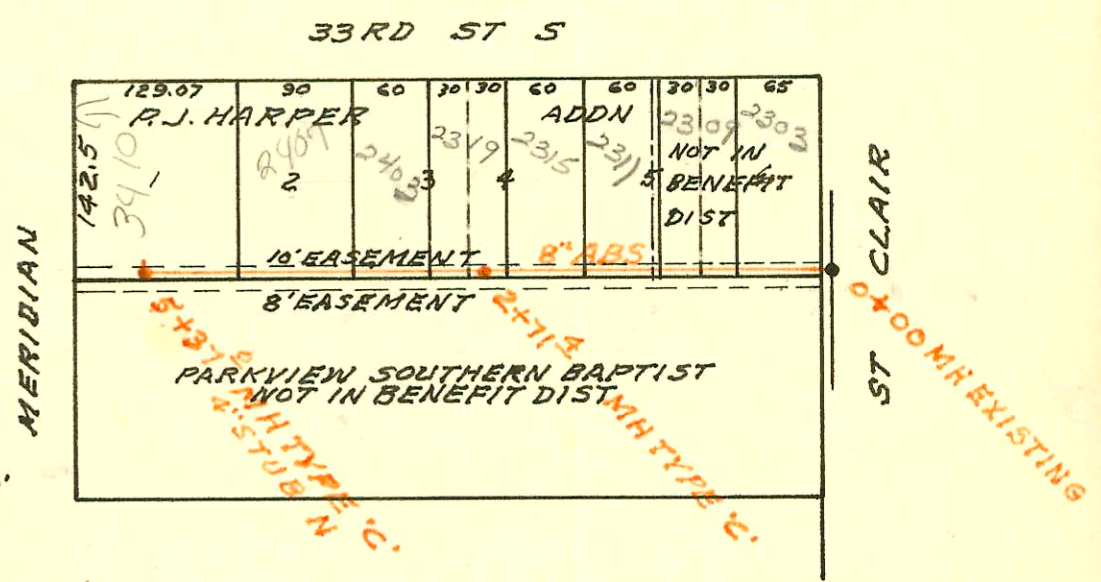

CONSTRUCTION RECORD						SERVICE RECORD						
STATION	ELEVATION		Depth	MANHOLE	4-INCH "Y" BRANCHES		No. of Permit		House Number		DATE OF PERMITS	
	Ground	Grade			North West	South East	North West	South East	North West	South East	North West	South East
<b>LAT 16 MAIN 2 SWI (CONTD)</b>												
18+00	85.7	77.45 77.65	8.3 8.1	17+99.1								
19+00	83.8	77.85	6.0		19+72.7		C78335		4520 S. SANTAFE		7-31-79	
20+00	85.0 85.4	78.05 78.13	7.0 7.3	20+38.1	8" STUB N							
<b>LATERAL 26 MAIN 1 SOUTHWEST INTERCEPTOR</b>												
0+00	84.4	70.10	14.3	0+00 EXISTING								
0+50	83.7	OUT 70.23 IN 72.73	13.5 11.0	0+57.1								
1+00	83.6	72.90	10.7		1+32.0		6011		4645 S. Hydraulic		6-21-80	
2+00	83.5	73.30	10.2		1+61.7		C72027		4655 S. Hydraulic		5-29-79	
3+00	83.6 83.6	73.70 73.73	9.9 9.9	3+07.8	4" STUB NW 4" STUB SW		2006- 00741	C71732	1641 E. Fernwood	1640 E 4657 SO 1630 E 4657 So	3-16-06	5-14-79 5-22-79
4+00	84.0	74.10	9.9		4+62.1		C71939	C72623	1619 Fernwood	1625 Fernwood SW 1616 E. 4657 SO.	6-28-79	5-22-79 5-25-79
5+00	85.0 85.1	74.50 74.73	10.5 10.4	5+58.7	4" STUB N 4" STUB S		19339		1601 Fernwood		10/19/87	
<b>LATERAL 33 MAIN 3 SAN SEWER NO 22</b>												
0+00	94.8	86.77	8.0	0+00 EXISTING	0+36		C71088		2303 W 3383 SO		4-9-79	
1+00	95.4	87.07	8.3		0+90.4		C71089		2309 W 3382 SO.		4-9-79	
2+00	95.4 95.6	87.37 87.58	8.0 8.0	2+71.4	2+17.1 3+76.8		C71090	C71091	2311 W 3382 SO 2315 W 3382 SO		4-9-79 4-9-79	
3+00	95.8	87.67	8.1		3+45.4		C71093		2403 W 3382 S		4-9-79	
4+00	95.8	87.97	7.8		4+17.4 TAP 4+88.0 TAP		18894	18902	2407 W 3382 SO 2410 S Meridian		8-10-87 8-19-87	
5+00	96.0 95.9	88.27 88.38	7.7 7.5	5+37.0	4" STUB N							
<b>LATERAL 121 SOUTHWEST INTERCEPTOR</b>												
LINE 1 0+00	154.3	141.88	12.4									
1+00	153.3 154.4	141.28 141.43	12.0 13.0	1+37.0	1+55.0 TAP		17344		7620 W Suncrest		11-21-86	
2+00	155.0 155.0	141.62 OUT 141.76 IN 141.86	13.4 13.2 13.1	2+47.2	8" STUB NE 8" STUB N 8" STUB SW							
3+00	155.0	142.02	13.0		10' Deep 4" RISER 3+05 W 10' Deep 4" RISER 3+13 E 3+53.0		18839		77147 WINDMILL		8-6-87	
4+00	155.4 156.0	142.32 142.38	13.1 13.6	4+20.8								
5+00	156.1	142.62	13.5									
6+00	157.5 157.5	142.92 OUT 142.93 IN 143.03	14.6 14.6 14.5	6+02.1	8" STUB N		17344		7620 W Suncrest		11-21-86	
7+00	159.1	143.32	15.8		12' Deep 4" RISER 6+30 S 12' Deep 4" RISER 6+69 S		25338-7	25649	7752 Harvest 7762 Harvest W		6-25-91 7-2-90	
8+00	159.5	143.62	15.9		12' Deep 4" RISER 8+26 S		24638		7800 Harvest		1-17-90	
9+00	159.5 159.5	143.92 144.05	15.6 15.5	9+42.5	8" STUB N 4" RISER 9+84 S		23791	26115	7808 Harvest 7816 Harvest		8-23-89 9-11-90	

CONT'D NEXT PAGE