


LATERAL 121 SOUTHWEST INTERCEPTOR  
 BUILT BY: UTILITY CONTR. INC.  
 PROJ. N<sup>o</sup> 468-76-245-80493 000-000-001  
 BOOKED 6-5-79 FROM LES 19

on map F  
 161526

SAN SEWER EXT. TO LOTS 246810 & 12  
 BLOCK 18 ORIENTA PK 2ND ADDN  
 BUILT BY: C & C DITCHING CO.  
 PROJ. N<sup>o</sup> 468-76-245-80750-000-000-008  
 BOOKED 6-7-79 FROM TCD 39

LATERAL 12 MAIN 18 SS N<sup>o</sup> 22  
 BUILT BY: ARKANSAS CONST. CO. SCALE 1" = 150'  
 PROJ. N<sup>o</sup> 468-76-245-80708-000-000-001  
 BOOKED 7-26-79 FROM CLG 08

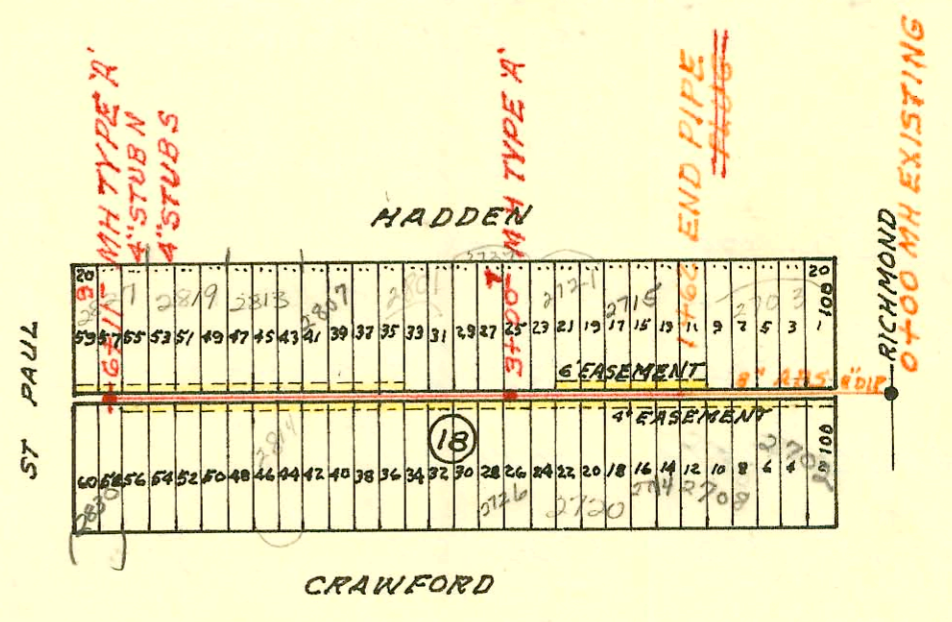

1	2	3	100
---	---	---	---	---	---	---	---	---	----	----	-----

CONSTRUCTION RECORD

SERVICE RECORD

STATION	ELEVATION		Depth	MANHOLE	4-INCH "Y" BRANCHES		No. of Permit		House Number		DATE OF PERMITS	
	Ground	Grade			North West	South East	North West	South East	North West	South East	North West	South East
LATERAL 121 SOUTHWEST INTERCEPTOR (CONT'D)												
LINE 1 CONT 10+00	159.5	144.22	15.3									
11+00	159.2	144.52	14.7									
12+00	159.0	144.82	14.2									
	158.9	145.03	13.9	12+37.2	4" STUB NE	4" STUB NW	4" STUB S					
13+00	158.8	145.22	13.6									
	158.5	145.56	12.9	13+78.9	4" STUB NE	4" STUB NW	4" STUB SE					
14+00	158.5	145.62	12.9									
15+00	158.4	145.92	12.5									
16+00	158.9	146.22	12.7									
	159.3	146.40	12.9	16+57.6	4" STUB W	4" STUB E						
17+00	159.9	146.53	13.4									
18+00	160.1	146.83	13.3									
19+00	160.6	147.13	13.5									
19+15	160.7	147.18	13.5									
LINE 2 0+00	158.9	144.93	14.0	0+00=12+37.2								
1+00	159.0	145.23	13.8	LINE 1								
1+20	159.0	145.29	13.7	PLUG								
SAN SEWER EXT TO LOTS 2, 4, 6, 8, 10, & 12 BLK 18 ORIENTA PK 2ND ADDN												
0+00	101.2	97.02	4.2	EXISTING								
0+42				END D.P. BEGIN ABS								
1+00	101.1	97.27	3.8									
1+62	101.0	97.43	3.6									
LATERAL 12 MAIN 18 55 N#22												
0+00				EXISTING ABOVE								
1+62	101.0	97.43	3.6	ABOVE								
2+00	101.0	97.52	3.5									
3+00	100.9	97.77	3.1	3+00.7								
4+00	101.1	98.02	3.1									
5+00	102.0	98.27	3.7									
6+00	101.9	98.52	3.4									
	101.8	98.55	3.3	6+11.9	4" STUB N	4" STUB S						