


SCALE 1" = 300

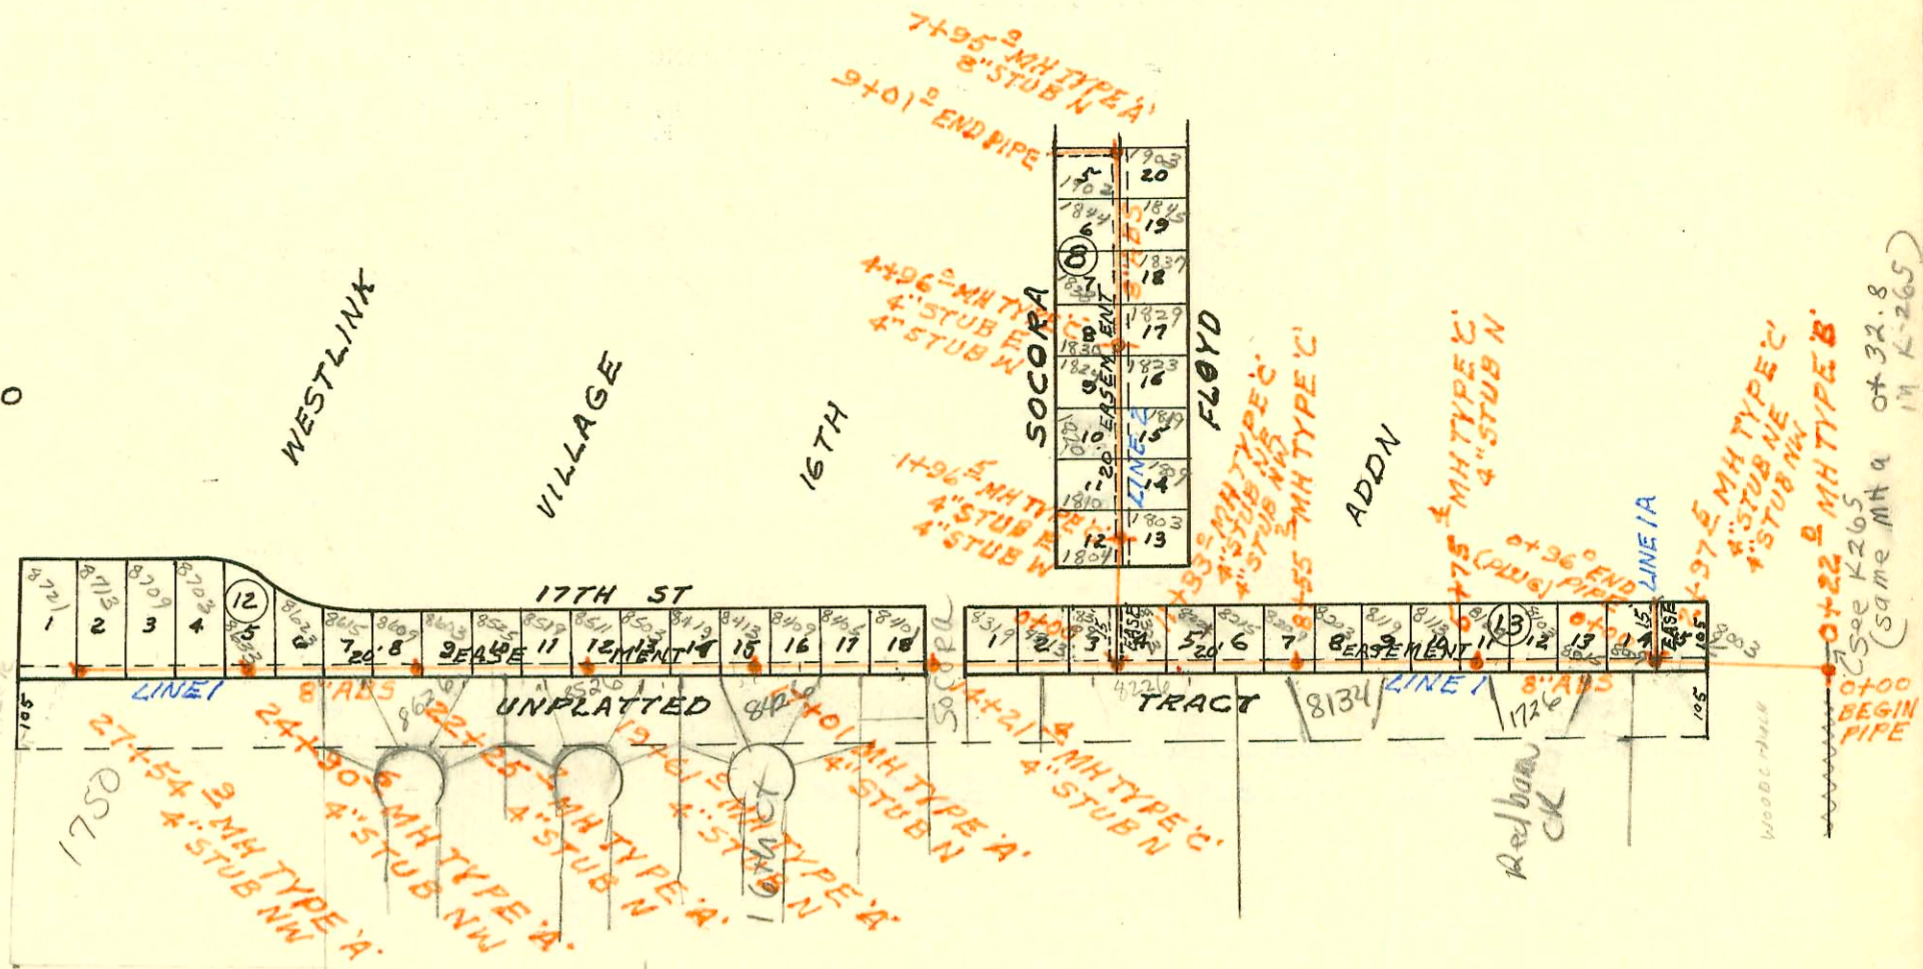

LATERAL 137 SOUTHWEST INTERCEPTOR  
 BUILT BY: UTILITY CONTR. INC.  
 PROJ. NO 468-76-245-80617-000-000-001  
 BOOKED 7-5-79 FROM LES 21

plat 541

CONSTRUCTION RECORD

SERVICE RECORD

STATION	ELEVATION		Depth	MANHOLE	4-INCH "Y" BRANCHES		No. of Permit		House Number		DATE OF PERMITS			
	Ground	Grade			North West	South East	North West	South East	North West	South East	North West	South East	North West	South East
<b>LATERAL 131 SOUTHWEST INTERCEPTOR (CONT'D)</b>														
LINE 1 CONT'D	5+00	171.5	161.96	9.5		5+42.6	5+52.7	5398	00850	1904	8606	3-2-82	7-23-80	
		172.5	162.98	9.5	5+92	4"STUB W	4"STUB E	C74259	C73635	Robin Rd	1700	9-13-79	8-15-79	
<b>LINE 2</b>														
	0+00	166.2	156.88	9.3	0+00=0+00 LINE 1	0+67.0	0+25.0	12292	18087	1918 Robin Rd	1921 TURQUOISE	10-18-84	4-9-89	
	1+00	165.5	157.18	8.3		1+54.0	1+72.0	11501	15818	1926 N Robin Rd	1927 Turquoise	7-19-84	3-14-86	
	2+00	165.2	157.48	7.7		2+14.0		11810		1925		8-20-84		
		164.9	157.57	7.3	2+31.0		4"Stub NE		17440		1933 Turquoise		12-12-86	
<b>LINE 3</b>														
	0+00	166.9	157.13	9.8	0+00=0+51.5 LINE 1		0+64		175163		1904 Robin Rd		11-2-79	
	1+00	167.3	157.43	9.9										
	1+10.7	167.7	157.46	10.2	PLUG									
<b>LATERAL 137 SOUTHWEST INTERCEPTOR</b>														
LINE 1	0+00	160.8	147.09	13.7										
		157.8	147.26	10.5	0+22.0									
	1+00	159.9	147.49	12.4										
	2+00	160.5	147.80	12.7										
		160.2	148.13	12.1	2+97.5	4"STUB NE	4"STUB NW							
	3+00	160.3	148.14	12.2		4"RISER 10' Deep		C72679		8009 W		7-3-79		
						3+81 N		C73439		1774	8015 W	8-7-79		
	4+00	160.7	148.44	12.2		4"RISER 9.5 Deep				8103 W	1726 Redwood	7-3-79	1-12-97	
						4+57 N	4+02.4	C72681	985867	1724				
	5+00	159.7	148.74	11.0		5+44.4	4"STUB N	C72678		8109 W	1724	7-3-79		
		160.7	148.97	11.7	5+75.4									
	6+00	161.0	149.04	12.0		4"RISER 9.2 Deep		C73440		8113 W		8-7-79		
						6+09 N				1724	8119 W	7-3-79		
	7+00	161.5	149.34	12.2		4"RISER 9.4 Deep		C72680		8203 W	1724	7-3-79		
						7+61 N								
	8+00	161.8	149.64	12.2		8+55.2	4"STUB N	C72645		8209 W	1724	6-27-79		
		163.0	149.81	13.2										
	9+00	163.4	149.94	13.5		4"RISER 10.2 Deep				8215 W		11-26-79		
						9+13 N				1724 N				
	10+00	164.8	150.24	14.6		4"RISER 10.2 Deep		C75436		8221 W	1724	8-10-84		
						9+29 N								
	11+00	165.0	150.54	14.5		10+41.9		11743		8309 W		11-9-82		
		165.3	150.62	14.7	11+33.0	4"STUB NE	4"STUB NW	6954		1724				
			154.67	10.7										
	12+00	165.9	155.47	10.4		12+18.4		C74893		8313 W	1724	10-16-79		
	13+00	167.5	156.71	10.8		13+18.4		11891		8319 W	1724 N	9-4-84		
	14+00	168.7	157.95	10.8		14+21.4	4"STUB N							
		168.8	158.20	10.6		14+74.4		C76435		8401 W		2-6-80		
	15+00	169.7	159.19	10.5		15+51		C73334		8405 W		7-31-79		
						16+20.4		C73333		8409 W		7-31-79		
	16+00	171.2	160.43	10.8		16+92.4		C76746		8413 W		3-10-80		
						17+01.0	4"STUB N		96-334-7	8419 W	1724 N	5-8-80	3-12-96	
	17+00	171.3	161.67	9.6		17+91.4		#271						
	18+00	171.2	162.07	9.1		18+70.7		C73394		8503 W		8-3-79		
						19+35.8		C73393	94-198907	8511 W	1724	8-3-79	12-2-91	
	19+00	171.0	162.47	8.5		19+61.0	4"STUB N			8526 W	1724 N			
		171.6	162.71	8.9										
	20+00	172.3	162.87	9.4		20+03.7		C75866		8519 W		12-27-79		
						20+77.5		C75867		8525 W		12-27-79		
	21+00	173.0	163.27	9.7						1724 N				

(CONT'D NEXT PAGE)