

RECONSTRUCTION OF PORTION  
LATERAL 5 DISTRICT C 35 N<sup>o</sup> 20  
BUILT BY: MID STATES CONST. CO.  
PROJ. N<sup>o</sup> 542-80-245-80001-000-000-001  
BOOKED 8-8-79 FROM G-6

ON MAP


SCALE 1" = 150'

50	150	20	150	49	25
52				51	
54				53	
56				55	
58				57	
60				59	
62				61	
64				63	
66				65	
68				67	
70				69	
72				71	
74				73	
76				75	
78				77	
80				79	
82				81	
84				83	
86				85	
88				87	
90				89	
92				91	
94				93	
96	150	20	150	95	25

MEAD

MOSLEY

FUN STON

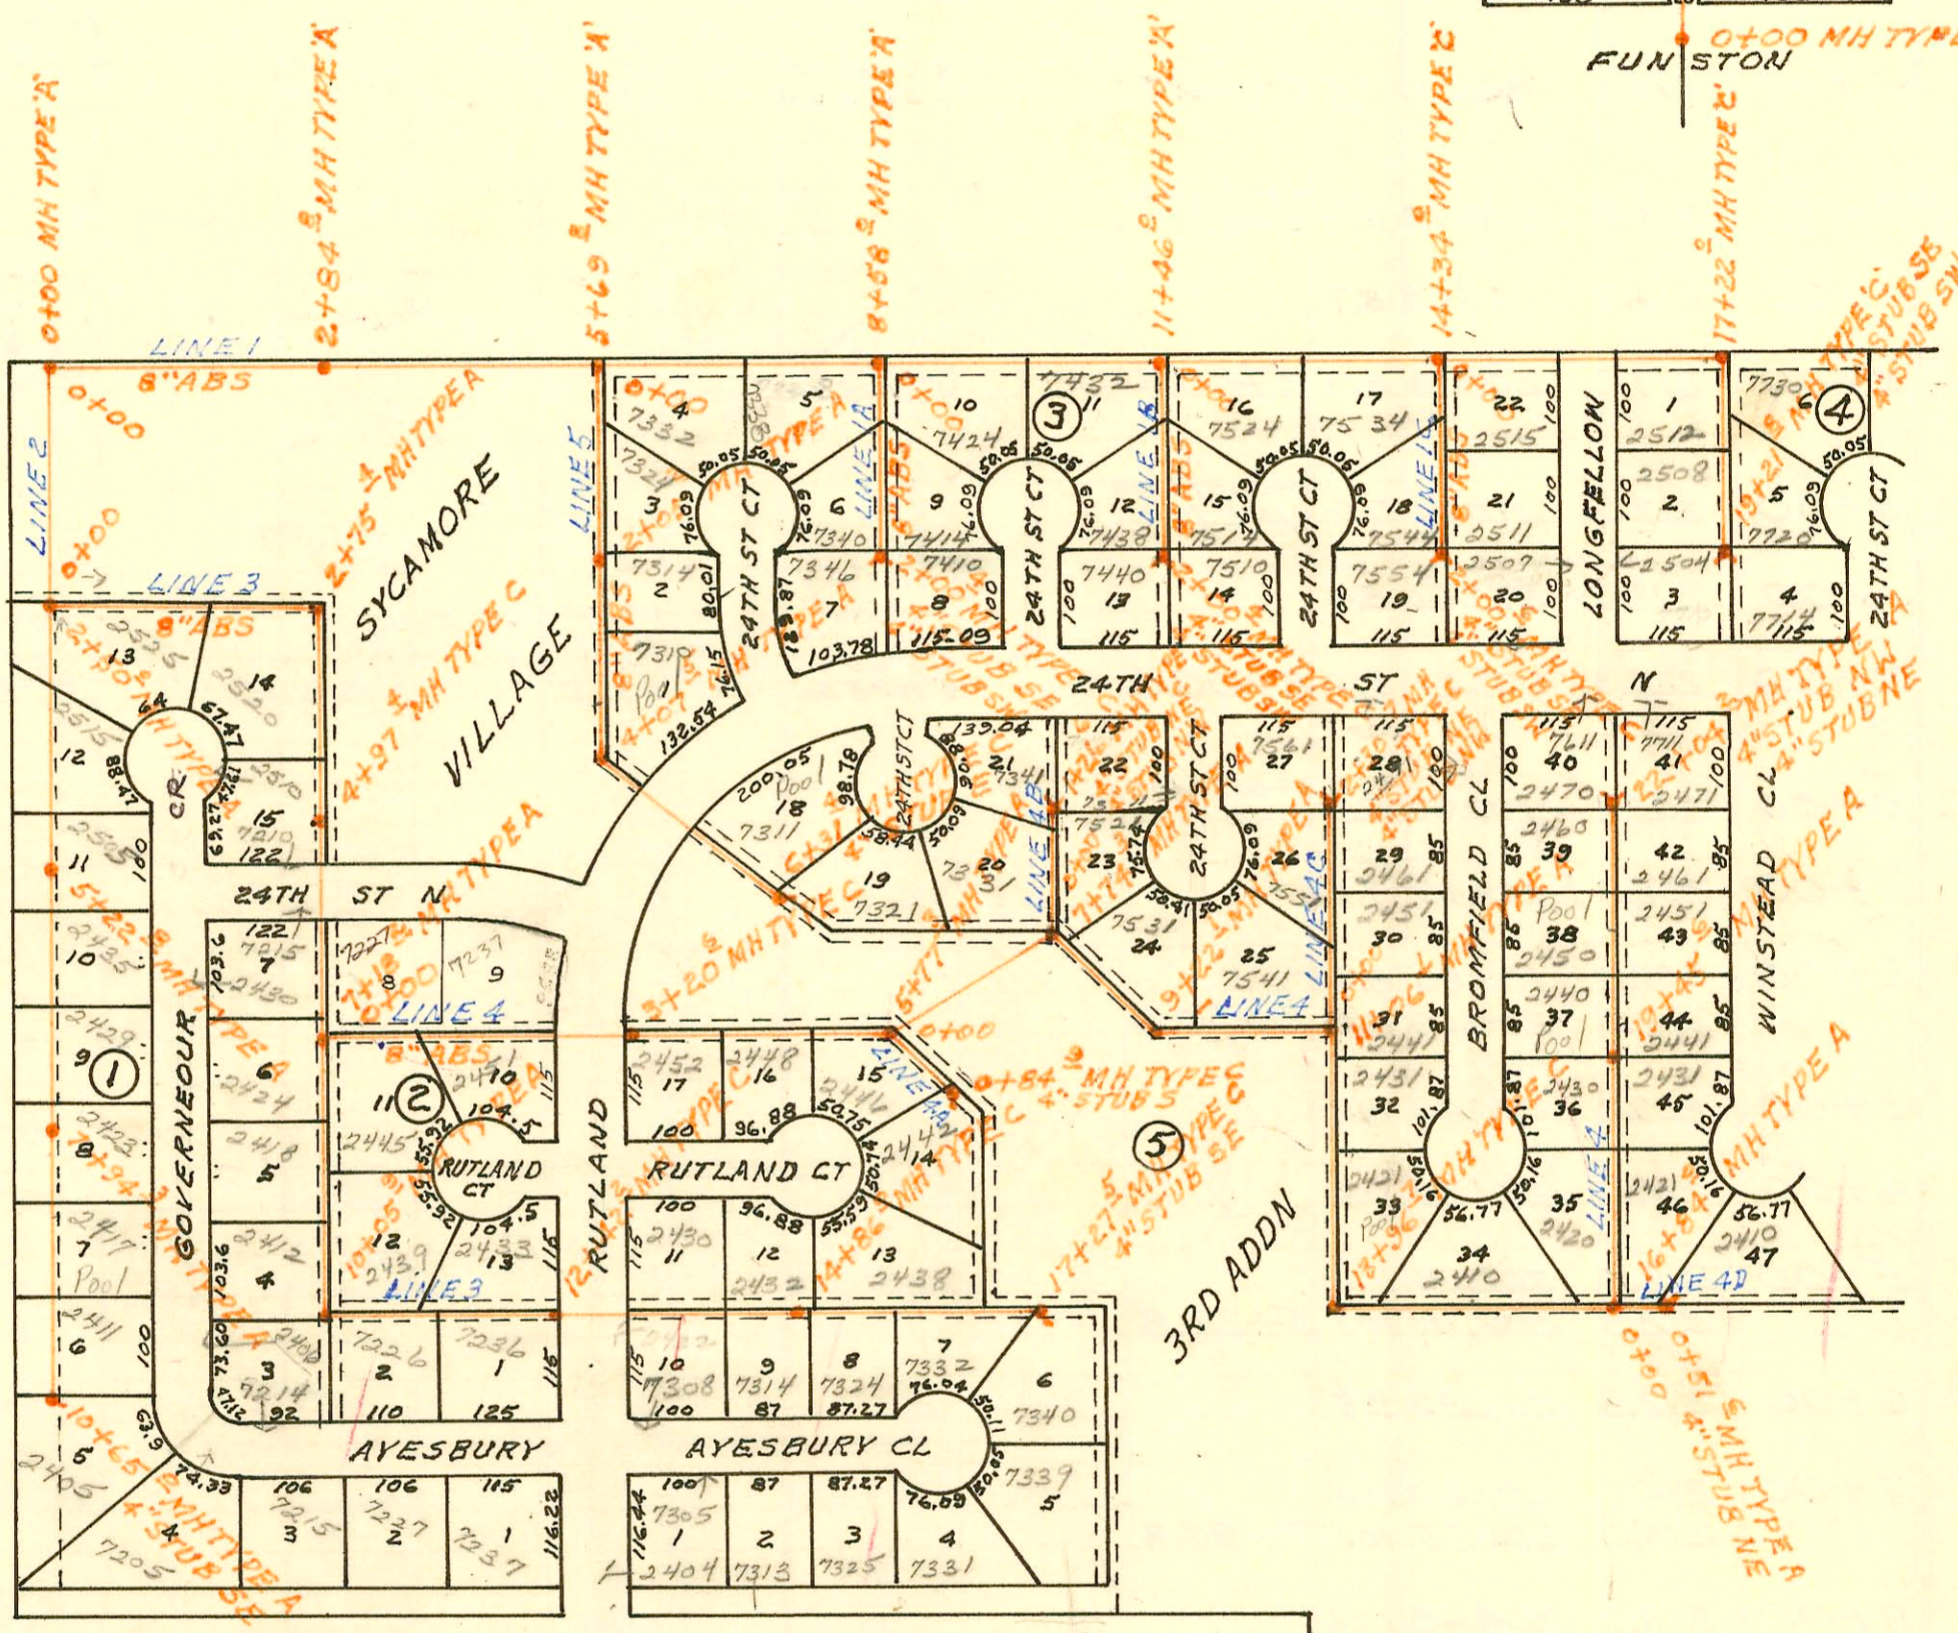

LATERAL 37 SAN SEWER N<sup>o</sup> 23  
BUILT BY: UTILITY CONTR. INC.  
PROJ. N<sup>o</sup> 468-76-245-80595-000-000-001  
BOOKED 8-15-79 FROM MRT #5

ON MAP

SCALE 1" = 200'

CONSTRUCTION RECORD						SERVICE RECORD						
STATION	ELEVATION		Depth	MANHOLE	4-INCH "Y" BRANCHES		No. of Permit		House Number		DATE OF PERMITS	
	Ground	Grade			North West	South East	North West	South East	North West	South East	North West	South East
LAT 37 55 LINE 1 CONT'D	N#23 (CONTD)											
16+00	218.4	210.57	7.8									
17+00	219.7	210.97	8.7									
	220.5	211.06 211.16	9.4 9.3	17+22.0	17+56.8	17+73.0	5575	4343	2512 Longfellow	7730 E 24th Ct	4-8-82	10-14-81
18+00	220.9	211.63	9.3									
19+00	221.7	212.23	9.5									
	221.7	212.36	9.3	19+21.8	18+87.9	19+16.6	76349 744	1067	2508 Longfellow	7720 24th Ct	1-25-80 7-14-80	8-22-80
LINE 1A	0+00	211.5	205.00	6.5	0+00=8+58 LINE 1							
1+00	215.2	205.50	9.7									
2+00	215.5	206.00	9.5	2+00.4	1+77.9	1+54.4	8166	4893	7340 E 24th Ct	7410 E 24th Ct	5-16-83	12-10-81
LINE 1B	0+00	213.5	207.13	6.4	0+00=11+46 LINE 1							
1+00	216.3	207.63	8.7									
2+00	217.0	208.13	8.9	2+00.4	1+79.4	1+68.8	3983	6906	7438 E 24th Ct	7514 E 24th Ct	8-24-81	1-3-82
LINE 1C	0+00	217.0	210.01	7.0	0+00=14+34 LINE 1							
1+00	219.0	210.61	8.4									
2+00	220.3	211.21	9.1	2+00.6	1+30.6	1+33.0	5992	2512	7544 E 24th Ct	2511 R Longfellow	6-10-82	7-1-83
LINE 2	0+00	205.2	199.00	6.2	0+00=0+00 LINE 1							
1+00	206.8	199.40	7.4									
2+00	207.8	199.80	8.0									
	208.0	200.00	8.0	2+50.0								
3+00	209.0	200.40	8.6									
4+00	211.1	201.20	9.9									
5+00	212.0	202.00	10.0									
	212.3	202.18	10.1	5+22.8								
6+00	212.3	202.80	9.5									
7+00	214.0	203.60	10.4									
	215.0	204.35	10.7	7+94.3								
8+00	215.0	204.40	10.6									
9+00	215.6	205.20	10.4									
10+00	215.3	206.00	9.3									
	214.8	206.53	8.3	10+65.0								
LINE 3	0+00	208.0	200.10	7.9	0+00=2+50 LINE 2							
1+00	207.3	200.50	6.8									
2+00	206.7	200.90	5.8									
	207.0	201.20 201.30	5.8 5.7	2+75.4								
3+00	206.2	201.45	4.8									
4+00	209.0	202.05	7.0									
	211.9	202.63	9.3	4+97.4								

CONT'D NEXT PAGE

