


LATERAL 13 MAIN 7 55 N#23  
BUILT BY: MID STATES CONST. CO.  
PROJ. N# 468-76-245-80579-000-000-001  
BOOKED 8-23-79 FROM MRT 22



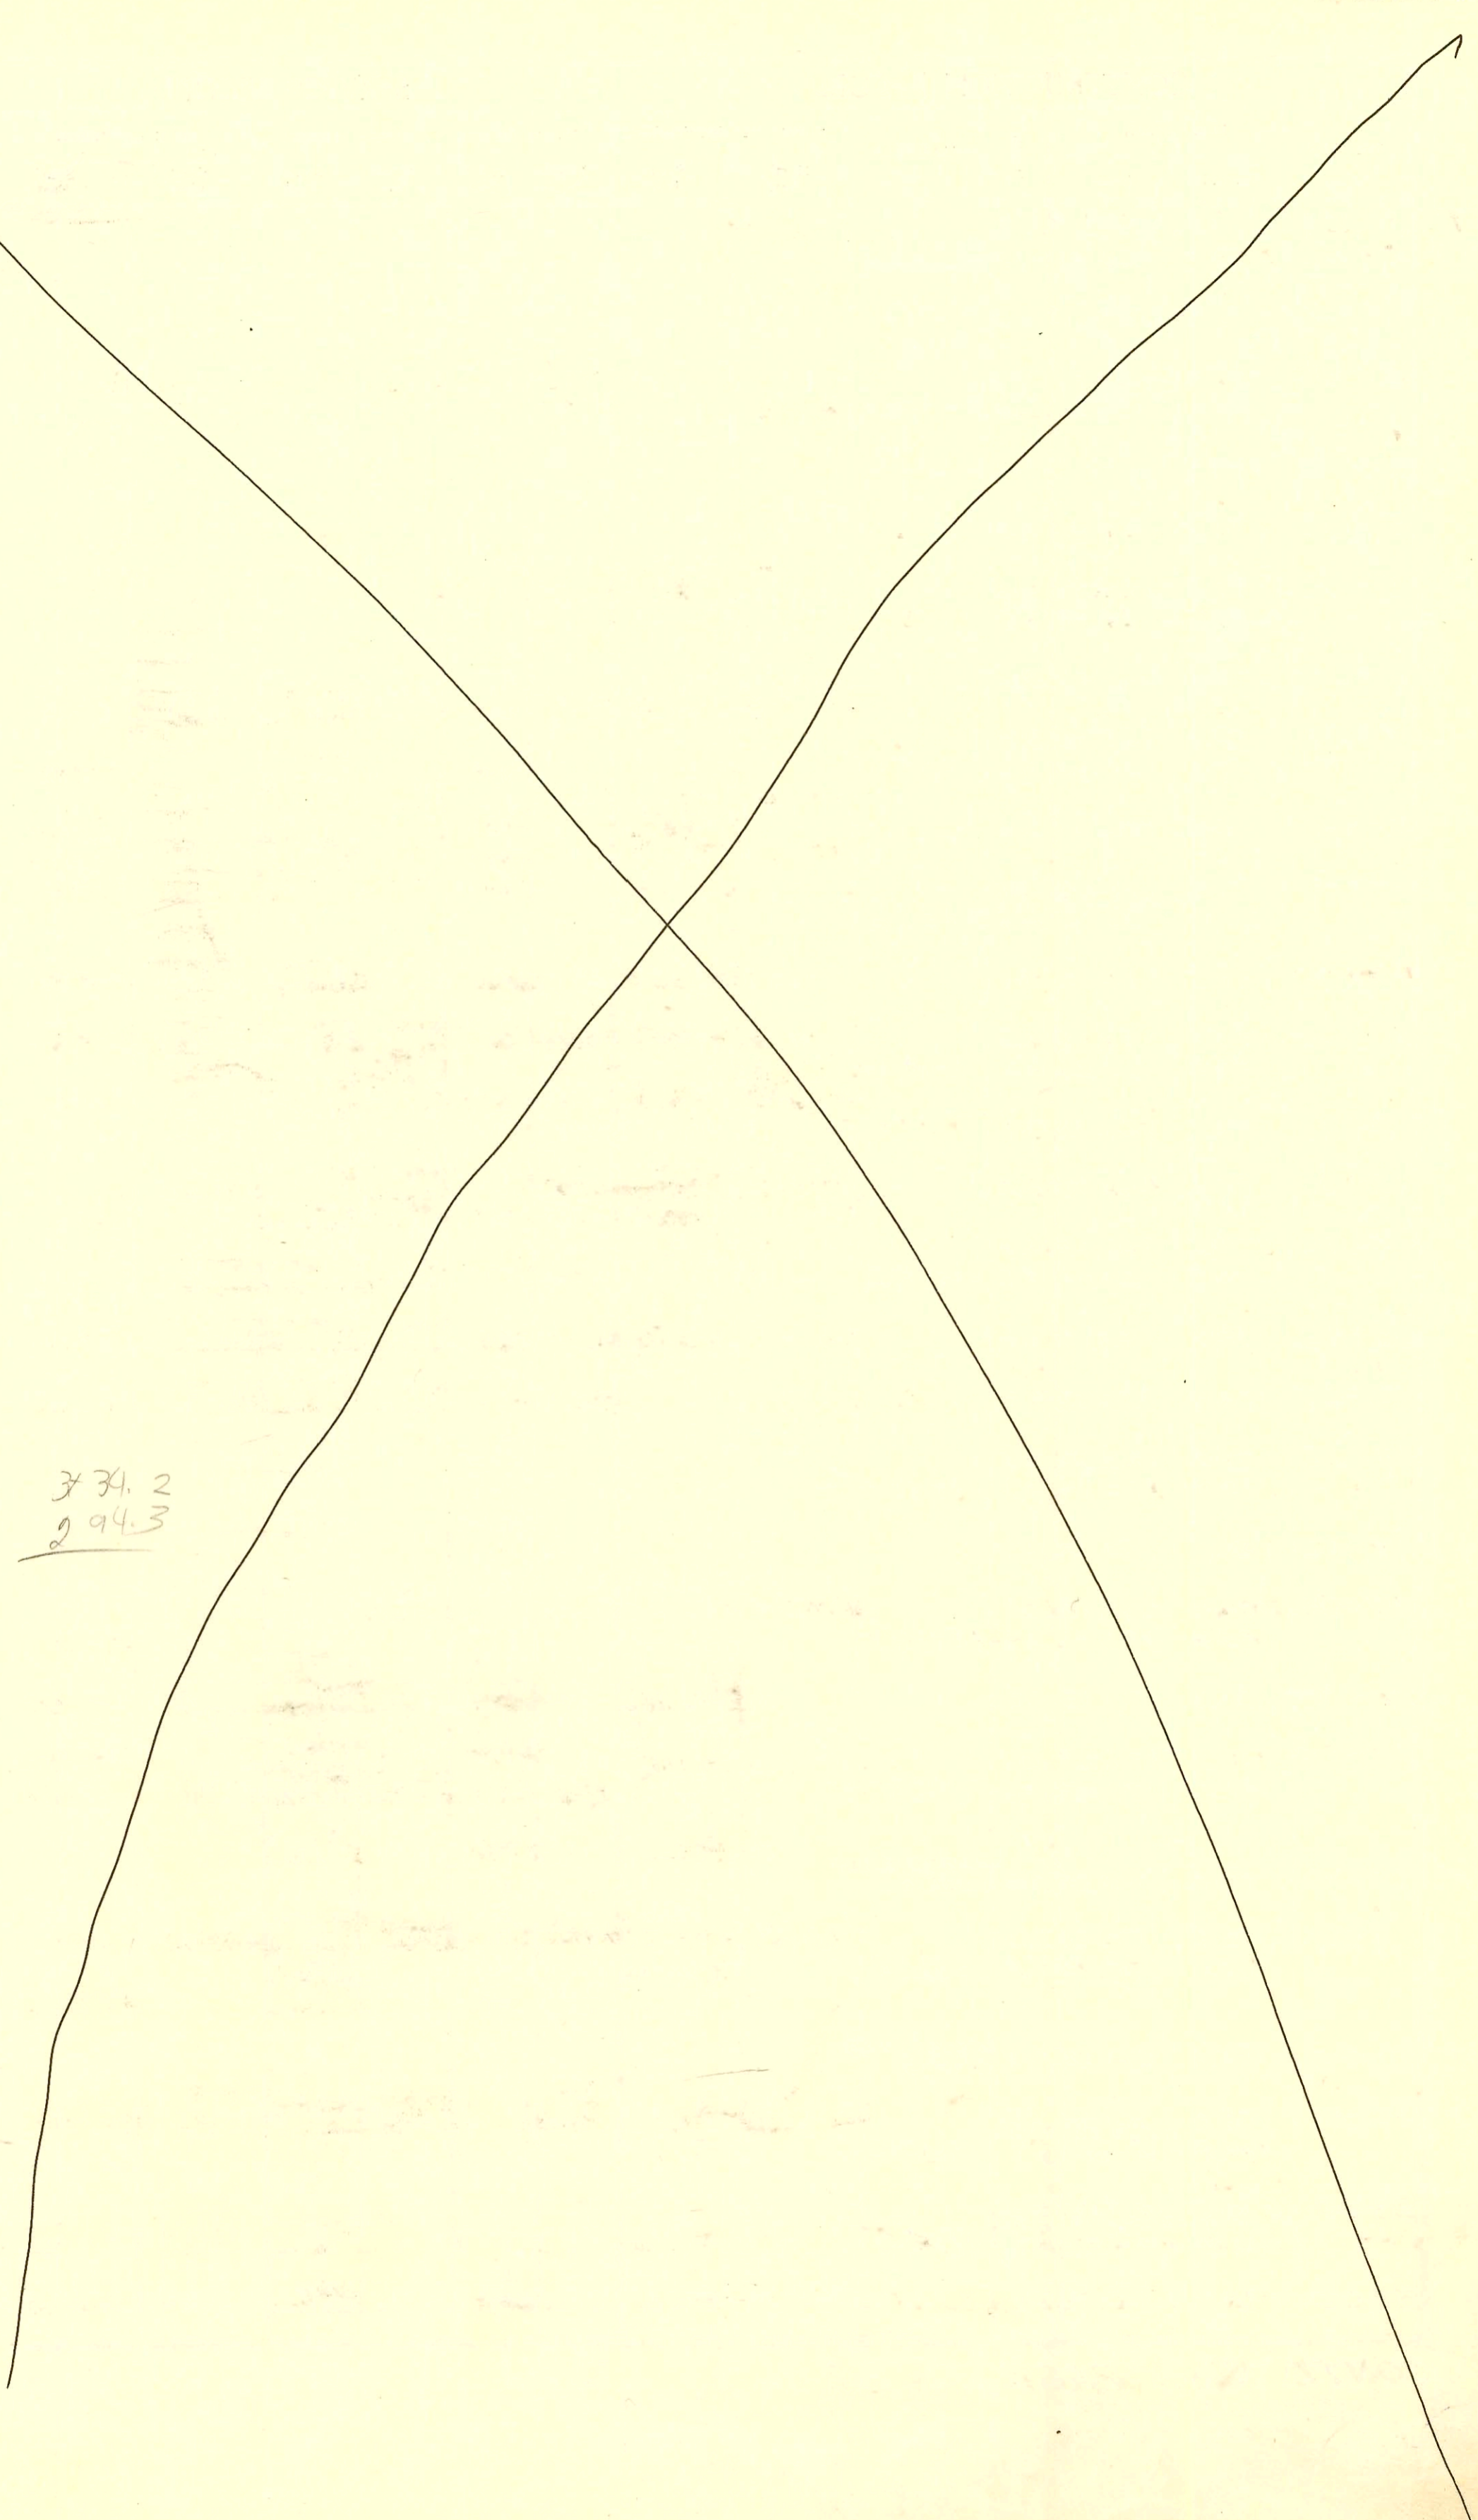

3734.2  
294.3