


CONSTRUCTION RECORD

SERVICE RECORD

STATION	ELEVATION		Depth	MANHOLE	4-INCH "Y" BRANCHES		No. of Permit		House Number		DATE OF PERMITS	
	Ground	Grade			North West	South East	North West	South East	North West	South East	North West	South East
LAT II MAIN 6 SS N ^o 23 CONT'D												
LANE 1 CONT'D	15+00	190.3	178.20	12.1								
		190.7	178.41	12.3	15+28.3	4" STUB N				6103	Croyden	10-5-79
	16+00	191.7	178.93	12.8								
	17+00	193.0	179.66	13.3								
		192.6	179.97	12.6	17+42.9	4" STUB NE				6109	Croyden	9-5-79
										6118	Croyden	9-5-79
										6121	Croyden	9-5-79
LINE 2	0+00	182.0	168.64	13.4								
		182.1	168.69	13.4								
			168.79	13.3	0+13.7							
			168.92	13.3								
		182.2	169.02	13.2	0+27.3							
	1+00	182.1	169.72	12.4								
		182.2	170.00	12.2								
			170.10	12.1	1+29.3							
					1+85.9	2+29.1						
	2+00	182.3	170.78	11.5								
		182.2	171.41	10.8								
			171.51	10.7	2+65.6	4" STUB E						
	3+00	182.1	171.84	10.3								
					3+87.0	3+30.0						
	4+00	184.0	172.80	11.2								
		184.6	173.46	11.1								
			173.56	11.0	4+68.0							
	5+00	184.7	173.86	10.8								
	6+00	184.4	174.82	9.6								
		187.1	175.68	11.4	6+89.2	4" STUB N						
LINE 2A	0+00	184.6	173.54	11.1	0+00=4+68	LINE 2						
		185.1	173.94	11.2	0+40.5	4" STUB SE						
LINE 3	0+00	182.3	170.11	12.2	0+00=1+29.3	LINE 2						
	1+00	184.3	171.02	13.3								
			171.12	13.2	1+01.4							
	2+00	185.0	171.96	13.0	1+91.9	4" STUB N						
LINE 3A	0+00	184.3	174.99	9.3	0+00=1+01.4	LINE 3						
		185.1	175.48	9.6	0+40.7	4" STUB SW						
LINE 4	0+00	180.7	169.46	11.2								
		180.8	169.53	11.3								
			169.63	11.2	0+17.4							
	1+00	181.6	170.37	11.2								
		181.0	170.79	10.2	1+47.5							
			170.89	10.1								
	2+00	181.2	171.31	9.9								
	3+00	181.5	172.24	9.3								
		182.0	172.61	9.4	3+39.9							
			172.71	9.3								
	4+00	182.3	173.27	9.0								
	5+00	183.0	174.20	8.8								
		183.0	174.36	8.6	5+17.4							
			174.46	8.5								
	6+00	183.5	175.23	8.3								
		184.2	175.55	8.7	6+34.0	4" STUB S						
LINE 4A	0+00	183.0	174.46	8.5	0+00=5+17.4	LINE 4						
		185.4	176.74	8.7	0+75.5	4" STUB SW						

R see next pg 12-18-01
9-5-79

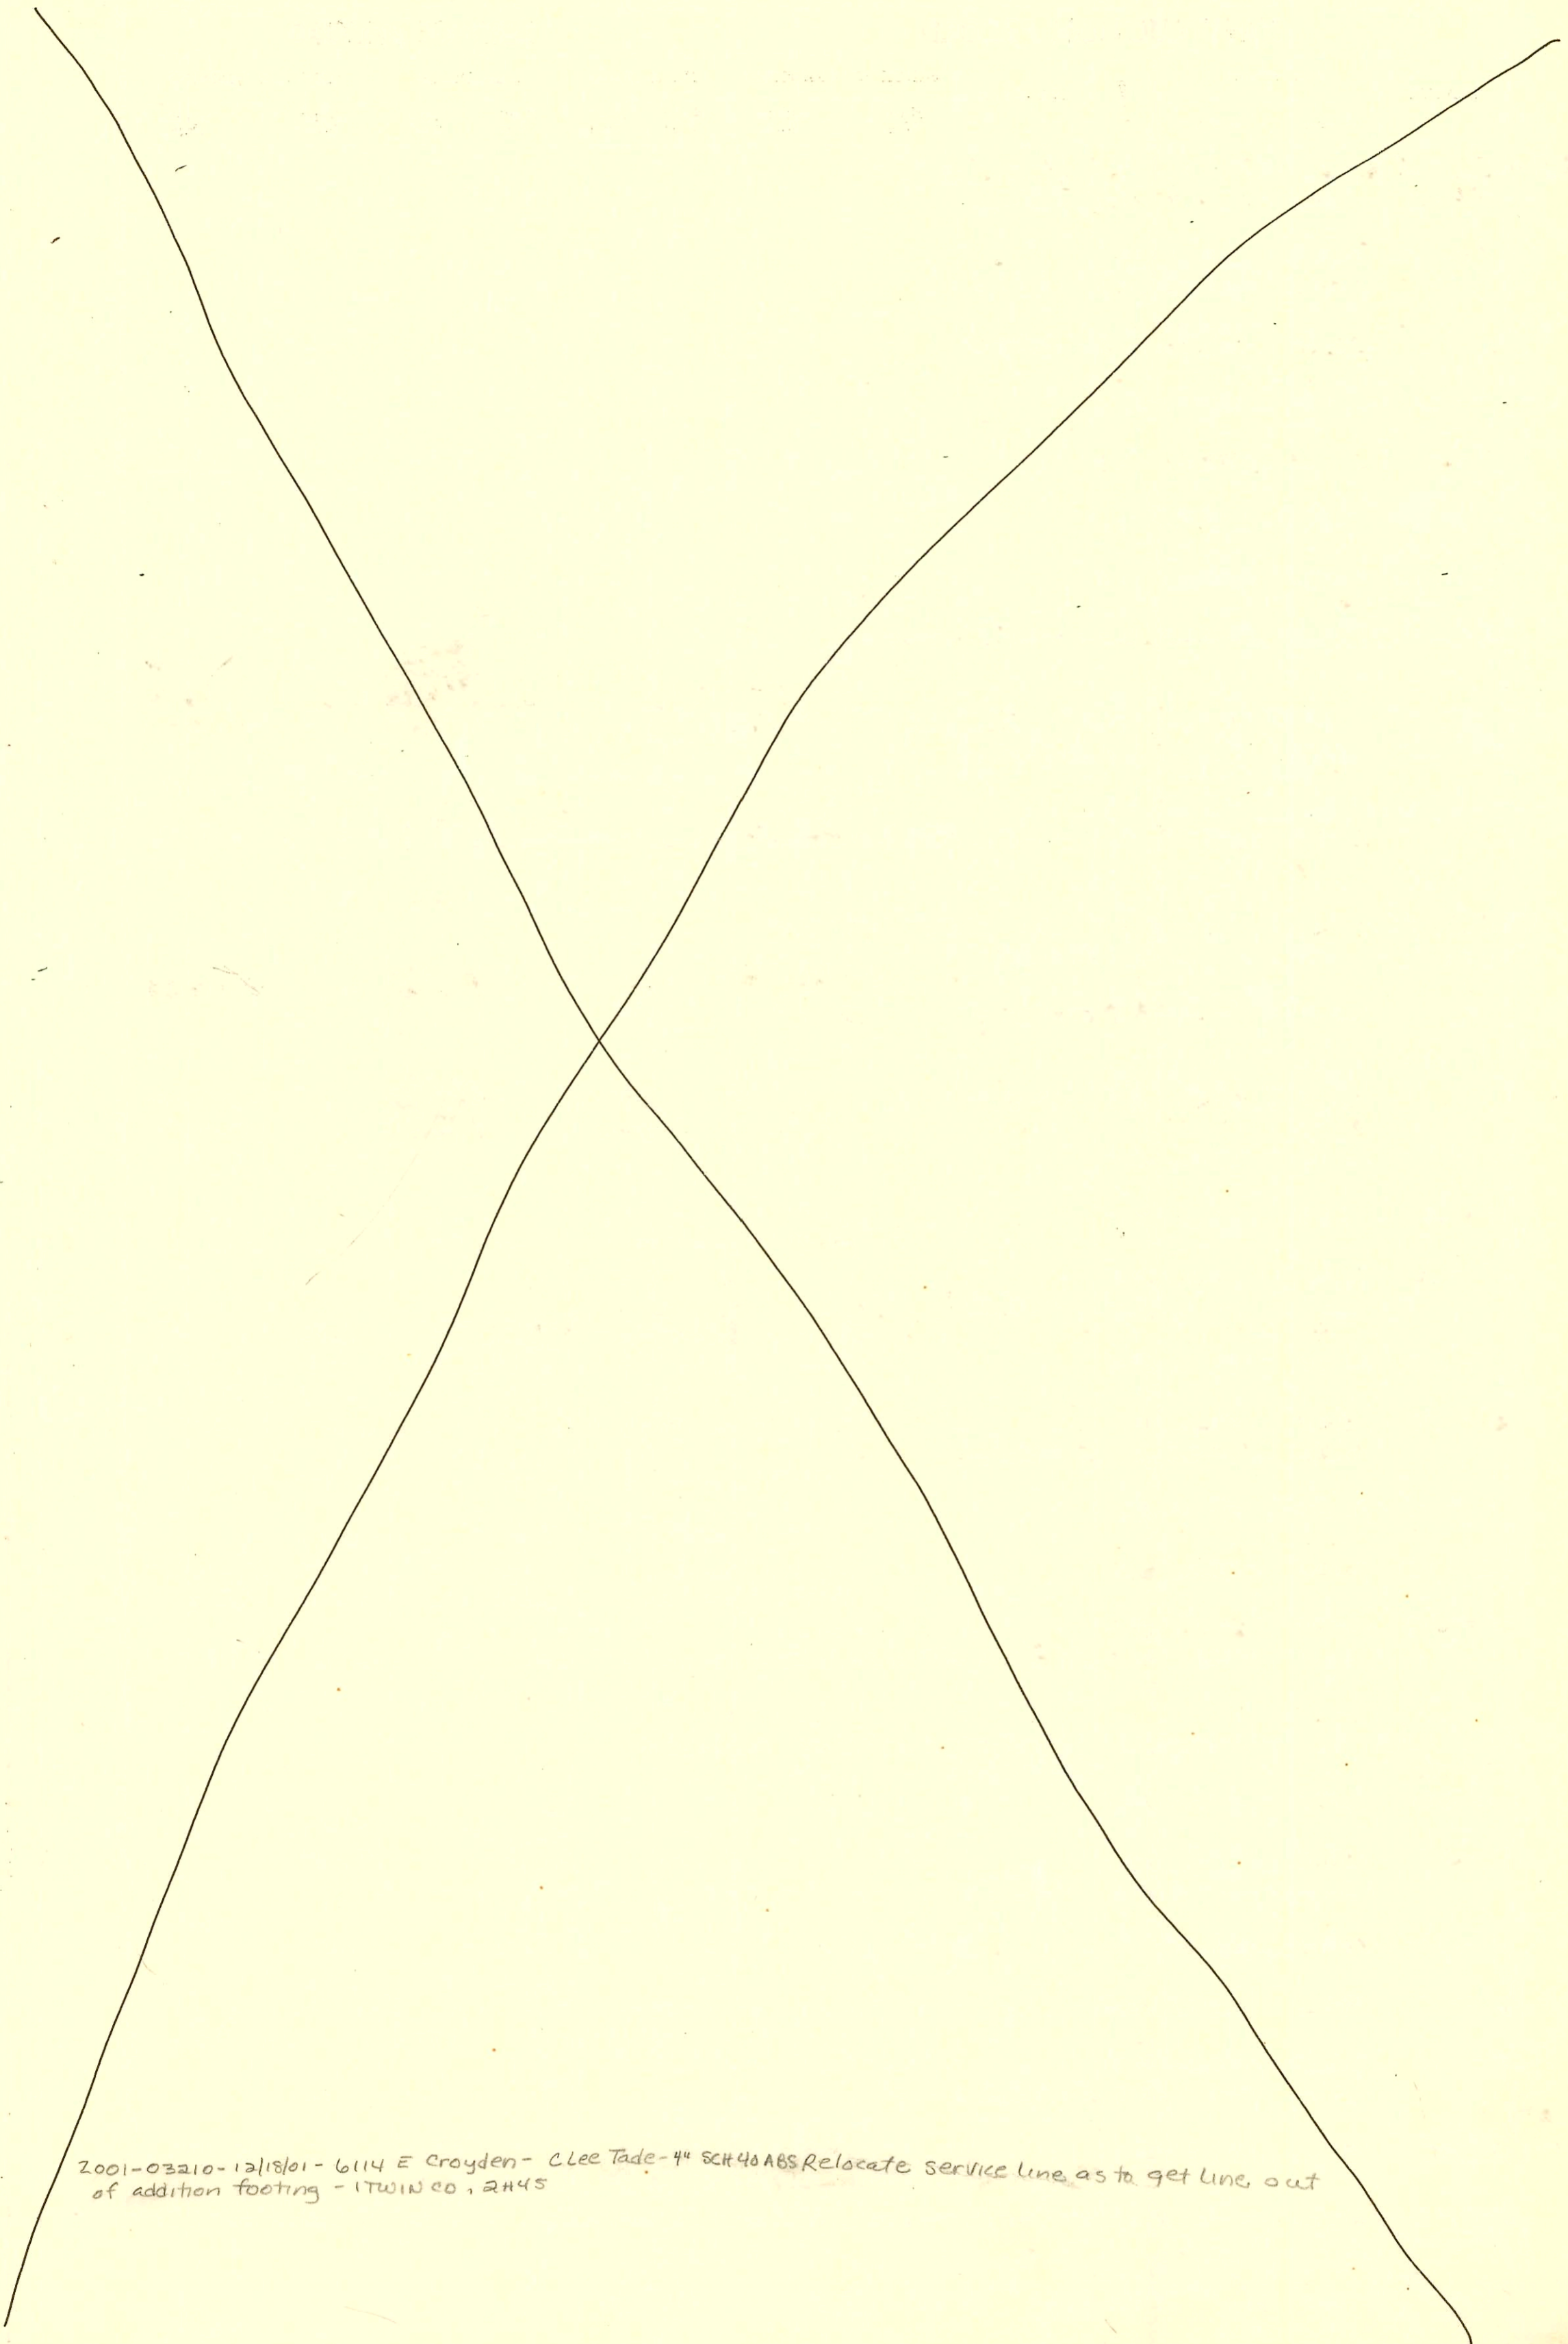

2001-03210-12/18/01 - 6114 E Croyden - C Lee Tade - 4" SCH 40 ABS Relocate service line as to get line out of addition footing - ITWIN CO, 2H45