




LATERAL 95 SOUTHWEST INTERCEPTOR SEWER
 BUILT BY: MID STATES CONST. CO.
 PROJ. N^o 468-76-245-80356-000-000-001
 BOOKED 9-1-79 FROM 264Y

on map

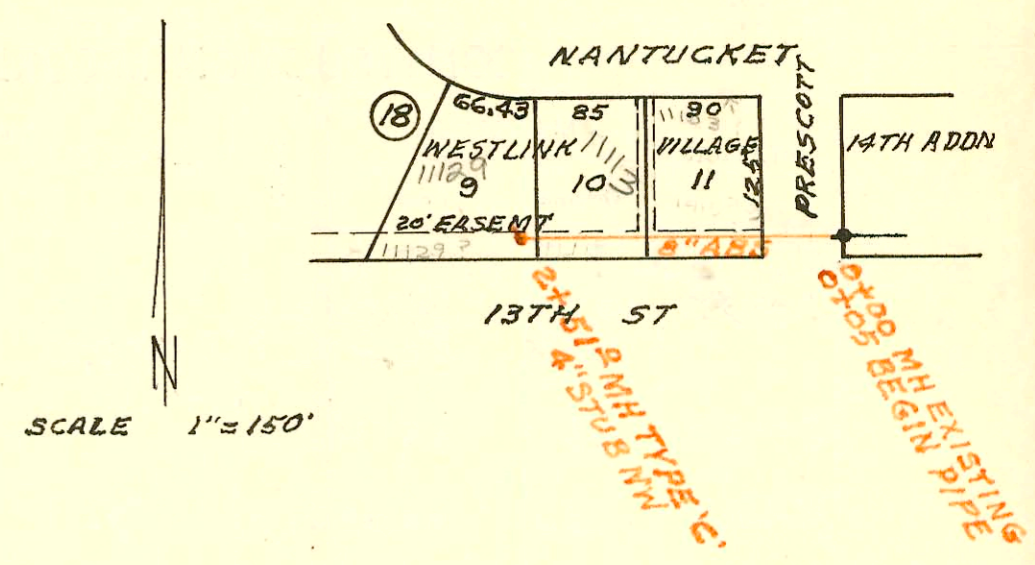


LATERAL 110 SOUTHWEST INTERCEPTOR SEWER
 BUILT BY: ARKANSAS CONST. CO.
 PROJ. N^o 468-76-245-80383-000-000-001
 BOOKED 9-4-79 FROM 264Y

on map

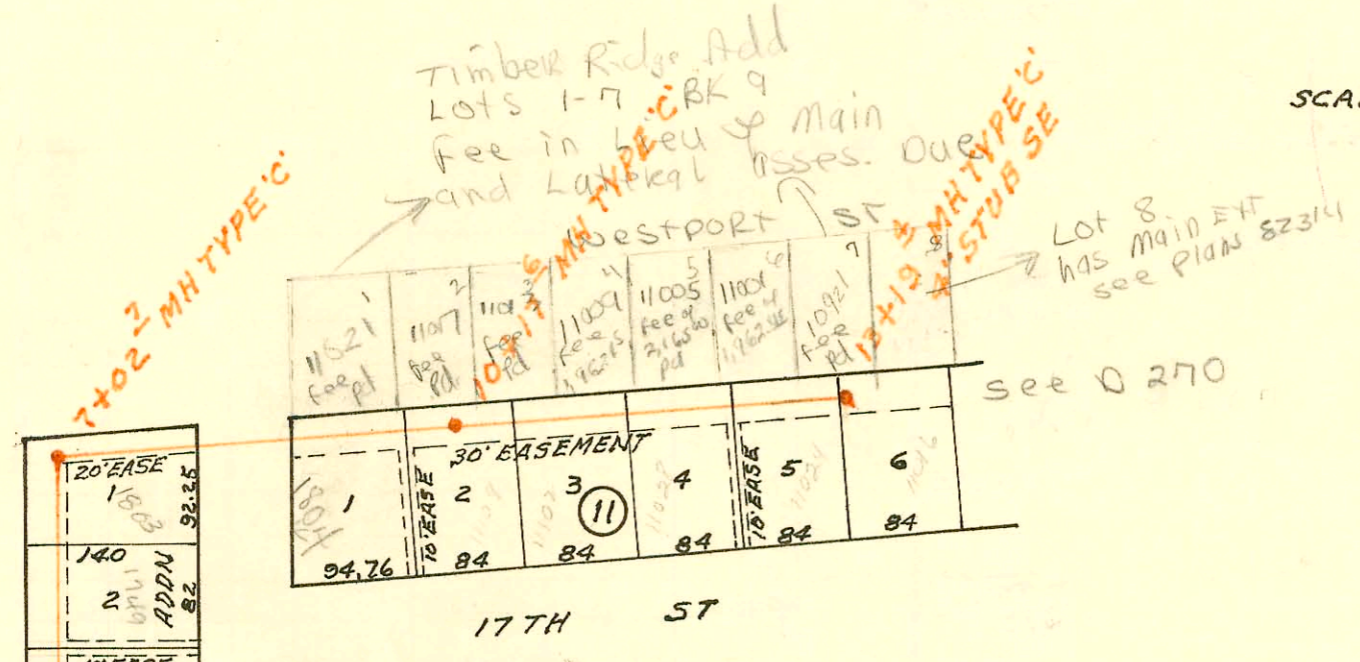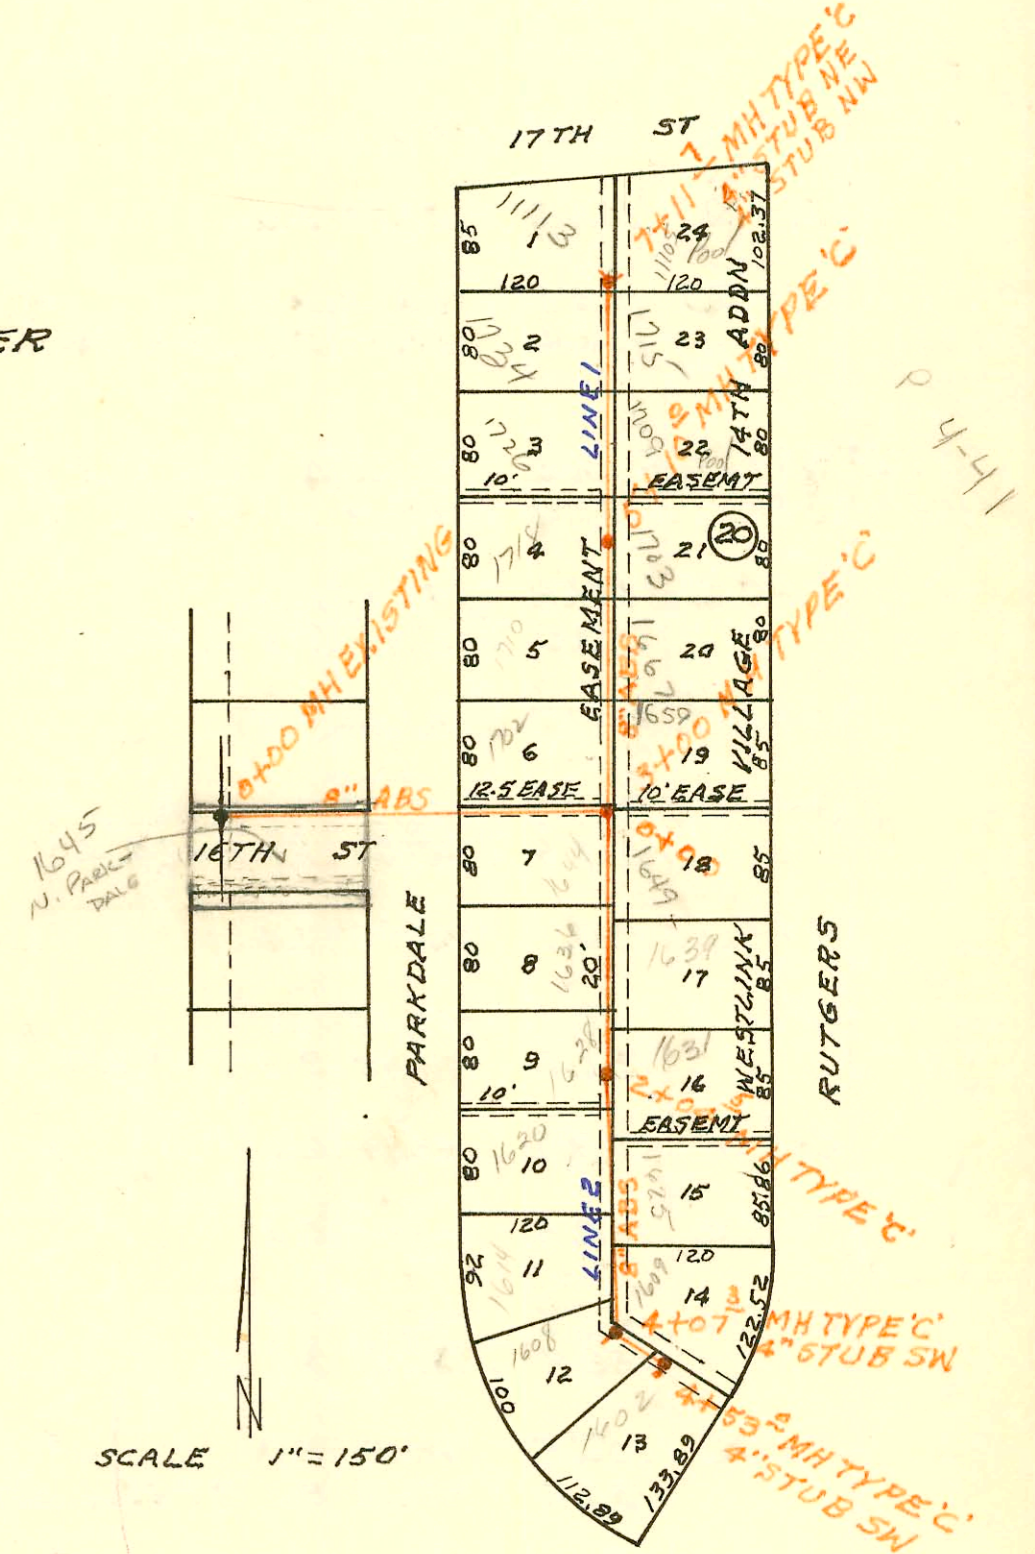

LATERAL 107 SOUTHWEST INTERCEPTOR SEWER
 BUILT BY: ARKANSAS CONST. CO.
 PROJ. N^o 468-76-245-80377-000-000-001
 BOOKED 9-5-79 FROM 264Y

on map

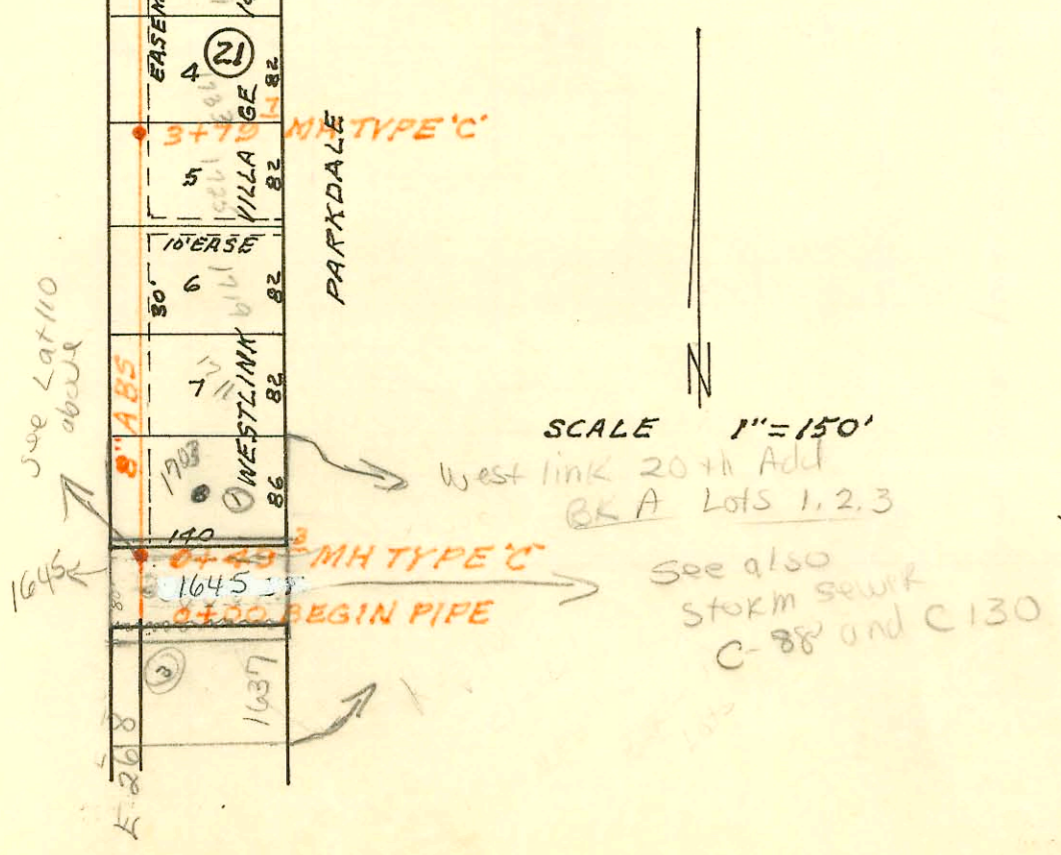

CONSTRUCTION RECORD

SERVICE RECORD

STATION	ELEVATION		Depth	MANHOLE	4-INCH "Y" BRANCHES		No. of Permit		House Number		DATE OF PERMITS			
	Ground	Grade			North West	South East	North West	South East	North West	South East	North West	South East	North West	South East
LAT 102 SWI (CONT'D)														
LINE 1 CONT'D 6+00	157.8	148.04	9.8											
	158.0	148.19	9.8	6+20.6	8" STUB W									
LINE 2														
0+00	156.6	141.08	15.5											
1+05	156.5	141.34	15.2											
LATERAL 95 SOUTHWEST INTERCEPTOR														
0+00	158.0	148.18	9.8	0+00	EXISTING									
0+05		148.22												
1+00	158.8	148.93	9.9	1+00.0		8121		11103	Nantucket		5-10-83			
2+00	158.5	149.68	8.8	2+16.0		8120		11113	Nantucket		5-10-83			
	158.7	150.06	8.6	2+51.0	4" STUB NN	81-200937		11129	Nantucket		5-20-91			
LATERAL 110 SOUTHWEST INTERCEPTOR SEWER														
LINE 1 0+00	153.5	147.52	6.0	0+00	EXISTING									
1+00	155.1	147.77	7.3											
2+00	157.1	148.02	9.1											
	159.3	148.27	11.0	3+00.0		3304	01821	170 Parkdale	1659 N Rutgers		5-14-81	11-7-80		
	148.37	148.37	10.9											
4+00	158.8	148.62	10.2	4+15.0		10088	01822	170 Parkdale	1667 N Rutgers		1-31-84	11-7-80		
5+00	158.3	148.87	9.4	5+06.0		8122	01823	1718 Parkdale	1703 N Rutgers		5-10-83	11-7-80		
	158.3	148.90	9.4	5+10.0										
6+00	158.2	149.12	9.1	6+10.0		4871	24614	1726 Parkdale	1709 Rutgers		12-8-81	1-11-90		
							9029				8-19-83			
7+00	157.6	149.37	8.2	7+11.7	STUB NW	1356	3224	1734 Parkdale	1715 Rutgers		9-24-80	4-30-81		
	157.6	149.40	8.2		STUB NE	2323	0245	11113 W. 17th	11105 W. 17th		1-9-81	1-16-81		
LINE 2 0+00	159.3	148.37	10.9	0+00=3+00	Line 1	4" 40-ferroc (no other work)	2004-00366	1649 N R Rutgers			2(12)4	11-7-80		
						0+39.0	01820							
1+00	159.5	148.62	10.9	1+57.0		10087		1644 Parkdale			1-31-84			
2+00	159.7	148.87	10.8	2+04.5		1114.5	8278	1636 Parkdale	1639 Rutgers		6-2-83	6-1-83		
	159.7	148.88	10.8			1+99.0	01822	1628 Parkdale			8-29-83			
3+00	159.7	149.12	10.6	3+05.8		1056	7804	1620 Parkdale	1625 Rutgers		8-22-80	4-10-83		
4+00	159.5	149.37	10.1	4+07.3	4" STUB SW	9364	8982	1614 Parkdale	1608 Rutgers		10-4-83	8-15-83		
	159.5	149.49	10.0											
	159.5	149.60	9.9	4+53.0	4" STUB SW		11511	1607 Parkdale			7-18-84			
LATERAL 107 SOUTHWEST INTERCEPTOR SEWER														
LINE 1 0+00	154.2	147.30	6.9	0+49.3		709 200 1/2	26160	1645 Parkdale			9-19-90			
	165.8	147.42	18.4			114 6 1/2								
	165.8	147.52	18.3			0+99.9	3303	1703 N Parkdale			5-14-81			
1+00	153.5	147.55	6.0											
2+00	153.0	147.80	5.2			2+00.9	3305	1711 N Parkdale			5-14-81			
						2+86.9	1825	1719 N Parkdale			11-7-80			
3+00	153.0	148.05	5.0	3+79.7		3+31.4	3306	1725 N Parkdale			5-14-81			
	153.3	148.25	5.1											
4+00	153.2	148.30	4.9			4+09.3	1827	1733 N Parkdale			11-7-80			
5+00	153.4	148.55	4.9			5+24.3	1824	1739 N Parkdale			11-7-80			
						5+91.7	1825	1749 N Parkdale			11-7-80			
6+00	154.2	148.80	5.4			6+87.1	1826	1803 N Parkdale			11-7-80			

CONT'D NEXT PAGE