
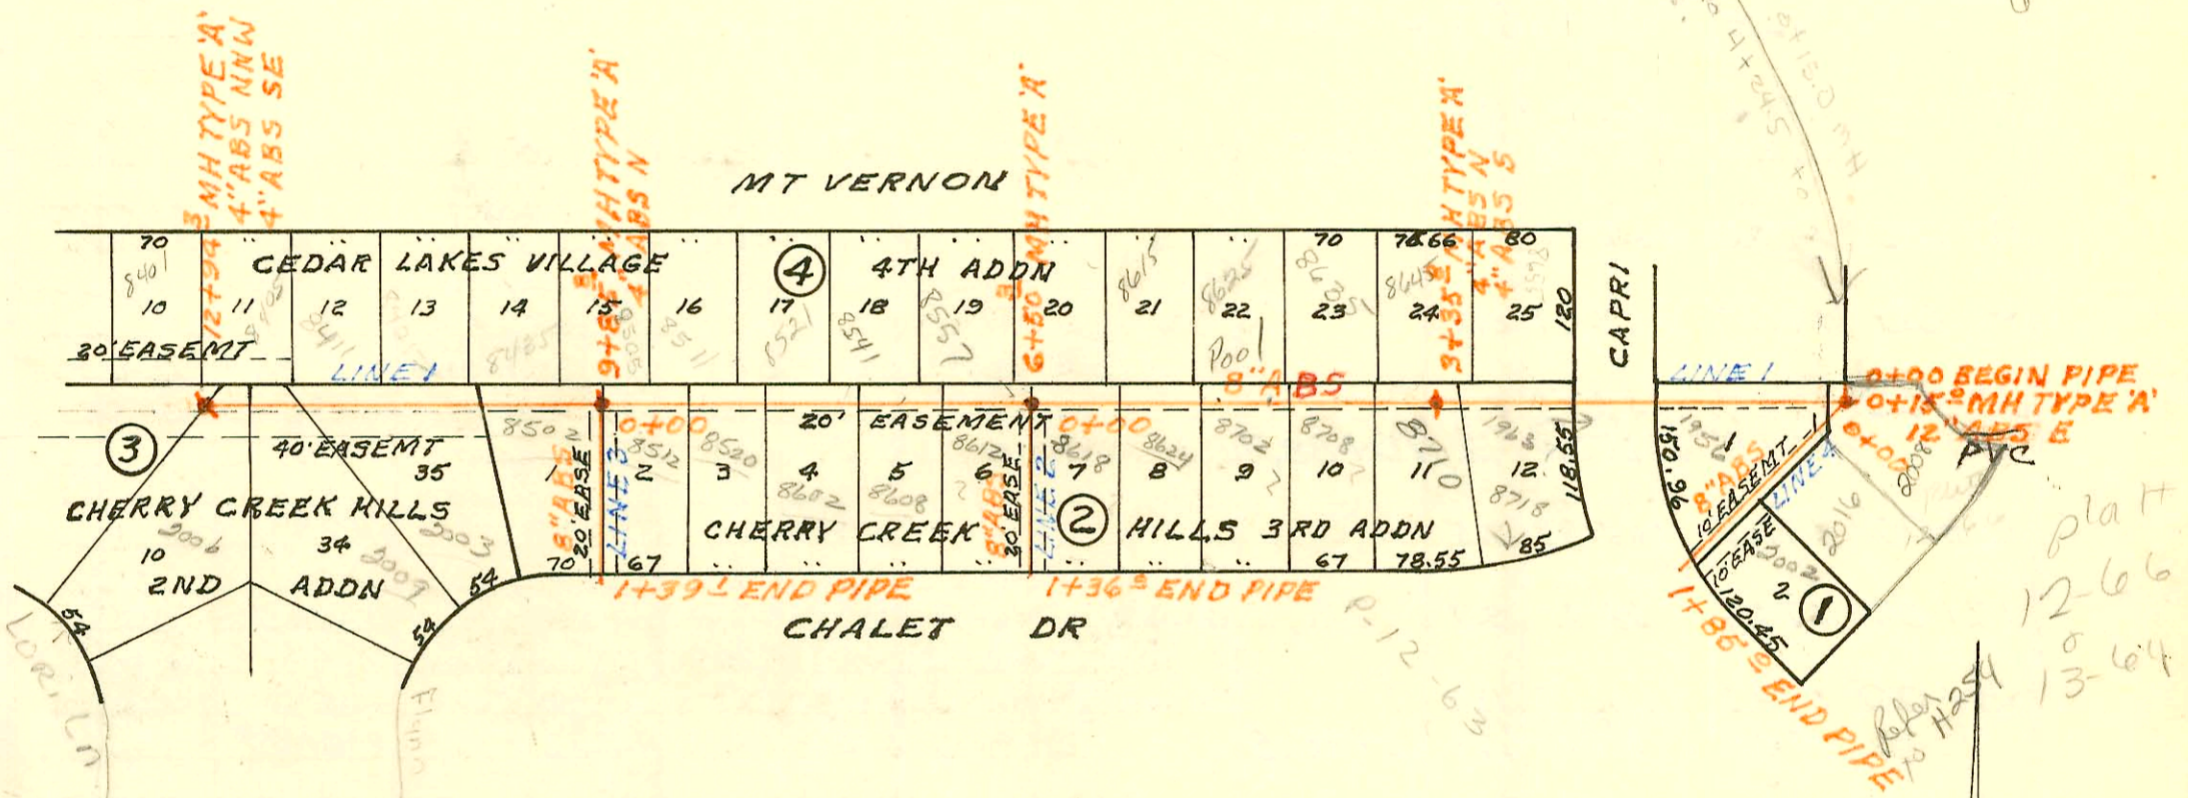


LATERAL 5 MAIN 21 WAR INDUSTRIES SEWER
BUILT BY: ARKANSAS CONST. CO.
PROJ. N^o 468-76-245-80180-000-000-001
BOOKED 9-8-79 FROM JLA 28

on map

SCALE 1" = 150'

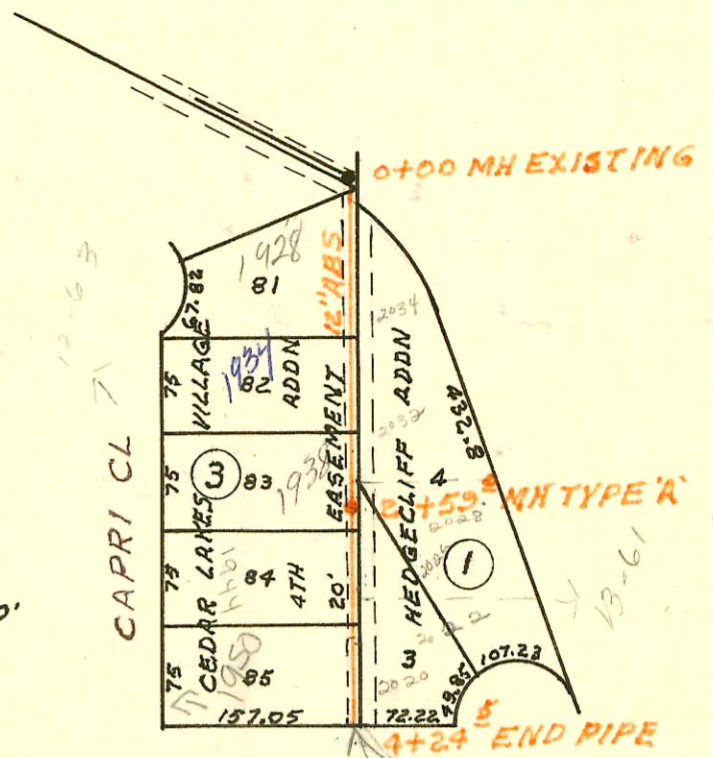

LATERAL 6 MAIN 21 WAR INDUSTRIES SEWER
BUILT BY: ARKANSAS CONST. CO.
PROJ. N^o 468-76-245-80181-000-000-001
BOOKED 9-11-79 FROM JLA 28

on map

SCALE 1" = 150'

Plat
12-66
13-64

