
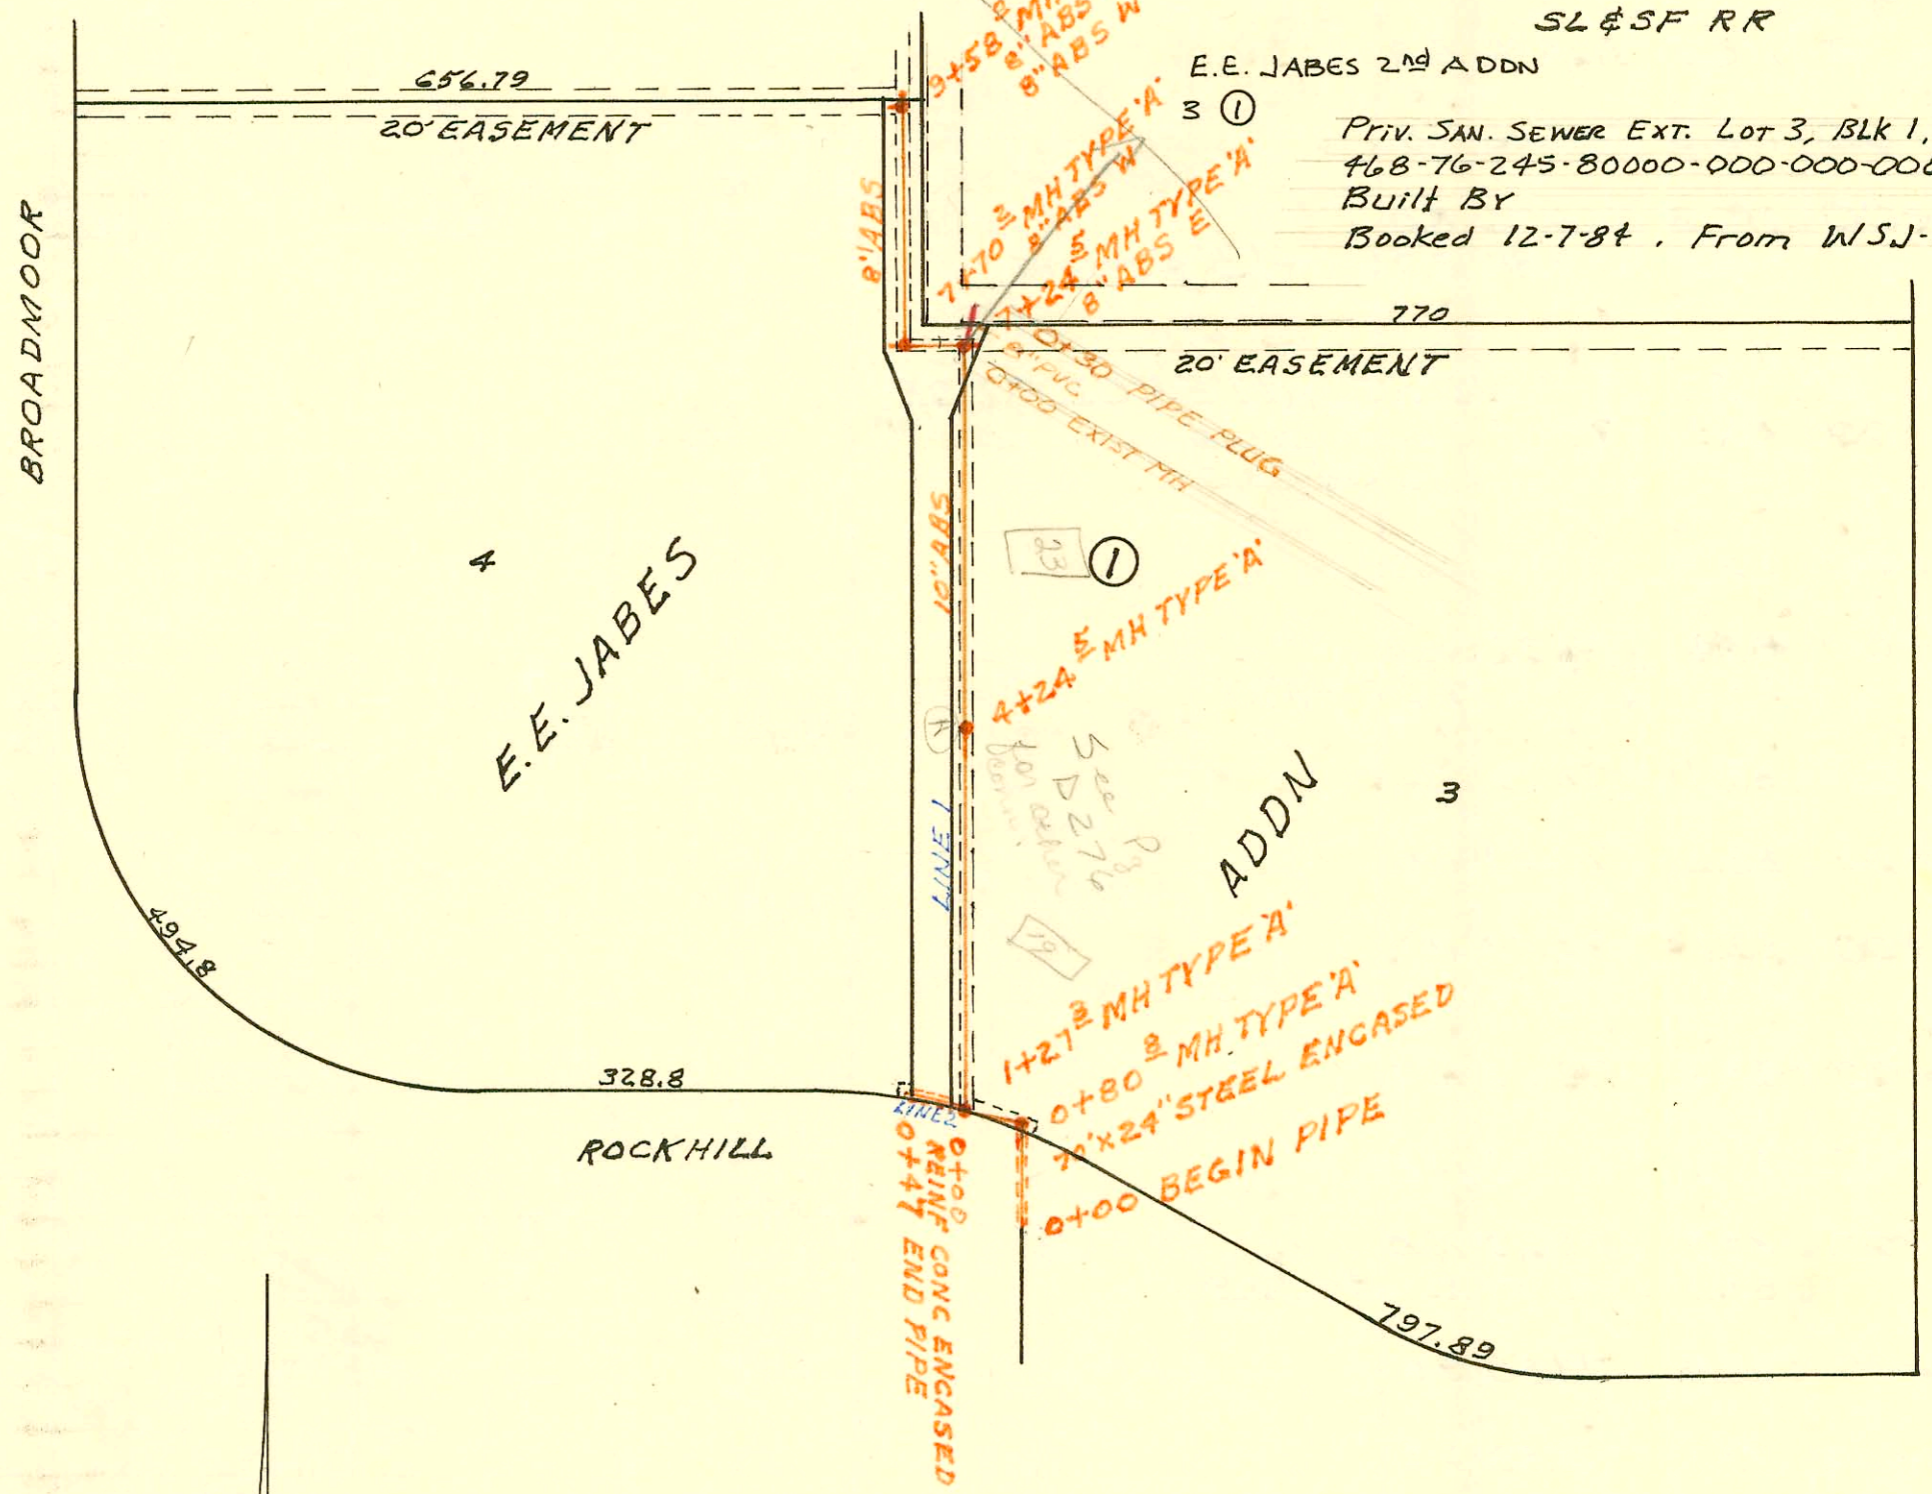


LATERAL 2 MAIN 20 WAR INDUSTRIES SEWER
BUILT BY: UTILITY CONTR. INC.
PROJ. NO 468-76-245-80155-000-000-001
BOOKED 9-15-79 FROM MRT 24

on map p 38

SCALE 1"=150'

Plat 12-38

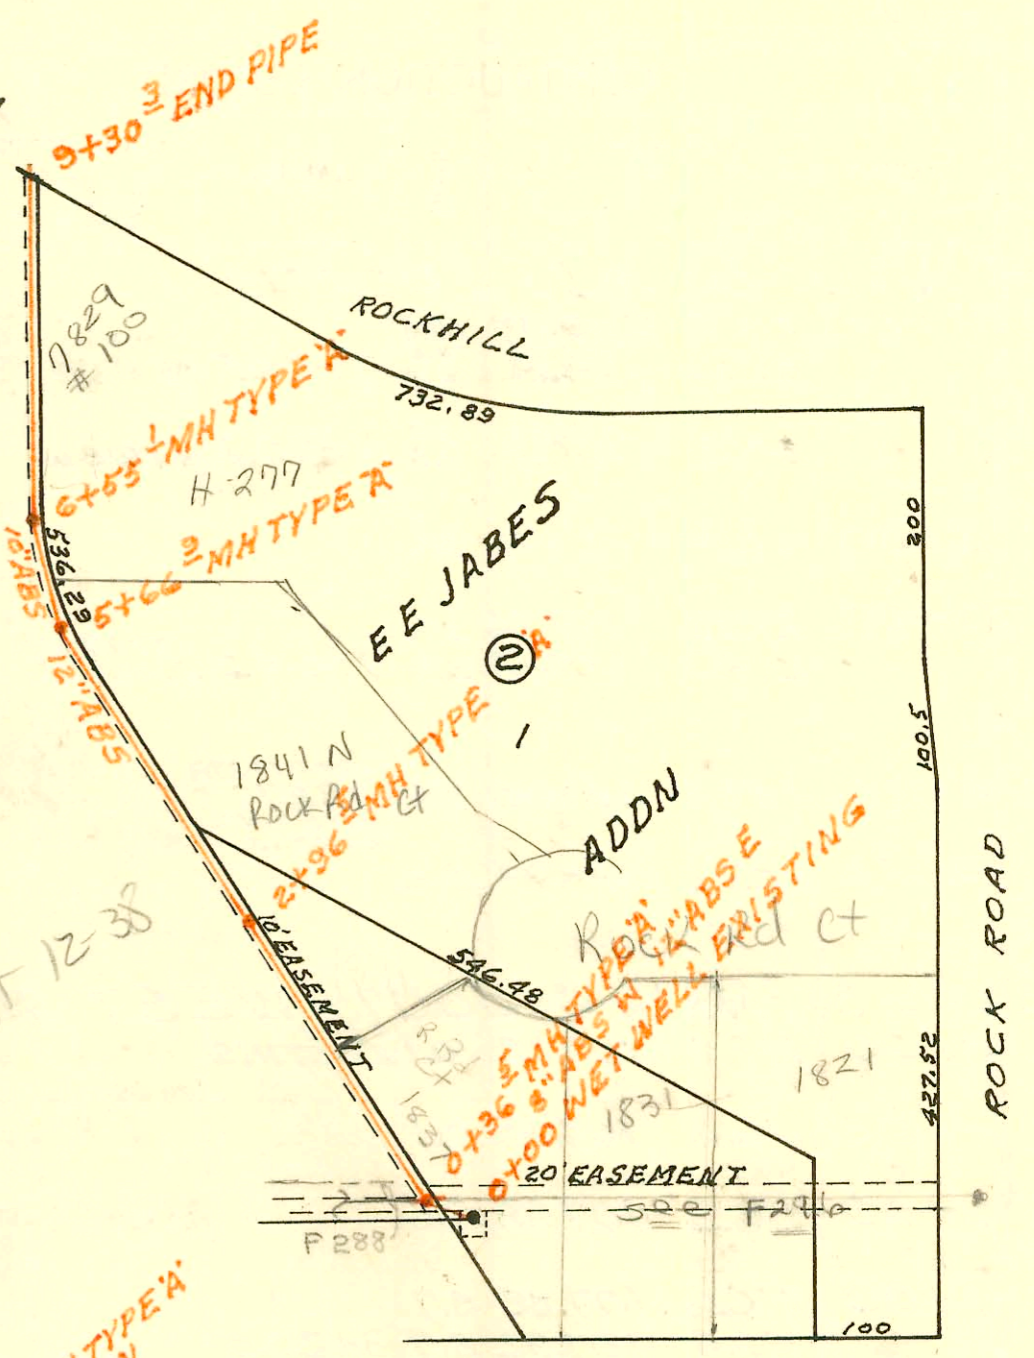

SL & SF RR
E.E. JABES 2ND ADDN
3 ①
Priv. SAN. SEWER EXT. Lot 3, BLK 1, EE JABES 2nd
468-76-245-80000-000-000-008
Built By
Booked 12-7-84, From WSJ-04A

SCALE 1"=150'

LATERAL 4 MAIN 20 WAR INDUSTRIES SEWER
BUILT BY: UTILITY CONTR. INC.
PROJ. NO 468-76-245-80157-000-000-001
BOOKED 9-19-79 FROM MRT 24

on map p 38

CONSTRUCTION RECORD

SERVICE RECORD

STATION	ELEVATION		Depth	MANHOLE	4-INCH "Y" BRANCHES		No. of Permit		House Number		DATE OF PERMITS			
	Ground	Grade			North West	South East	North West	South East	North West	South East	North West	South East	North West	South East
LAT 7 MAIN 21 WIS (CONT'D)														
LINE 2 CONT'D 4+00	173.7	163.13	10.6			4+26.9	1781			8631		11-7-80		
	174.0	163.41	10.6	4+10.9	4+66.5	4+96.8	3323			8635	5-15-81	11-6-80		
5+00	175.3	164.80	10.5	5+01.8	4" STUB SW	4" STUB SE 4" STUB SW	273918	1745	8606	Cherry Creek		8-27-79		
LINE 3														
0+00	171.2	161.43	9.8	0+00										
	171.3	162.02	9.3	0+50.0										
1+00	174.7	162.72	12.0		1+04.0	1+39.6	670	275075	2012	2002		3-16-82		
					1+81.0	1+68.2	275229	1967	2018	2021	7-1-80	10-29-79		
2+00	176.3	164.17	12.1		2+40.6		274640		2024	2013	11-6-79	11-26-80		
	176.7	164.83	11.9	2+45.6					2028	2029	10-4-79			
3+00	177.3	165.29	12.0		2+89.1		274641		2028	2029	10-4-79			
						3+14.1		3764	2029	2035		7-23-81		
						3+83.0		5028	2034	2035		1-6-82		
4+00	177.3	166.06	11.2		4+09.4		272007		2039	2041	5-25-79			
	177.3	166.50	10.8	4+43.8	4+56.8		272008		2039	2041	5-25-79			
					4+87.8	4+89.8	272009	5374	2041	2041	5-25-79	3-16-82		
5+00	177.4	166.93	10.5		5+37.8	5+80.4	274700	6890	2054	2049	10-5-79	11-1-82		
								4719	2054	2055		11-13-81		
6+00	177.7	167.70	10.0			4" STUB SE 4" STUB SW	274701		2054	2054		10-5-79		
	177.7	167.85	9.9	6+19.8										
LATERAL 2 MAIN 20 WAR INDUSTRIES SEWER														
0+00	201.6	187.27	14.3	0+06 EXISTING WET WELL										
	197.7	188.93	8.8	0+36.5	8" STUB W	12" STUB E								
1+00	198.0	189.06	8.9					8294		1837 T. Rock Rd		6-2-83		
2+00	199.0	189.26	9.7											
	199.3	189.46	9.8	2+96.5										
3+00	199.3	189.46	9.8				4" SCH 40 3764.5 Predco	1999-00112		1841 S Rock Rd		7-6-99		
4+00	200.4	189.66	10.7											
5+00	200.3	189.86	10.4											
	199.8	189.99	9.8	5+66.9										
	199.8	190.11	9.7											
6+00	200.5	190.61	9.9				4" SCH 40 7794.7 Predco	97-10995-7		1829 Rock Rd	#100	5-27-99		
	200.9	191.44	9.5	6+55.1										
	200.9	191.54	9.4											
7+00	202.2	192.21	10.0											
8+00	203.9	193.71	10.2											
9+00	206.5	195.21	11.3											
9+30.3	206.9	195.66	11.2	END PIPE										
LATERAL 4 MAIN 20 WAR INDUSTRIES SEWER														
LINE 1 0+00	207.1	195.66	11.4	BEGIN PIPE										
	207.0	196.95	10.1	STEEL ENCASED										
	207.0	197.05	10.0	0+80.8										
1+00	207.5	197.32	10.2											
	207.3	197.74	9.5	1+27.3										
2+00	207.2	198.24	9.0											
3+00	208.1	198.79	9.3				3+27.5	273776		1945 N Rock Rd	19	8-21-79		
4+00	208.8	199.34	9.5											
	208.8	199.47	9.3	4+24.5										
5+00	209.0	199.89	9.1											
6+00	210.2	200.44	9.8				6+04.5	273780		1945 N Rock Rd	23	8-21-79		

CONT'D NEXT PAGE

PRIV. SAN. SEW. EXT. FOR LOT 3, BLK 1, E.E. JABES 2ND ADDN.
 0+00 211.50 201.40 10.2 0+00 EXIST.
 0+30 201.60 201.60 PUG. 0+30
 Refer to MIT 7124.5 on page 0-277