


LATERAL 27 MAIN 17 WAR INDUSTRIES SEWER
BUILT BY: MID STATES CONST. CO.
PROJ. N^o 468-76-245-80536-000-001
BOOKED 10-6-79 FROM SRL 6

on map
13-61


SCALE 1"=150'

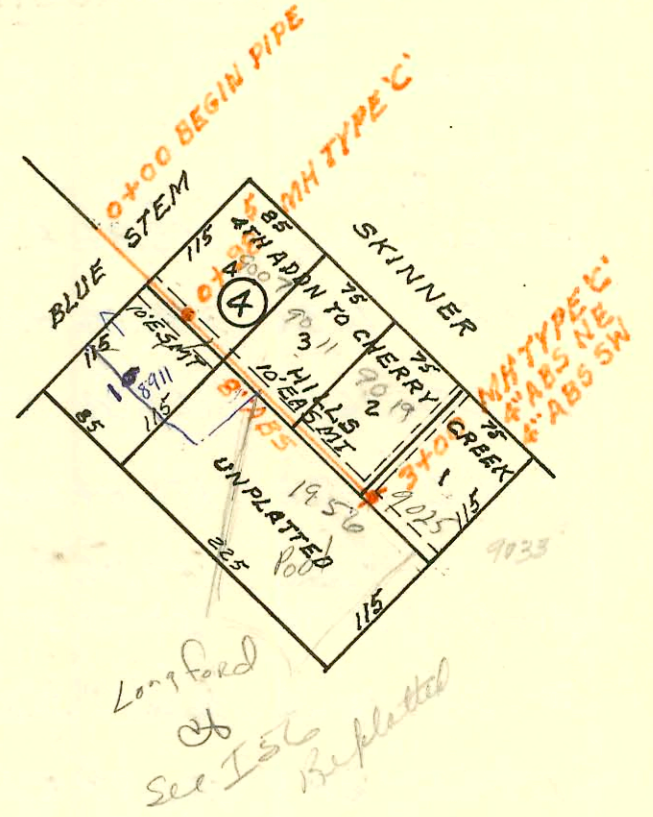

LATERAL 28 MAIN 17 WAR INDUSTRIES SEWER
BUILT BY: MID STATES CONST. CO.
PROJ. N^o 468-76-245-80567-000-000-001
BOOKED 10-9-79 FROM SRL 1


on map

SCALE 1"=150'

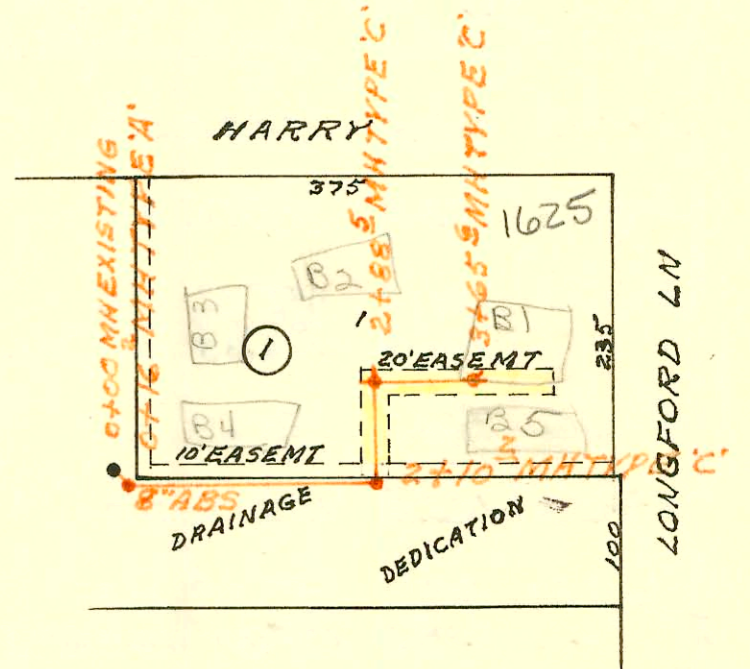

LATERAL 29 MAIN 17 WAR INDUSTRIES SEW
BUILT BY: MID STATES CONST. CO.
PROJ. N^o 468-76-245-80696-000-000-001
BOOKED 10-10-79 FROM SRL 10

SCALE 1"=150'

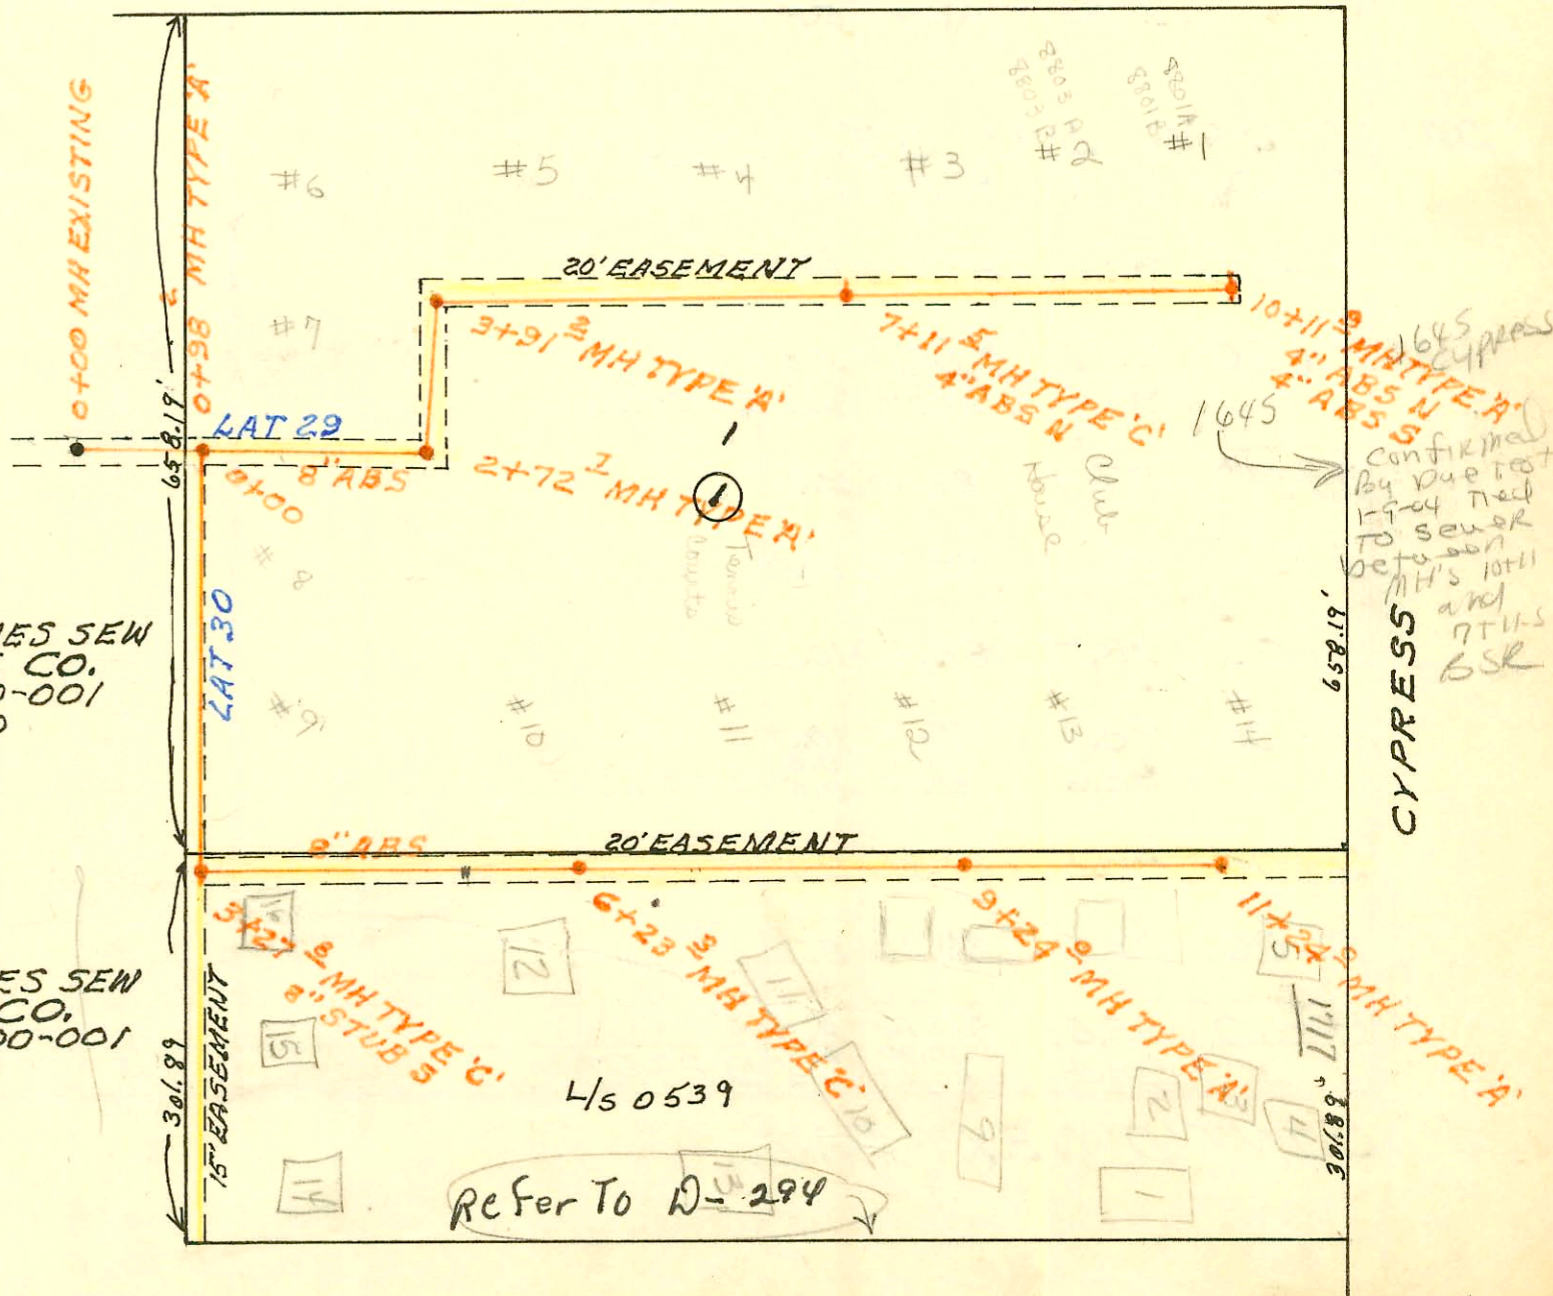

LATERAL 30 MAIN 17 WAR INDUSTRIES SEW
BUILT BY: MID STATES CONST. CO.
PROJ. N^o 468-76-245-80697-000-000-001
BOOKED 10-10-79 FROM SRL 10

on map
13-61

Refer To D-294

CONSTRUCTION RECORD

SERVICE RECORD

STATION	ELEVATION		Depth	MANHOLE	4-INCH "Y" BRANCHES		No. of Permit		House Number		DATE OF PERMITS	
	Ground	Grade			North West	South East	North West	South East	North West	South East	North West	South East
LAT 26 MAIN 17 WIS (CONT'D)												
LINE 1 CONT'D 5+00	167.7	154.96	12.7		5+08.6	5+64.6	2651	3397	8903 E	8924	2-23-81	6-1-81
6+00	167.9	155.36	12.5		5+55.6	5+65.6	2652	3398	8905 E	8926	2-23-81	6-1-81
7+00	168.4	155.76	12.6		5+91.9	6+35.9	5162	3768	8935	9007	2-2-82	7-23-81
8+00	168.1	156.16	11.9		6+27.5	6+79.5	5163	3732	8957 E	9006	2-2-82	7-23-81
9+00	167.8	156.96	10.8		7+10.8		2521		8957 E		2-2-81	
10+00	168.7	157.77	10.9	7+15.5	7+12.8	7+47.5	02522	4112	8959 E	9012	2-2-81	9-11-81
11+00	168.9	158.88	10.0		7+76.5	7+69.6	#673	4111	8965	9014	7-1-80	9-11-81
11+74.5	168.7	159.54	9.2		8+21.5		#674		8967		7-1-80	
11+74.5	168.0	156.42	11.6	8+38.8	8+57.4		#156		9009 E		4-24-80	
9+00	168.7	157.91	10.8	9+90.9	8+97.4		#157		9011 E		4-24-80	
10+00	169.0	157.99	11.0		9+00.8		672		9022	Bluestem		7-1-81
11+00	168.9	158.88	10.0		9+35.0		#261		9019		5-8-80	
11+74.5	168.7	159.54	9.2		9+80.9	9+56.6	262	#671	9020	Bluestem	5-8-80	7-1-80
11+74.5	168.7	159.54	9.2		10+07.4	10+02.8	#154	#00775	9029		4-24-80	7-18-80
11+74.5	168.7	159.54	9.2		10+48.5	10+09.5	#155	#00776	9031	Bluestem	4-24-80	7-16-80
11+74.5	168.7	159.54	9.2		11+03.9	11+08.9	#01434	#01437	9037	Bluestem	10-7-80	10-7-80
11+74.5	168.7	159.54	9.2		11+05.9	11+09.5	#01435	#01436	9037	Bluestem	10-7-80	10-7-80
LINE 2												
0+00	168.1	158.34	9.8	0+00=4+24.8								
1+14	169.4	158.80	10.6	LINE 1								
LINE 3												
0+00	168.4	158.23	10.2	0+00=7+15.5								
1+29	169.0	158.75	10.3	LINE 1								
LATERAL 27 MAIN 17 WAR INDUSTRIES SEWER												
0+00	169.3	158.80	10.5									
1+00	170.0	159.20	10.8	0+98.5	0+89.5	0+89.5	1160		9007 E	Skinner		9-8-80
2+00	170.5	159.60	10.9		1+17.5		7255		8911 E	Bluestem	12-27-82	
3+00	169.7	160.00	9.7	3+00.04	1+87.5		1161		9011	Skinner		9-8-80
3+00	169.7	160.00	9.7	3+00.04	2+15.0		16883		1956	Longford	8-13-86	
3+00	169.7	160.00	9.7	3+00.04	2+50.1		13716	959	1956	Longford	5-7-85	8-12-80
3+00	169.7	160.00	9.7	3+00.04			3192		9019	Skinner		4-28-81
3+00	169.7	160.00	9.7	3+00.04					9025	Skinner		4-28-81
LATERAL 28 MAIN 17 WAR INDUSTRIES SEWER												
0+00	153.5	144.36	9.1	0+00 EXISTING								
1+00	155.3	144.86	11.0	0+16.2	1+28.6		275929		1625 #4	Longford	1-4-80	
2+00	154.8	145.26	9.5	2+10.2	1+67.2		275930		1625 #4	Longford	1-4-80	
2+00	154.7	145.40	9.3	2+10.2					1625 #3	Longford	1-4-80	3-7-80
3+00	151.5	145.84	5.7	3+65.6	2+88.5	6" STUB N 6" STUB W	2001-03027		1625 #1	Longford		11-27-01
3+00	154.4	146.11	8.3	3+65.6	4" on 6" wye	6" STUB NE 6" STUB E	275927		1625 #5	Longford		1-4-80
LATERAL 29 MAIN 17 WAR INDUSTRIES SEWER												
0+00	157.0	151.77	5.2	0+00 EXISTING								
1+00	160.1	152.17	7.9	0+98.2					8903 E	HARRY		7-27-79
2+00	162.0	152.57	9.4	2+72.7	1+22.4		273277		8901 E	HARRY	7-27-79	
3+00	162.2	153.17	9.0	3+91.2	2+35.0		273276		8811 E	HARRY	7-27-79	
3+00	161.0	153.76	7.2	3+91.2	3+84.7		273275		8811 E	HARRY	7-27-79	

CONT' NEXT PAGE