


CONSTRUCTION RECORD						SERVICE RECORD						
STATION	ELEVATION		Depth	MANHOLE	4-INCH "Y" BRANCHES		No. of Permit		House Number		DATE OF PERMITS	
	Ground	Grade			North West	South East	North West	South East	North West	South East	North West	South East
LAT 12 MAIN 2 SWI (CONT'D)												
LINE 1 CONT'D	26+00	84.1 84.2 ^{OUT} 84.2 ^{IN}	77.00 77.06 77.16	7.1 7.1 7.0	26+29.8							
	27+00	84.2	77.30	6.9	27+29.8 ^{top}	27+72.4 ^{top}	5517	1643	5430 S. Broadway	304 Maywood	3-31-82	8-22-80
	28+00	84.3	77.50	6.8		28+34.1 ^{top}		990		312 Maywood		8-14-80
	29+00	84.4	77.70	6.7		29+53.8 ^{top}		4573		318 Maywood		6-16-80
		84.4	77.76	6.6	29+32.0			4574		324 Maywood		6-16-80
	30+00	84.8	77.90	6.9		30+31.6 ^{top}		988		404 Maywood		8-14-80
	31+00	86.0	78.10	7.9		31+01.0 ^{top}		4575		408 Maywood		6-16-80
		87.0	78.18	8.8	31+39.0	4" STUB NE 4" STUB SE		4769 45		416 E. Maywood		3-20-80
LINE 2												
	0+00	82.7	75.37	7.3	0+00=18+18.4 LINE 1							
	1+00	82.3 83.4	75.57 75.68 75.78	6.7 7.7 7.6	1+49.4 1+56.2		074879	072297	5550 Topoka Cir	403 Campwood	10-15-79	6-12-79
	2+00	83.8	75.87	7.9	2+11.2	2+30.2 ^{top} 2+61.6	074878	01347	5538 S. Topoka Cir	5539 S. Emporia	10-15-79	9-24-80
	3+00	84.3	76.07	8.2		2+70.0	074877	073392	5534 Topoka Cir	5535 S. Emporia	10-15-79	8-3-79
		84.3	76.12	8.2	3+25.6	3+18.0 3+92.5	074876	073390	5530 Topoka Cir	5529 S. Emporia	10-15-79	8-3-79
	4+00	84.2	76.27	7.9		4+53.8 ^{top}	074874	073387	5531 Topoka Cir	5525 S. Emporia	10-15-79	8-3-79
		84.6	76.46	8.1	4+97.0	4" STUB NE 4" STUB NW	074869	073388	5505 S. Emporia	5515 S. Emporia	10-15-79	8-3-79
							074873		5508 Topoka Cir		10-15-79	
LINE 3												
	0+00	84.8	71.95	12.9	0+00=1+76.6 LINE 1							
	1+00	84.8	72.25	12.6								
	2+00	84.5	72.55	12.0		2+46.8 ^{top}	2566	6124	5522 S. Santa Fe	5521 S. mead	2-6-81	7-8-82
	3+00	85.2	72.85	12.4		2+99.6 ^{top}	6598	4242	5518 S. Santa Fe	mead	10-5-81	
		85.2	72.90	12.3	3+15.6	3+08.6 ^{top} 3+72.6 ^{top}	6133	3987	5514 S. Santa Fe	5515 S. mead	7-8-82	8-25-81
	4+00	84.8	73.15	11.7		4+26.4 ^{top}	5183	3836	5510 S. Santa Fe	5513 E. mead	2-6-82	8-5-81
						4+94.2 ^{top}	2565	2568	5506 S. Santa Fe	5505 mead	2-6-81	2-6-81
	5+00	84.7	73.45	11.3		5+45.5 ^{top}	2567	1853	5462 S. Santa Fe	5461 mead	2-6-81	11-7-80
						5+98.3 ^{top}	1834	1852	5456 S. Santa Fe	5455 mead	11-7-80	11-7-80
	6+00	84.9	73.75	11.2		6+58.0 ^{top}	1832	1851	4550 Santa Fe	5449 mead	11-7-80	11-7-80
		84.8	73.85	11.0	6+31.9	7+16.0 ^{top}	1850		5446 S. Santa Fe	5441 mead	11-7-80	11-7-80
	7+00	84.7	74.05	10.7		7+21.0 ^{top}	1831		5438 S. Santa Fe	5433 mead	11-7-80	11-7-80
						7+92.1 ^{top}	1830	1849	5435 S. Santa Fe	5429 mead	11-7-80	
	8+00	85.0	74.35	10.7		8+27.1 ^{top}	1829	1848	5432 S. Santa Fe	5427 mead	11-7-80	11-7-80
						8+96.2 ^{top}	1847		5419 S. Santa Fe	mead	11-7-80	11-7-80
	9+00	84.9	74.65	10.3		9+10.8 ^{top}	1596		5406 S. Santa Fe		10-28-80	
		84.7	74.79	9.9	9+47.4	4" STUB NE 4" STUB NW	1595	1846	5403 S. Santa Fe	mead	10-28-80	11-7-80
LINE 4												
	0+00	85.6	72.63	13.0	0+00=5+13.3 LINE 1							
	1+00	84.2	72.93	11.3								
		85.0	73.14	11.9	1+69.2			2001-01947		5521 S. Santa Fe	SR see next pg	8-6-01
	2+00	85.2	73.23	12.0		2+29.2 ^{top}	5292		620 E. Campwood		3-4-82	7-1-81
		85.6	73.47	12.1	2+81.4	2+67.4 ^{top}		3580		5519 S. Santa Fe		7-1-81
	3+00	85.6	73.53	12.1		3+33.8		3500		619 E. Santa Fe		8-10-81
	4+00	85.1	73.83	11.3				1835		5461 S. Santa Fe		11-7-80
	5+00	84.6	74.13	10.5		4+98.8 ^{top}		1833		5455 S. Santa Fe		11-7-80
		84.4	74.38	10.0	5+83.0	5+72.2 ^{top}						
	6+00	85.6	74.43	11.2		6+25.0 ^{top}		2664		621 E. Maywood		2-23-81

CONT'D NEXT PAGE

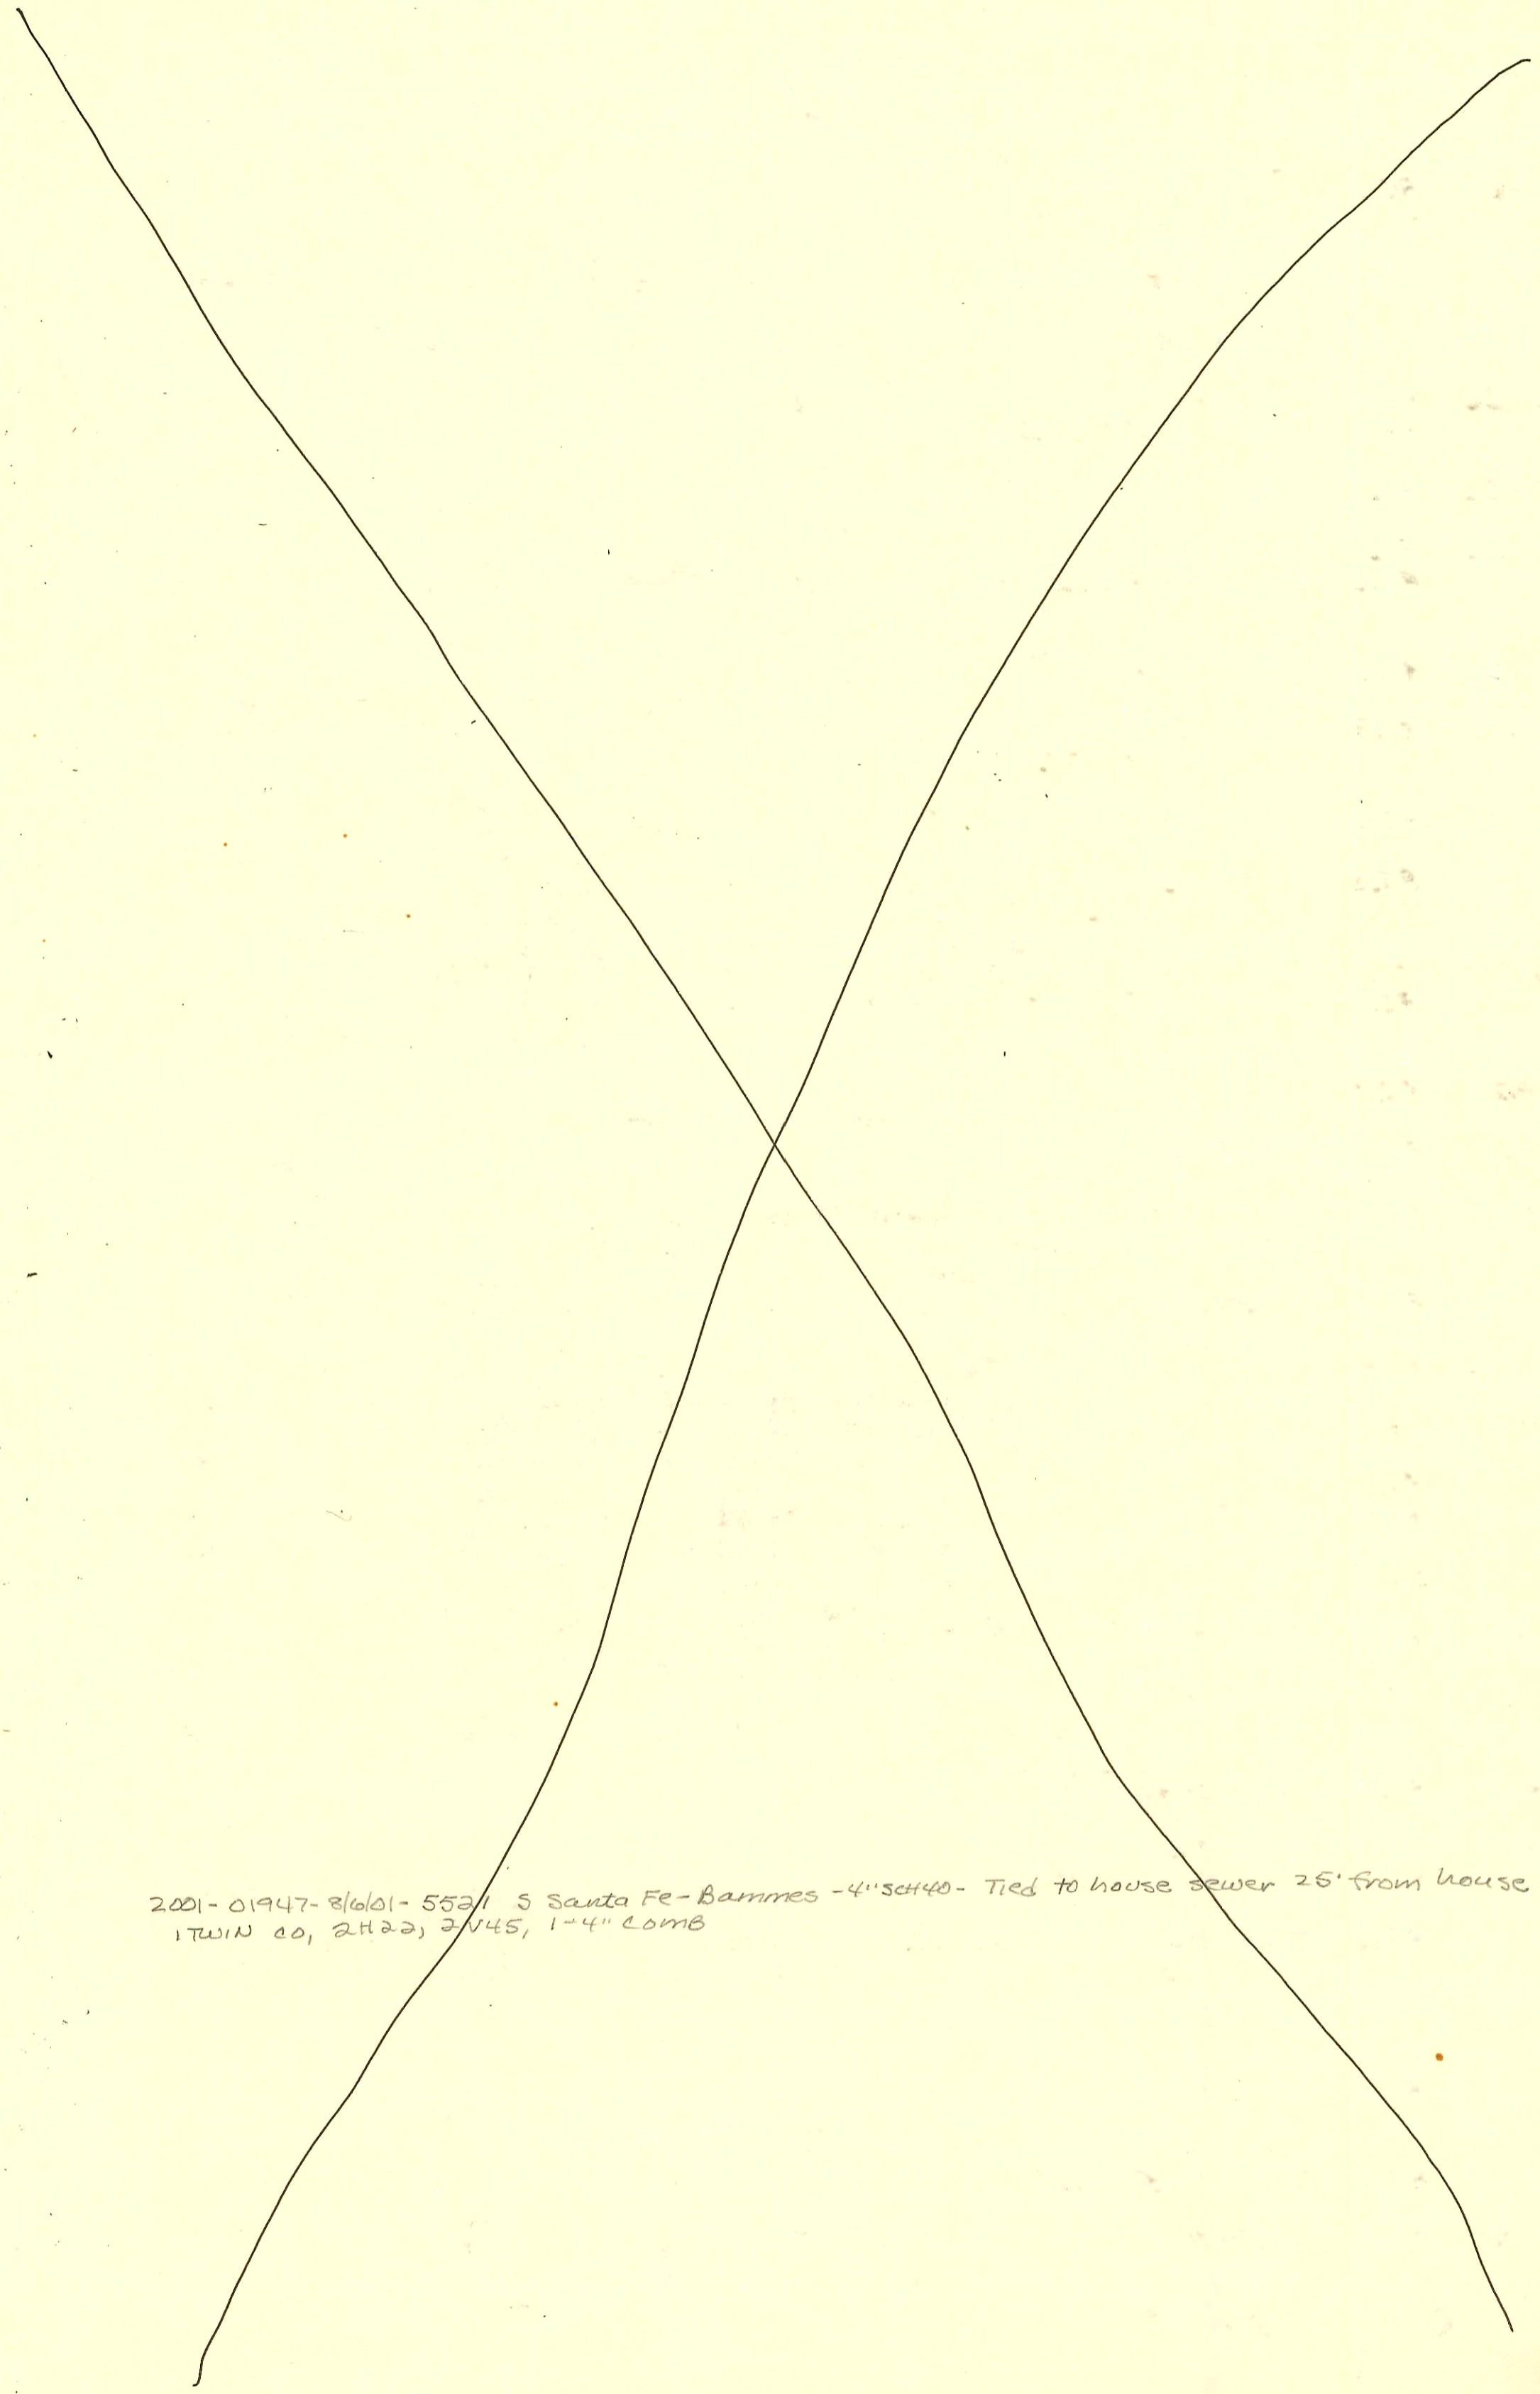

2001-01947-8/6/01-5521 S Santa Fe-Barnes -4"sch40- Tied to house sewer 25' from house addition
1TWIN 20, 2H22, 2V45, 1-4" COMB