


STAR LUMBER CO. SAN SEWER
McCORMICK & KESSLER
BUILT BY: DULING CONST. CO.
PROJ. NO 468-76-245-80780-000-000-008
BOOKED 11-10-79 FROM 261 Y


on map

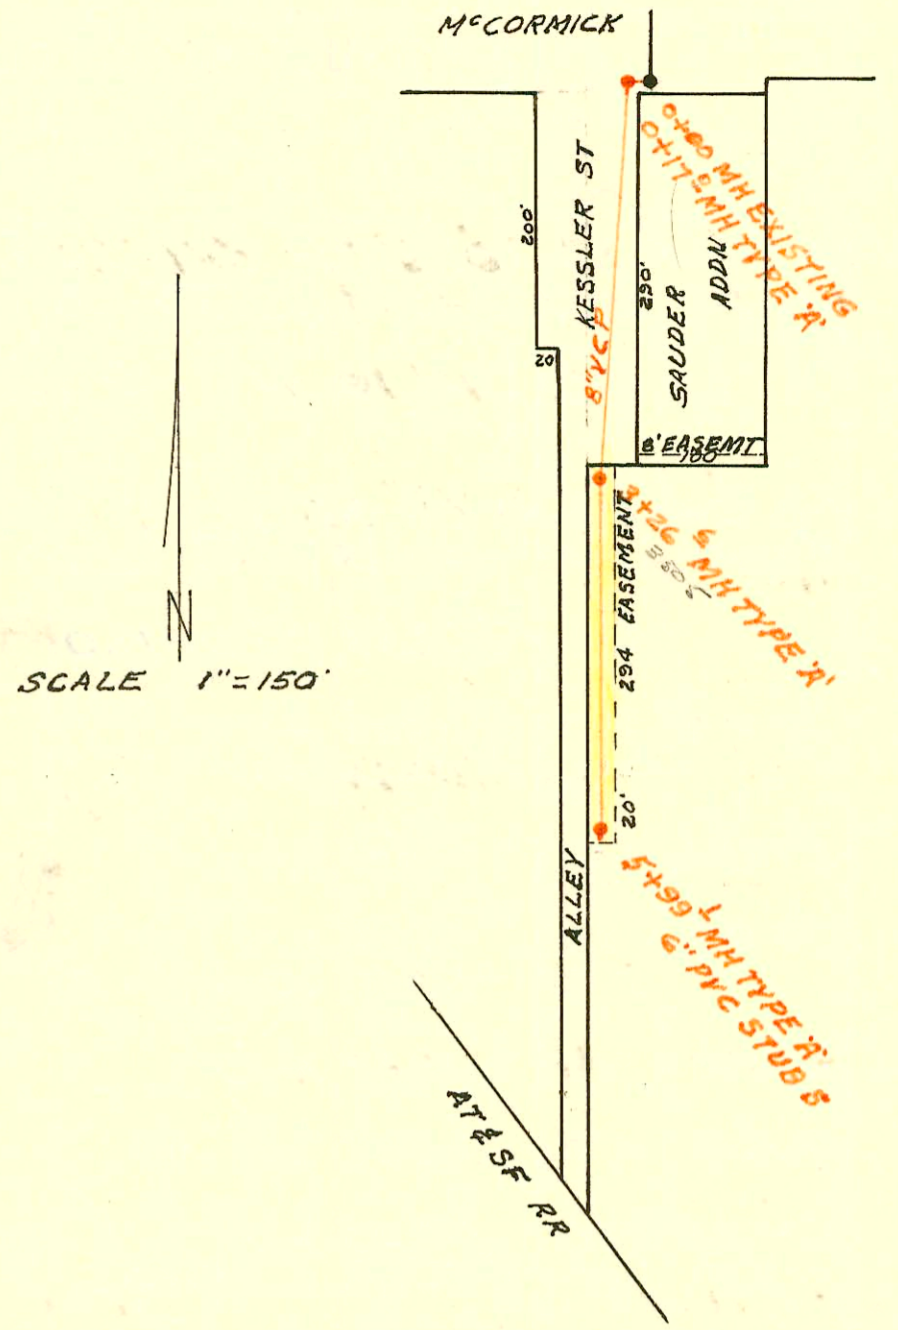

SCALE 1"=150'

TY-CEN ADDN SAN SEWER
BUILT BY: DULING CONST. CO.
PROJ. NO 468-76-80742-000-000-008
BOOKED 11-10-79 FROM 261 Y


on map

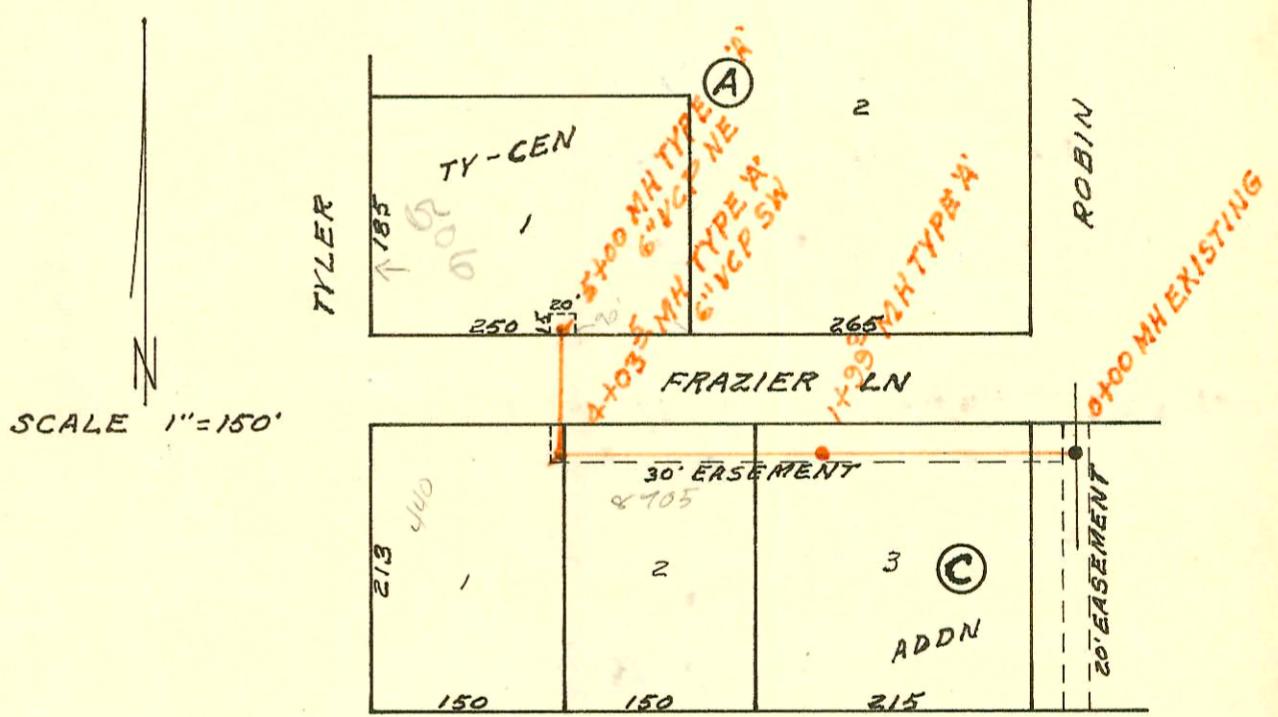

SCALE 1"=150'

LOTS 25 & 26 FAIRLAWN ACRES SAN SEWER
BUILT BY: ARKANSAS CONST. CO.
PROJ. NO 468-76-245-80796-000-000-008
BOOKED 11-13-79 FROM 261 Y

on map

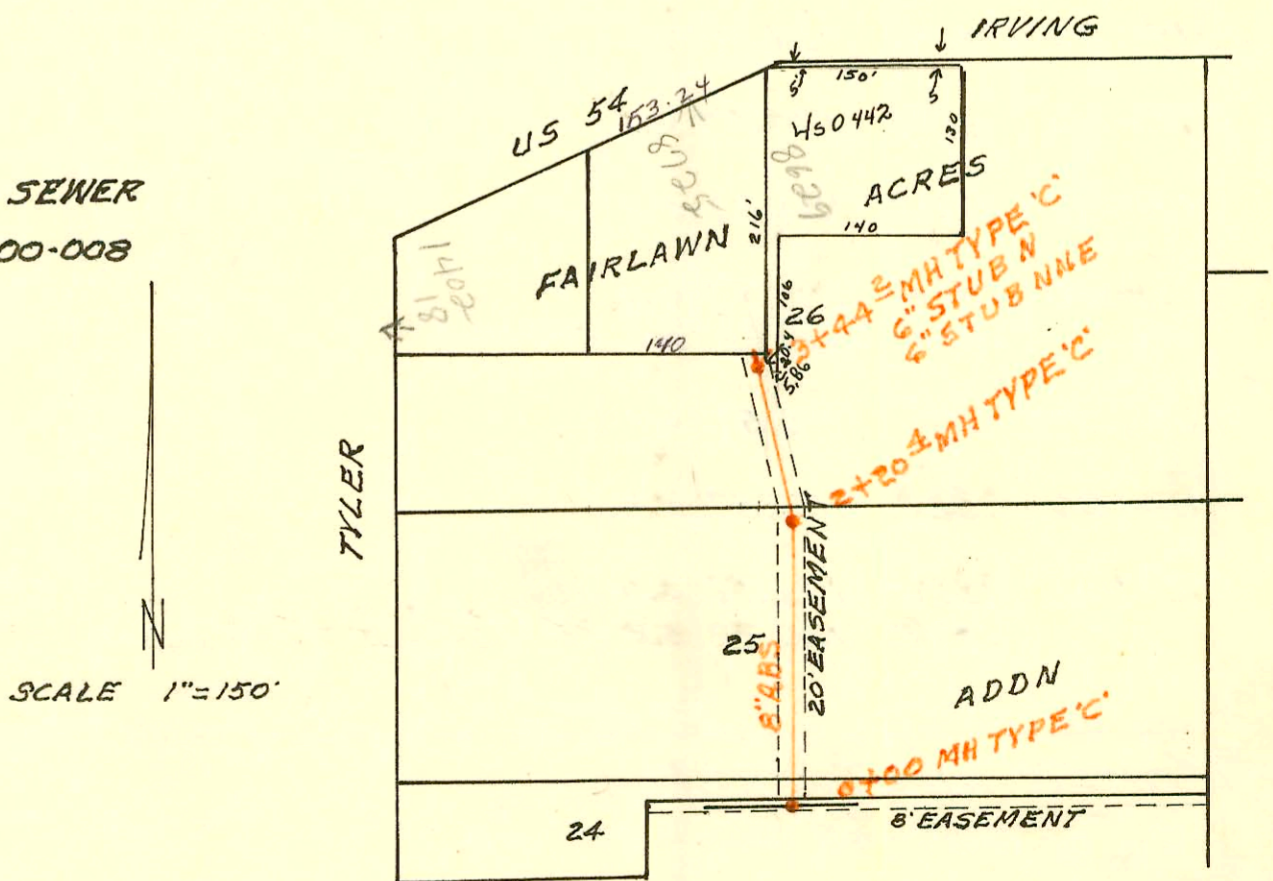

SCALE 1"=150'

CONSTRUCTION RECORD						SERVICE RECORD						
STATION	ELEVATION		Depth	MANHOLE	4-INCH "Y" BRANCHES		No. of Permit		House Number		DATE OF PERMITS	
	Ground	Grade			North West	South East	North West	South East	North West	South East	North West	South East
MTCARMELE APTS SS CONT'D												
6+00	114.0	104.78	9.2									
7+00	114.0	105.18	8.8		7+35.1		C74367		3000 W Douglas #1		9-18-79	
8+00	113.8	105.58	8.2			6" stub 35						6-19-95
	113.8	105.66	8.1	8+21.0		8+06.5		C74378	3000 W R Douglas #5		9-18-79	
9+00	115.0	106.08	8.9		9+75.5		C74375		3000 W Douglas #2			
10+00	113.5	106.48	7.0									
11+00	114.2	106.88	7.3									
	114.2	106.89	7.3	11+02.1								
		106.95	7.2									
12+00	114.7	107.38	7.3		12+36.7	12+34.8	C74376	C74379	3000 W Douglas #3	3000 W Douglas #6	9-18-79	9-18-79
					12+78.8		C74390		3000 W Douglas #7		9-18-79	
13+00	115.4	107.78	7.6									
14+00	117.6	108.18	9.4									
	117.7	108.20	9.3	14+04.5								
		108.30	9.4									
14+60.2	119.2	108.52	10.7									
STAR LUMBER CO. SAN SEWER @ M'CORMICK & KESSLER												
0+00	113.1	108.75	4.4	0+00 EXISTING								
	113.0	108.78	4.2	0+17.0								
		108.83	4.2									
1+00	113.2	109.00	4.2									
2+00	113.4	109.20	4.2									
3+00	113.2	109.40	3.8									
	113.0	109.45	3.6	3+26.6	3+22.1 tap		13254		3505		3-18-85	
4+00	112.6	109.60	3.0									
5+00	112.5	109.80	2.7									
	113.55	109.99	3.6	5+99.1	6" STUB S							
TY-CEN ADDN SAN SEWER												
0+00	141.8	137.30	4.5	0+00 EXISTING								
1+00	143.4	137.70	5.7									
	143.9	138.00	5.9	1+99.0								12-16-81
2+00	143.9	138.00	5.9									
3+00	144.2	138.30	5.9									
					3+72.0 tap		N78 2		875		10-2-85	
4+00	144.2	138.60	5.6									
	144.2	138.61	5.6	4+03.5	6" STUB SW	6" STUB SW	98-173067	9836	440 W B. George Inter		9-16-98	12-7-83
		138.71	5.5									
5+00	143.8	138.91	4.9	5+00.0	6" STUB NE		C73929		506 TU Tyler Rd		8-27-79	
LOTS 25 & 26 FAIRLAWN ACRES SAN SEWER												
0+00	141.8	132.61	9.2	0+00								
1+00	142.2	133.01	9.2									
2+00	142.6	133.41	9.2									
	143.0	133.49	9.5	2+20.4								
3+00	142.6	133.81	8.8									
	142.0	133.99	8.0	3+44.2	6" STUB N	6" STUB NNE	C75921	C72807	8629 W Cherry 8725 W Irving		1-3-80	7-6-79