

SISTERS OF ST JOSEPH BRD ADDN SAN SEWER
BUILT BY: UTILITY CONTR. INC.
PROJ. N^o 468-76-245-80767-000-000-008
BOOKED 11-14-79 FROM 261Y

007 map

SISTERS OF ST JOSEPH
3RD ADDN

SISTERS OF ST JOSEPH
2ND ADDN

SCALE 1" = 150'


BAYLEY
REINF CONC
ENCASED AT
JOINT ABS-DIP

0+84' 3" MH TYPE 'A'
0+62' 4" END 8" ABS
BEGIN 8" DIP
0+00' MH EXISTING

YALE

ROOSEVELT

823

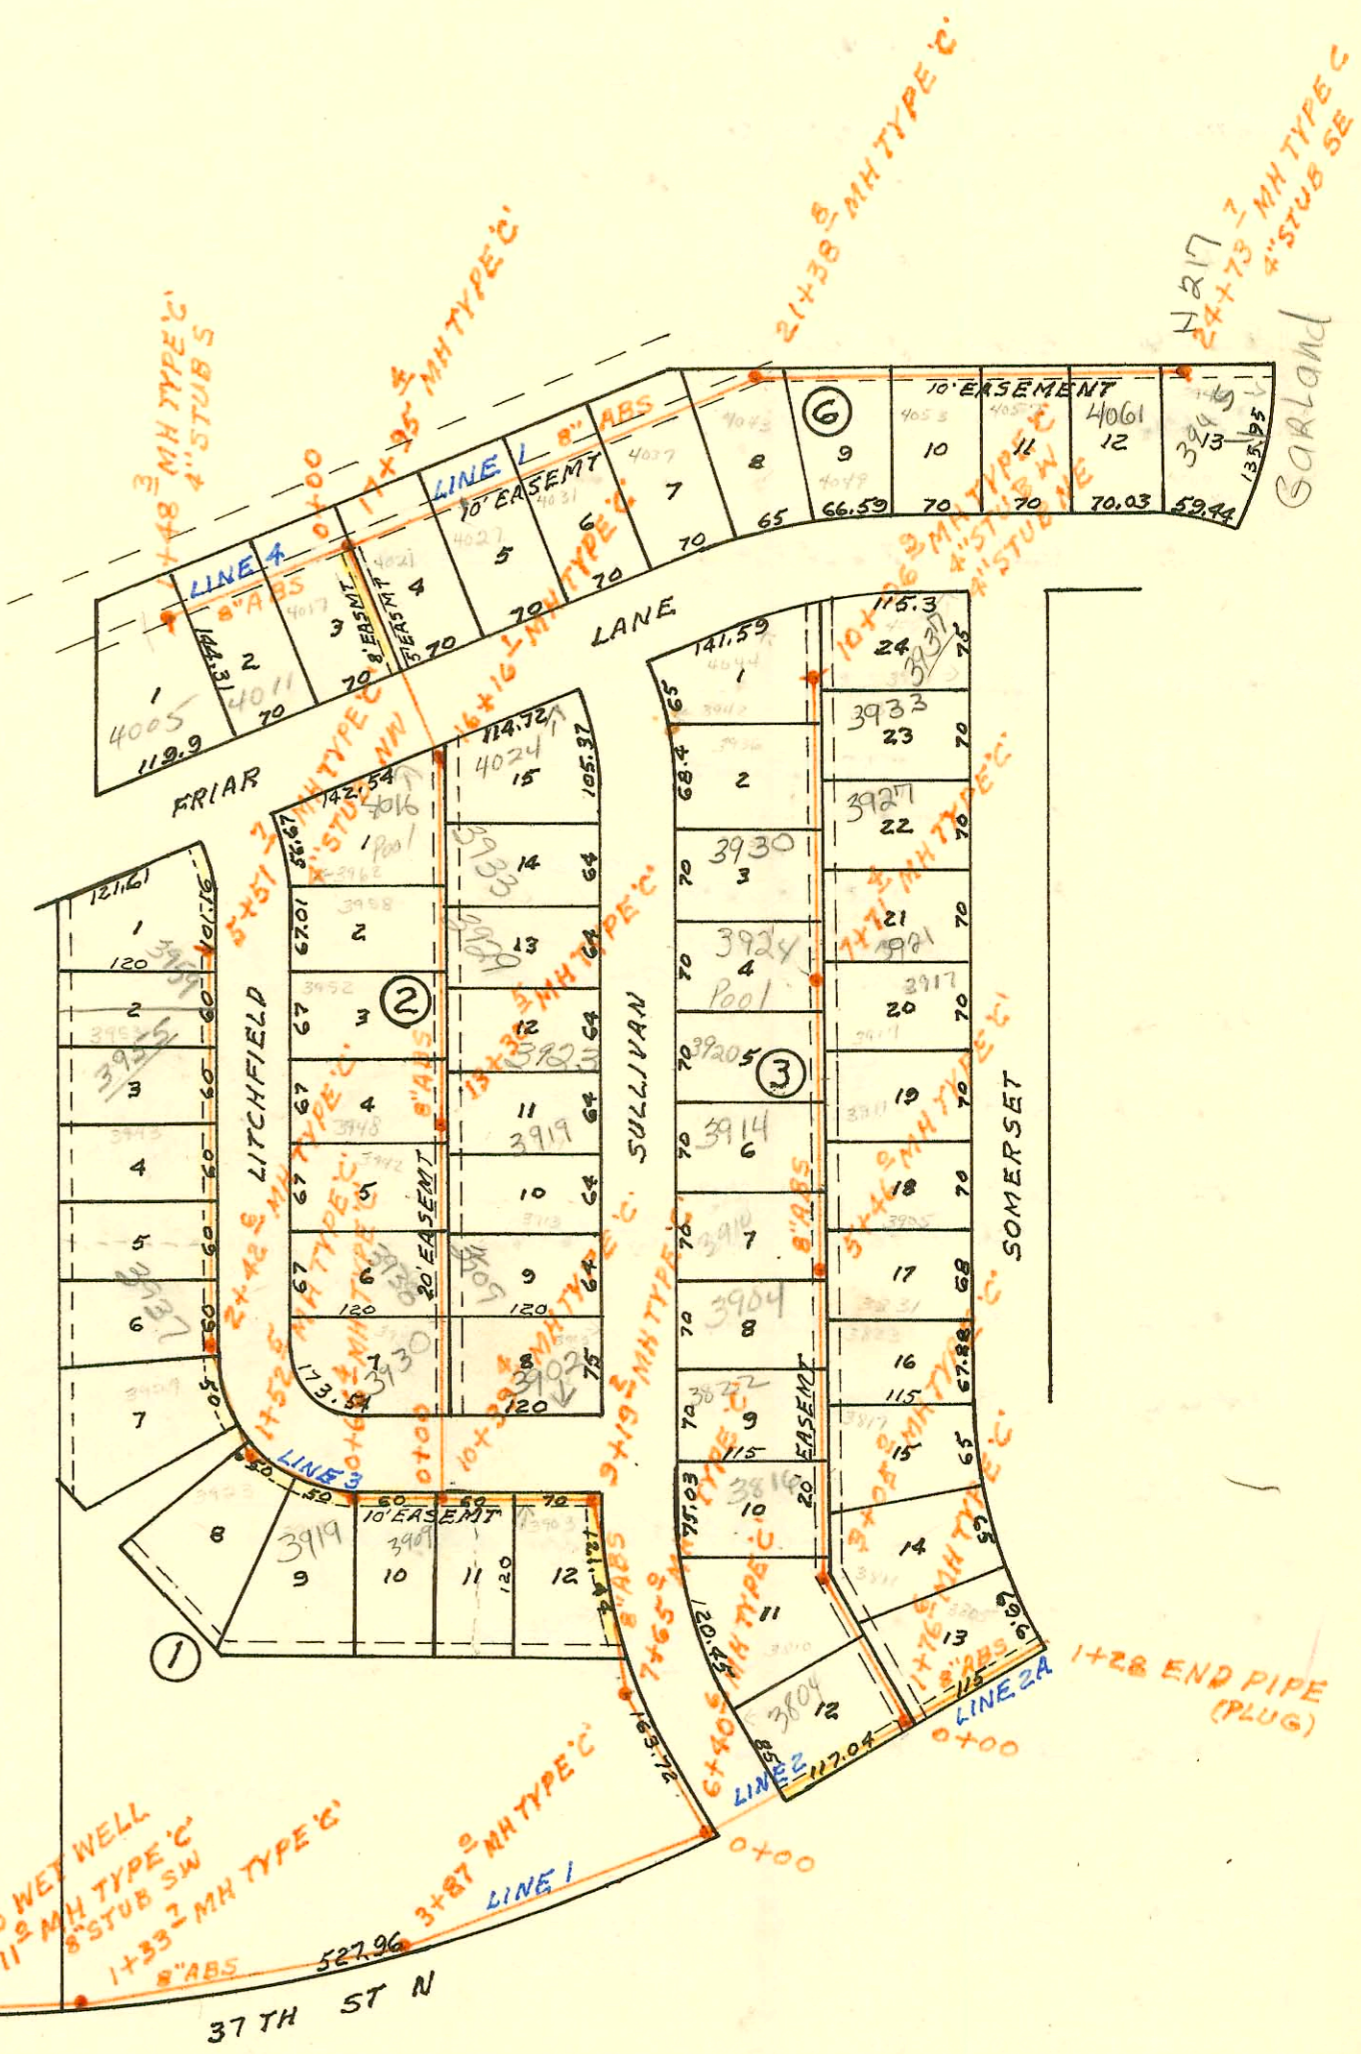

SCALE 1" = 150'

LATERAL 26 MAIN 21 55 N^o 22
BUILT BY: UTILITY CONTR. INC.
PROJ. N^o 468-76-245-80251-000-000-001
BOOKED 11-17 -79 FROM LES 11

007 map

CONSTRUCTION RECORD						SERVICE RECORD						
STATION	ELEVATION		Depth	MANHOLE	4-INCH "Y" BRANCHES		No. of Permit		House Number		DATE OF PERMITS	
	Ground	Grade			North West	South East	North West	South East	North West	South East	North West	South East
SISTERS OF ST JOSEPH 3RD ADDN SAN SEWER												
0+00	150.86	142.67	8.2	EXISTING								
	151.3	142.88	8.4	0+84.3	6" STUB N	Stub NE	272562		3720 E Bayley		6-26-77	
LATERAL 26 MAIN 21 SS N ^o 22												
LINE 1 0+00	133.0	118.05	15.0	WET WELL								
	132.3	out 118.09 in 118.19	14.2 14.1	0+11.0								
1+00	127.8	118.45	9.4									
	132.0	118.56	13.4	1+33.7								
2+00	127.7	118.75	9.0									
3+00	128.3	119.05	9.3									
	132.0	119.31	12.7	3+87.0								
4+00	129.4	119.35	10.1									
5+00	129.6	119.65	10.0									
6+00	128.7	out 119.95 in 120.07	8.8 12.4									
	132.5	in 120.29	12.2	6+40.6								
7+00	128.3	out 120.47 in 120.67	7.8 11.8									
	132.5	in 120.77	11.7	7+65.0								
8+00	129.5	120.87	8.6									
9+00	131.2	out 121.17 in 121.23	10.0 11.6				11714		3903 Litchfield		8-9-81	
	132.8	in 121.33	11.5	9+19.2								
10+00	131.3	out 121.57 in 121.63	9.7 11.0									
	132.7	in 121.79	10.9	10+39.4								
11+00	131.3	121.97	9.3									
					11+77.4	11+66.9	1330	20239	3930 Litchfield	3942 Litchfield	9-30-80	3-7-82
12+00	131.8	122.27	9.5		12+17.1	12+16.5	3087	2624	3938 Litchfield	3707 Sullivan	4-9-81	2-17-81
					12+78.5	12+73.5	3309	13187	3942 Litchfield	3713 Sullivan	5-14-81	3-11-85
13+00	131.3	122.57	8.7									
	133.5	122.66	10.8	13+30.5	13+24.5	13+41.1	9112	23241	3948 Litchfield	3919 Sullivan	8-21-83	5-26-87
14+00	131.4	122.87	8.5		14+31.5	14+09.0	9463	1953	3954 Litchfield	3723 Sullivan	10-18-83	11-21-80
					14+46.1			2027	3958 Litchfield	3729 Sullivan		12-5-80
15+00	132.2	123.17	9.0		15+06.9	15+11.7	10708	9111	4016 Friar Ln	4024 Friar Lane	4-17-84	8-21-83
					15+41.5	15+50.4	3088	00035			4-9-81	4-9-80
16+00	132.9	out 123.47 in 123.52	9.4 11.1									
	134.6	in 123.62	11.0	16+16.1								
17+00	131.9	out 123.87 in 124.16	8.0 7.5									
	131.7	in 124.26	7.4	17+95.4	17+60.4			24031	4017 FRUAR LN		10-4-89	
18+00	131.7	124.27	7.4		18+22.4			19011	4021 FRUAR LN		9-9-87	
					18+90			17829	4027 FRUAR LN			2-9-87
19+00	130.7	124.57	6.1									
					19+73.8			3310	4031 FRUAR LN			5-14-81
20+00	130.2	124.87	5.3									
					20+45.8			43311	4037 FRUAR LN			5-14-81
21+00	131.4	out 125.17 in 125.29	6.2 5.9									
	131.2	in 125.33	5.8	21+38.8	21+31.1			16867	4043 FRUAR LN			8-20-86
22+00	131.7	125.57	6.1		22+12.8			18980	4049 FRUAR LN			9-2-87
					22+26.8			17856	4058 FRUAR LN			2-26-87
23+00	132.2	125.87	6.3									
					23+59.2			20736	4057 FRUAR LN			5-26-88
24+00	132.2	126.17	6.0		24+13.8			23447	4061 FRUAR LN			6-28-89
	132.2	126.39	5.8	24+73.7	4" STUB SE			1928	3945 Garland			1-28-92

CONT'D NEXT PAGE

H 02295- 1-7-81 - 4017 FRUAR Lane - 4" ABS TAP 17.3' S. of MH - House was not built at that time - see above