



LATERAL 9 SUBMAIN 18 SAN SEWER N^o22
 BUILT BY: ARKANSAS CONST. CO.
 PROJ. N^o 468-76-245-80132-000-000-001
 BOOKED 12-15-79 FROM CG 16

SCALE 1"=150'

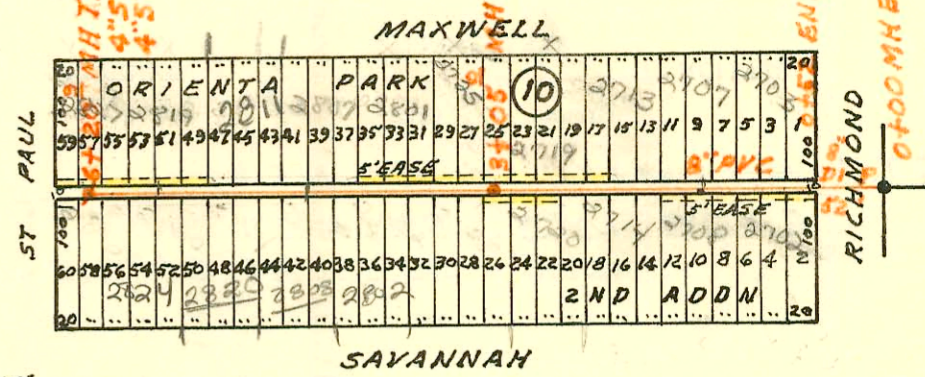


LATERAL 10 MAIN 18 SAN SEWER N^o22
 BUILT BY: ARKANSAS CONST. CO.
 PROJ. N^o 468-76-245-80706-000-000-001
 BOOKED 12-15-79 FROM CG 16

SCALE 1"=150'

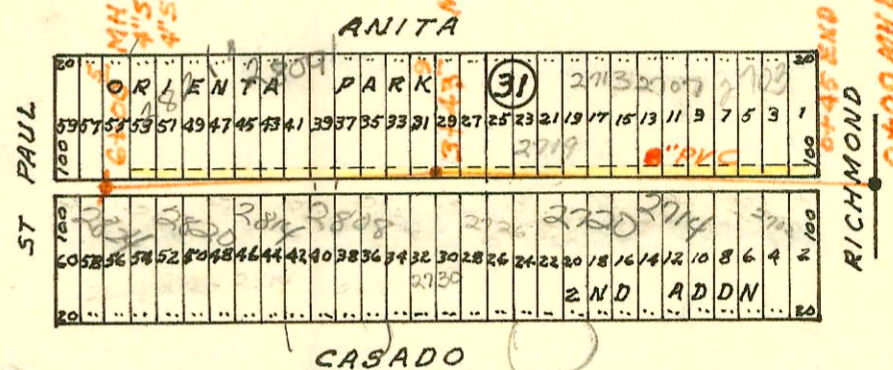

LATERAL 15 MAIN 18 SS N^o22
 BUILT BY: WBCARTER CONST. CO.
 PROJ. N^o 468-76-245-80777-000-000-001
 BOOKED 12-17-79 FROM CG 16

SCALE 1"=150'

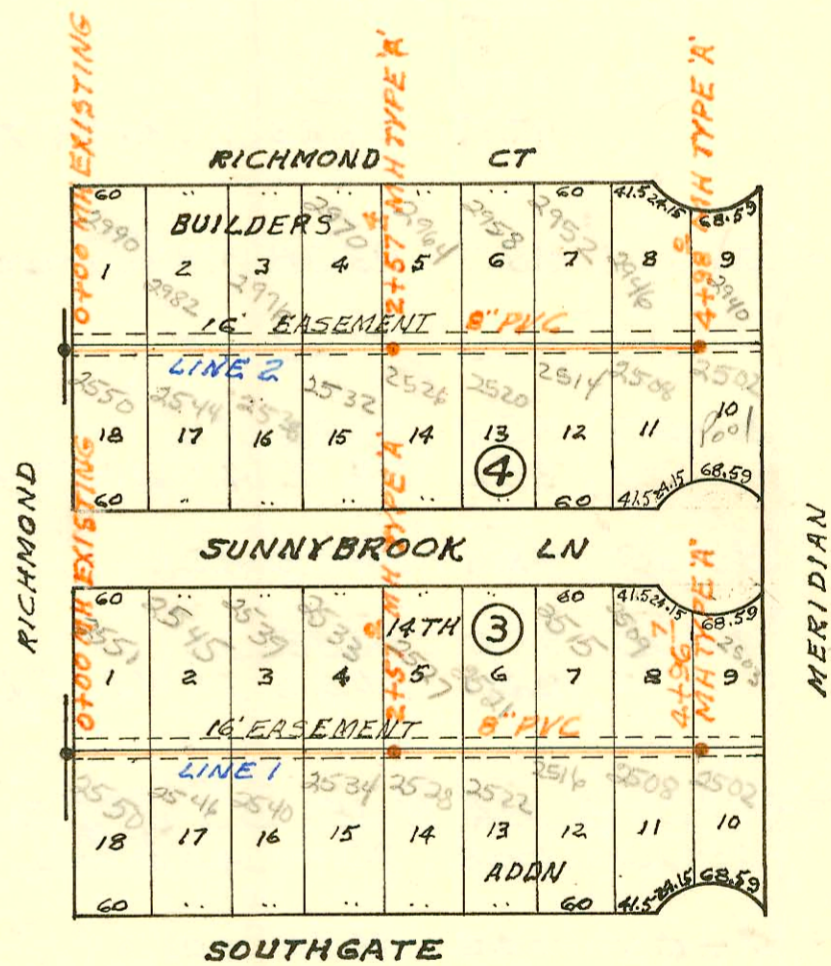

CONSTRUCTION RECORD

SERVICE RECORD

STATION	ELEVATION		Depth	MANHOLE	4-INCH "Y" BRANCHES		No. of Permit		House Number		DATE OF PERMITS		
	Ground	Grade			North West	South East	North West	South East	North West	South East	North West	South East	
LAT 26 MAIN 21 55 N ^o 22													
LINE 2 0+00	132.5	120.08	12.4	0+00=6+40.6 LINE 1									
1+00	128.7 132.5	120.38 120.61 123.09	8.3 11.9 9.4	1+76.6				6988	3905 Somer set			11-15-82	
2+00	129.2	123.18	6.0		2+20.2		1156	6988	3904 Sullivan		9-8-80		
3+00	131.0 133.0	123.58 123.60 123.70	7.4 9.4 9.3	3+05.0	2+73.0 3+11.4		7607	6988	3805 Somer set		11-15-82	3-8-83	
4+00	131.6	124.08	7.5		3+19.0 2+74.6		276319 276273	12836	3816 Sullivan		1-24-80	3-19-80	
5+00	131.5 133.7	124.48 124.67	7.0 9.0	5+46.0	4+27.0 4+83.0		10707 10706	10707	3904 Sullivan		1-23-80	4-17-84	
6+00	131.0	124.88	6.1		5+25.0 5+89.0		9127	9230	3910 Sullivan		9-6-83	9-16-83	
7+00	130.8 134.5	125.28 125.57	5.5 8.9	7+71.4	6+72.0 7+46.5 tap		25662	25662	3914 Sullivan		1-23-80	7-25-86	
8+00	131.6	125.68	5.9		7+84.4		8520	913757	3924 Sullivan		6-24-83	11-2-91	
9+00	131.9	126.08	5.8		8+52.9 tap 9+02.9 tap		23370 17382	20238	3930 Sullivan		6-16-89	12-01-86	
10+00	129.9 135.2	126.48 126.51	3.4 8.7	10+06.9	9+47.9 tap		26139	26139	3927 Somer set		3-7-88	9-14-90	
								22712	3937 Somer set			3-14-89	
LINE 2A 0+00 132.5 120.61 11.9 0+00=1+76.6 LINE 2													
1+28	131.4	120.99	10.4										
LINE 3 0+00 132.7 122.70 10.0 0+00=10+39.4 LINE 1													
								14889	3909 Litchfield			10-23-85	
	132.7	122.97 123.07	9.7 9.6	0+66.4	M.H. Top 4"=DR35 0+74.4 tap		7-264557		3919 Litchfield			10-8-93	
1+00	131.2 132.5	123.20 123.41 123.51	8.0 9.1 9.0	1+52.5	1+64.5 tap 1+94.1 tap		13330 13331		3923 Litchfield		3-26-85	3-26-85	
2+00	130.7 132.6	123.70 123.97 123.97	7.0 8.7 8.6	2+42.6	2+55.6 tap		5621		3937 Litchfield		4-15-82		
3+00	131.5	124.20	7.3		3+87.6 tap		14700		3913 Litchfield		9-17-85		
4+00	131.7	124.60	7.1		4"=DR35 4+06.2 tap		27297 27621		3955 Litchfield		7-16-91	1-24-80	
5+00	131.4 133.6	125.00 125.21	6.4 8.4	5+51.7	5+38.7 tap 4"STUB NW				3959 Litchfield				
LINE 4 0+00 131.7 125.06 6.6 0+00=17+95.4 LINE 1													
1+00	131.7 132.0	125.46 125.65	6.2 6.4	1+48.3	top 0+90.6		276318		4011 FRIAR			1-24-80	
					4"STUB S		400036		4005 FRIAR LANE			4-9-80	
LATERAL 9 SUBMAIN 18 SAN SEWER N ^o 22													
0+00	101.88	97.84	4.0	0+00 EXISTING									
1+00	101.6	98.04	3.6		0+94.6 tap 1+42.0 tap		6175 0833	274328	2703 maxwell	2702 Savannah		7-16-82	9-17-79
2+00	101.6	98.24	3.4		2+168.8		274329	12733	3713 maxwell	2708 Savannah		5-1-84	9-17-79
3+00	101.5 103.0	98.44 98.45	3.1 4.6	3+05.0	2+18.0 tap 2+35.5 tap		10474 274333	12733	3714 maxwell	2709 Savannah		3-15-84	9-17-79
4+00	101.7	98.64	3.1		3+10.1		3751		2750 Savannah			7-23-81	
5+00	101.9	98.84	3.1		3+27.0 3+54.7		274332		2725 maxwell	2801 Savannah		9-17-79	9-17-79
					4"=SCH 40 PVC 3+80 TAP 4"=SCH 40 5+00.4		2001- 00304	12012-7	2807 maxwell	2802 Savannah		2-12-01	6-9-99
					5+19.9 tap		274330	23796	2811 maxwell	2820 Savannah		2-7-98	8-24-87

CONT'D NEXT PAGE