
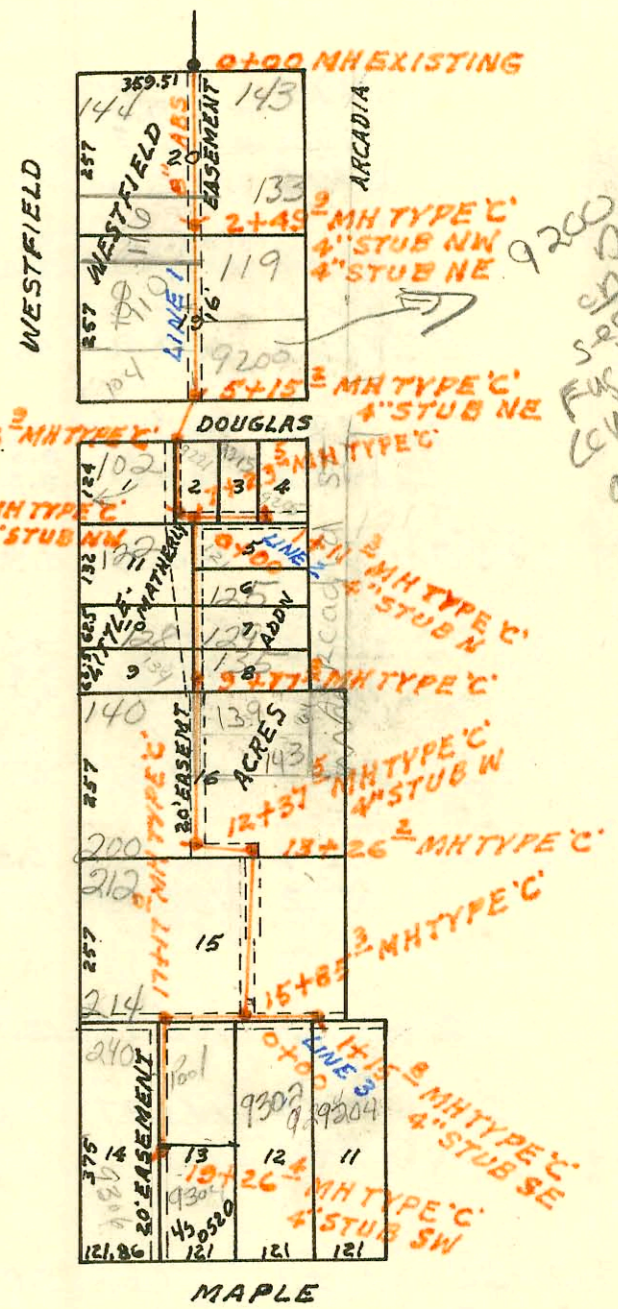
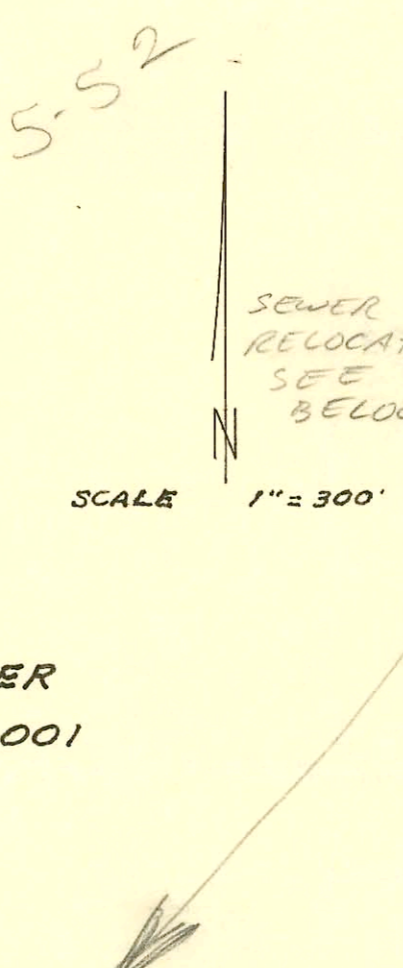


LATERAL 16 MAIN 1 WESTLINK SEWER
 BUILT BY: WB CARTER CONST. CO.
 PROJ. NO 468-76-245-80470-000-000-001
 BOOKED 1-22-80 FROM LES 19

ost map

Priv. San. Sewer Relocation for
 Lot 2 Little Matherly Addn.
 468-76-245-80001-000-000-131
 Built By Wildcat Const.
 Booked 12-14-87 From SPCS-III

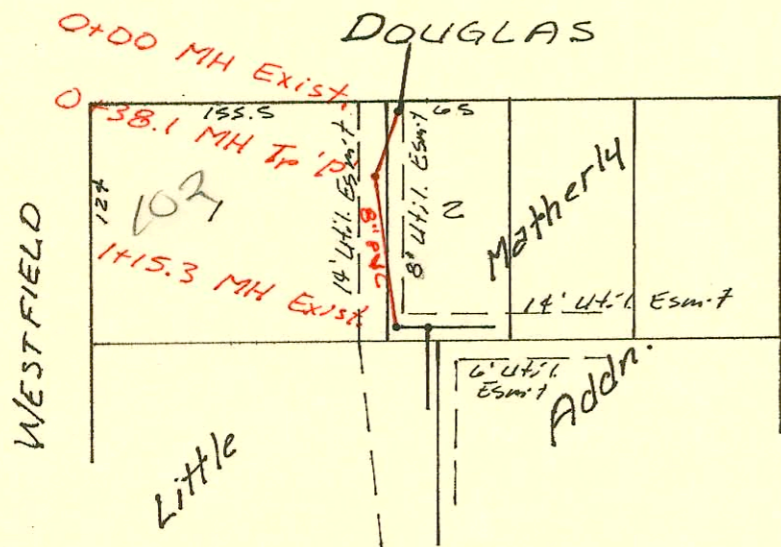

*9200 W
 SEE Douglas
 COMMENTS
 a d d
 BE*



Surf 2002-0113 *Reel* 4/12/02 102 S Westfield - Brand: 4" PVC, ITDIN CO,
 LH45, LH22, LV45, Tied 3' from main (No msmt)

CONSTRUCTION RECORD						SERVICE RECORD							
STATION	ELEVATION		Depth	MANHOLE	4-INCH "Y" BRANCHES		No. of Permit		House Number		DATE OF PERMITS		
	Ground	Grade			North West	South East	North West	South East	North West	South East	North West	South East	
LAT 3 MAIN 22 WIS CONT'D													
LINE 3 0+00	226.5	215.60	10.9	0+00=0+00 LINE 1									
1+00	225.4	216.00	9.4										
2+00	226.6 227.5	216.40 216.66	10.2 10.8	2+65.0									
3+00	228.2	216.80	11.4										
4+00	229.8	217.20	12.6										
5+00	232.1 232.7	217.60 219.82	14.5 12.9	5+55.9									
6+00	233.2	220.00	13.2										
7+00	234.2	220.40	13.8										
8+00	234.9 235.0	220.80 221.04	14.1 14.0	8+61.2	6" STUB NW 6" STUB W		667		3434 2071 67114		7-14-82		
LINE 2A 0+00	230.0 229.9	216.82 217.02	13.2 12.9	0+00=2+80.2 LINE 2 0+48.8									
LINE 2B 0+00	235.1 234.8	221.28 221.48	13.8 13.3	0+00=5+60.2 LINE 2 0+49.1									
LINE 2C 0+00	238.0 237.1	225.74 225.94	12.3 11.2	0+00=8+39.2 LINE 2 0+50.8									
LINE 2D 0+00	237.0 236.0	226.87 227.07	10.1 8.9	0+00=11+24.5 LINE 2 0+50.5									
LINE 3A 0+00	232.7 232.8	219.82 220.12	12.9 12.7	0+00=5+55.9 LINE 3 0+70.9									
LINE 3B 0+00	227.5 227.2	216.76 216.96	10.7 10.2	0+00=2+65.0 LINE 3 0+50.8									
LINE 3C 0+00	232.7 233.0	219.82 220.02	12.9 13.0	0+00=5+55.9 LINE 3 0+49.7									
LATERAL 16 MAIN 1 WESTLINK													
LINE 1 0+00	150.8	137.00	13.8	0+00 EXISTING									
1+00	149.8	137.20	12.6		3' Deep 0+35 RISER W 0+45 TAP		17550		144 N Westfield		12-31-86	8-29-79	
2+00	150.2 150.0	137.40 137.60	12.8 12.4	2+49.9	2+00.6 TAP 4" SPR 3.5 4" STUB NW		17109 9566679		120 N Westfield 116 N Westfield		10-13-86 5-1-95	7-25-79	
3+00	150.9	137.70	13.2										
4+00	151.7	137.90	13.8		3+79 8.5 DEEP RISER W		3490.5 273176	4270	140 N Westfield		119 N Arcadia	7-24-79 10-1-81	
5+00	153.2 153.2	138.10 138.13	15.1 15.1	5+15.2	4" SPR 3.5 4+89.2 TAP 4" STUB NE		9-29418-7		104 N Westfield			8-12-91	
6+	154.7	138.28 138.38	16.4 16.3	5+88.9									
6+00	155.0	138.40	16.6										
7+00	155.1	138.60 138.70	16.5 16.4	7+01.2	4" STUB NW								
8	154.8	138.75 138.85	16.1 16.0	7+23.5	4" STUB NE 7+84 RISER E		17820		925 W Douglas		121 S Arcadia	2-17-87	8-20-79
8+00	154.3	139.00	15.3										
9+00	152.6 151.2	139.20 139.36	13.4 11.8	9+77.8	8+37.5 RISER E 8+35 RISER W 8+97 RISER E		9+14.0 9+61.2 9+55.9	956719 273706	128 S Westfield 135 S Westfield		129 S Arcadia	3-7-80 8-20-79	8-20-79 12-13-79

CONT'D NEXT PAGE

CONSTRUCTION RECORD

SERVICE RECORD

STATION	ELEVATION		Depth	MANHOLE	4-INCH "Y" BRANCHES		No. of Permit		House Number		DATE OF PERMITS	
	Ground	Grade			North West	South East	North West	South East	North West	South East	North West	South East
LAT 16 MAIN 1 WESTLINK (CONT'D)												
LINE 1 CONT'D 10+00	151.1	139.40	11.7		10+78.4	4" S. 2235 10+08.8	3544	2207X	1405 Westfield	139 S. Arcadia	6-23-81	11-23-88
11+00	150.1	139.60	10.5			10+69.8		22184		143 Arcadia		12-08-88
12+00	149.5	139.80	9.7		12+00.3		7361		200 S. Westfield		1-13-83	
		149.5 ^{out} 139.88	9.6									
		149.5 ⁱⁿ 139.98	9.5	12+37.5	4" STUB W							
13+00	149.5	140.10	9.4									
		149.4 ^{out} 140.15	9.3									
		149.4 ⁱⁿ 140.25	9.2	13+26.2								
14+00	149.3	140.40	8.9									
15+00	149.2	140.60	8.6									
		149.7 ^{out} 140.77	8.9									
		149.7 ⁱⁿ 140.87	8.8	15+85.3								
16+00	149.8	140.91	8.9		16+86.2		293678		2115 Westfield		8-17-77	
17+00	150.8	141.21	9.6									
		150.9 ^{out} 141.27	9.6									
		150.9 ⁱⁿ 141.37	9.5	17+17.0								
18+00	151.3	141.61	9.7		18+09.6		294023		240 S. Westfield		8-29-77	
19+00	152.7	141.91	10.8									
		153.2	11.2	19+26.4	4" stubs =	4" STUB SW	18129	6648	9200 W Maple	9206 W Maple	6-3-87	9-27-80
LINE 2	0+00	154.8	142.77	12.0	0+00 = 7+23.5 LINE 1				9215 W Douglas		3-17-87	
						0+84.0	17959					
	1+00	154.4	143.97	10.4								
		154.4	144.11	10.3	1+11.3	4" STUB N	17817		9205 W Douglas		2-17-87	
LINE 3	0+00	149.7	140.89	8.8	0+00 = 15+86.3 LINE 1	4" SCH 40 0+25		2000- 23678		9202 W Maple		12-7-80
	1+00	149.0	141.19	7.8								
		148.9	141.24	7.7	1+15.8	4" STUB SE		2293		9204 Westfield		3-26-11
Priv. San. Sewer Relocation for Lot 2, Little-Matherly Addn.												
	0+00	155.3	138.45	16.9	EXIST 0+00							
			138.51 ^{out}									
		155.39	138.55 ⁱⁿ	16.9	0+38.1							
	1+00	155.3	138.64	16.7	1+15.30							