


21" V.C.P.

Abandoned

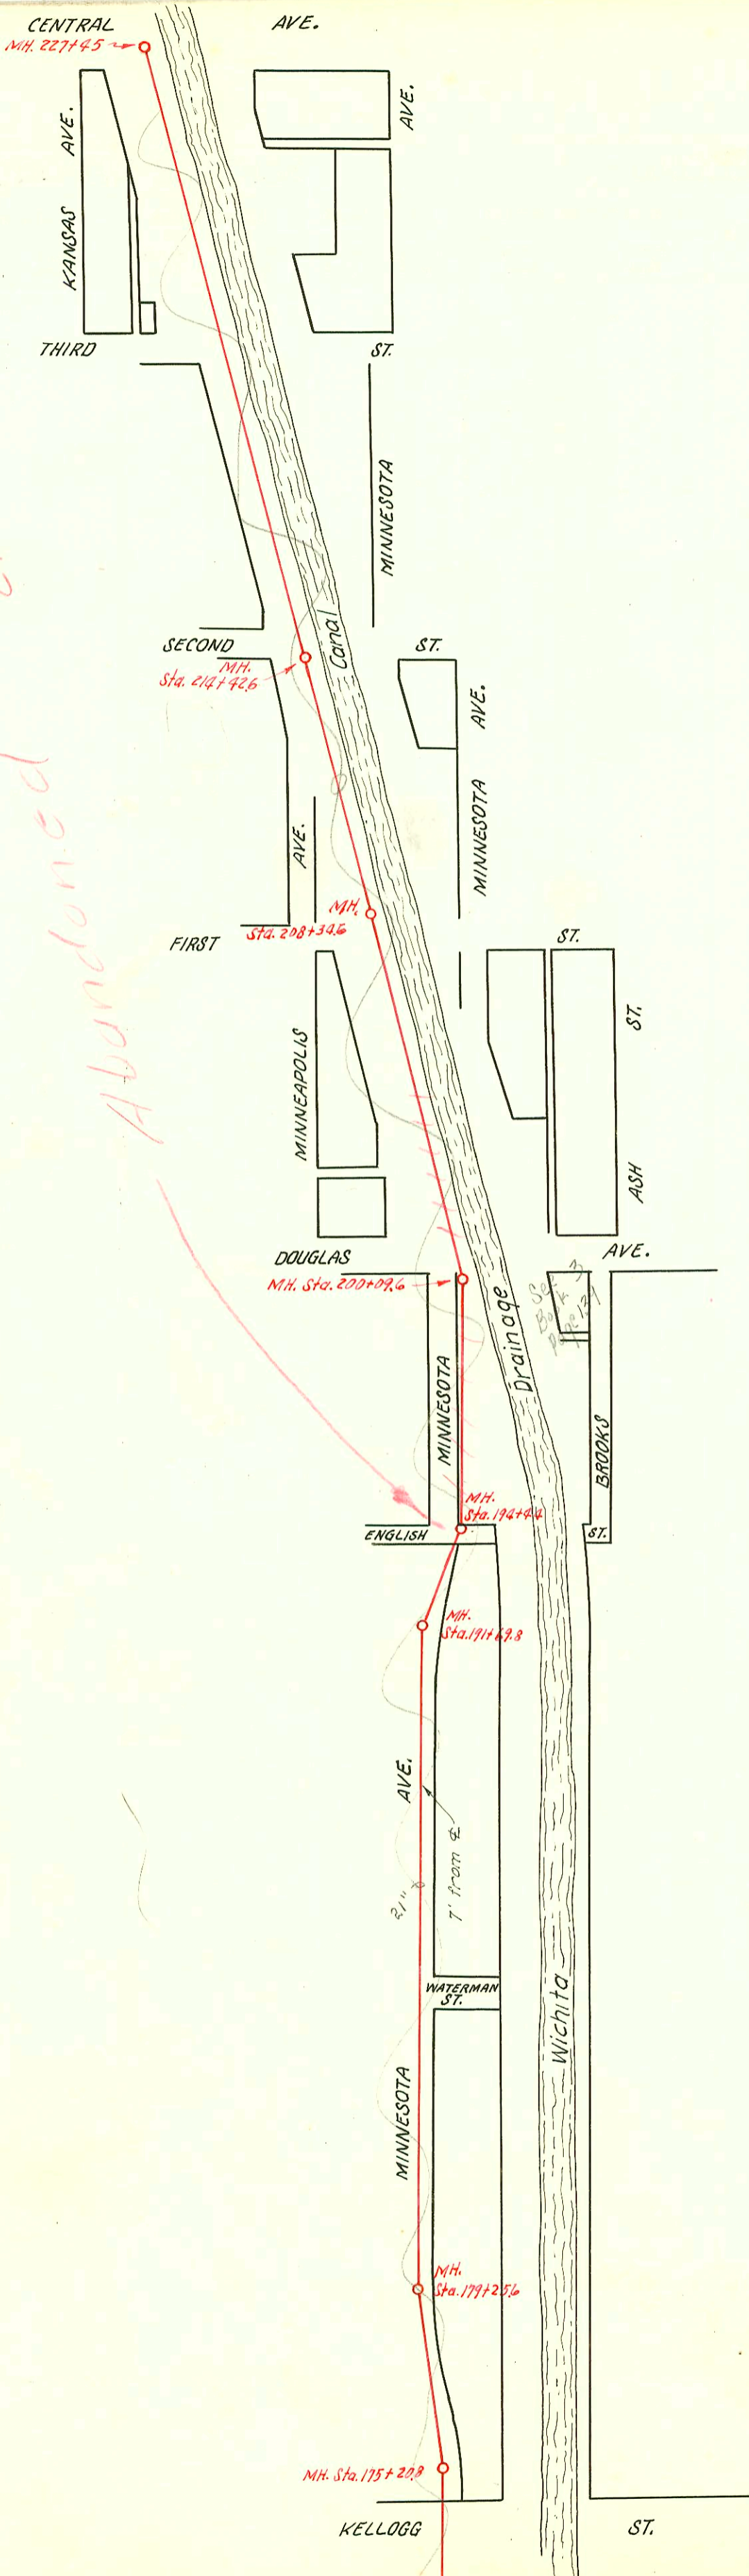

**INDUSTRIAL SEWER**  
 1933  
 21" Vitrified Clay Sewer

CONSTRUCTION RECORD					SERVICE RECORD							
STATION	ELEVATION		Depth	MANHOLE	4-INCH "Y" BRANCHES		No. of Permit		House Number		DATE OF PERMITS	
	Ground	Grade			North West	South East	North West	South East	North West	South East	North West	South East
173+0	107.76	100.48	7.28									
174+0	106.56	100.57	5.99									
175+0	108.14	100.67	7.47	175+20.8								
176+0	108.14	100.76	7.38									
177+0	108.04	100.86	7.18									
178+0	108.14	100.95	7.19									
179+0	107.94	101.05	6.89	179+25.6								
180+0	108.14	101.14	7.00									
181+0	108.42	101.24	7.18									
182+0	108.50	101.33	7.17									
183+0	108.70	101.43	7.27									
184+0	107.50	101.52	5.98									
185+0	106.20	101.62	4.58									
186+0	106.42	101.71	4.71									
187+0	105.70	101.81	3.89									
188+0	105.90	101.90	4.00									
189+0	106.07	102.00	4.07									
190+0	106.97	102.09	4.88									
191+0	107.47	102.19	5.28	191+69.8								
192+0	106.97	102.28	4.69									
193+0	107.27	102.38	4.89									
194+0	107.67	102.47	5.20	194+44								
195+0	108.34	102.55	5.79									
196+0	108.84	102.63	6.21									
197+0	109.14	102.73	6.41									
198+0	108.94	102.81	6.13									
199+0	109.24	102.89	6.35									
200+0	109.44	102.97	6.47	200+09.6								
201+0	109.31	103.14	6.17									
202+0	109.17	103.23	5.94									
203+0	109.02	103.33	5.69									
204+0	109.01	103.42	5.59									
205+0	108.66	103.52	5.14									
206+0	108.50	103.61	4.89									
207+0	110.70	103.71	6.99		No wyes.							
208+0	109.44	103.80	5.64									
209+0	108.06	103.90	4.16	208+34.6								
210+0	107.70	103.99	3.71									
211+0	107.15	104.09	3.06									
212+0	107.09	104.18	2.91									
213+0	106.66	104.28	2.38									
214+0	108.55	104.37	4.18	214+42.6								
215+0	107.68	104.47	3.21									
216+0	107.02	104.56	2.46									
217+0	106.83	104.66	2.17									
218+0	106.81	104.75	2.06									
219+0	107.07	104.85	2.22									
220+0	107.73	104.94	2.79									
221+0	111.16	105.04	6.12									
222+0	109.22	105.13	4.09									
223+0	109.03	105.23	3.80									
224+0	109.00	105.32	3.68									
225+0	108.77	105.42	3.35									
226+0	108.69	105.51	3.18									
227+0	108.50	105.61	2.89	227+4.5								
228+0	112.71	105.70	7.01									

#1580 Tap - 1835 E. 2nd - 5-19-39 - Moore Robertson Plbg. Co.  
 #2556 Tap - 1824 E. 2nd 8-5-40 W. W. Pray - Seal off 7-26-68 - at Hennung  
 #1425 - Tap - 1706 E. Douglas 2-13-47 - Ripston Plbg. Co.  
 #198 - Tap 241 N. Minnesota - 6-14-48 - W. B. Carter - Permit C11399 - Seal off - 241 N. Minneapolis - Fredrick Plbg. - 11-3-68  
 (included 45' W. of M.H. about 150.00 of 2nd St.)