


LAT. 18, DIST. A, S. S. N^o 21
 BUILT 1936
 JOHNSON P. & H. CO.

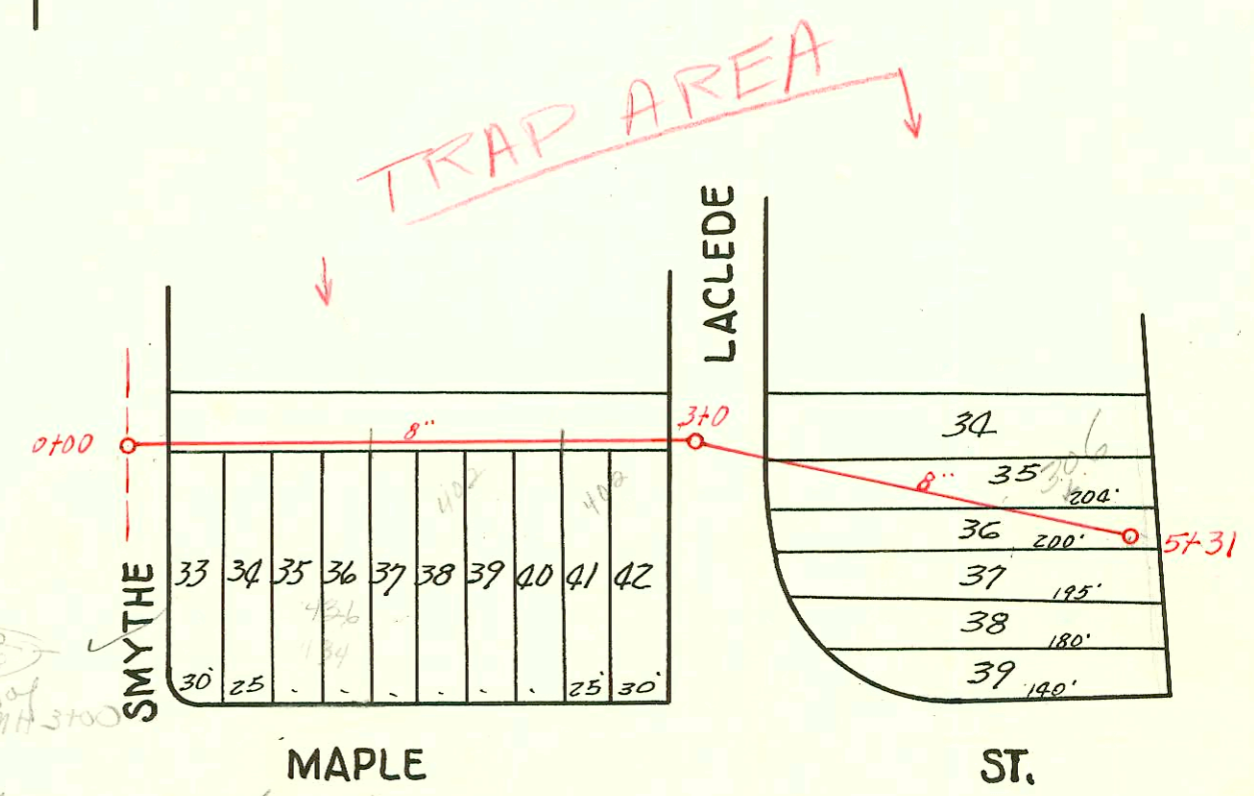

#9127453-7-7123191 406 W. Maple
 77' w/ 7113100
 B163-tap (306 Maple - Midwest Sanitation - 9-18-63 (5+23) No. maps)
 Seal off
 C5966-306 Maple - 12-1-67 - Al Henning

LAT. G, S. S. N^o 21
 BUILT 1936
 W. B. CARTER

CONSTRUCTION RECORD							SERVICE RECORD					
STATION	ELEVATION		Depth	MANHOLE	4-INCH "Y" BRANCHES		No. of Permit		House Number		DATE OF PERMITS	
	Ground	Grade			North West	South East	North West	South East	North West	South East	North West	South East
0+0	117.90	112.20	5.7		0+19.6	-	#4419		532 N Gordon		4-20-51	
1+0	117.70	112.30	5.4		-	0+98.6						
					1+22.6	1+19.6		#2560	539 N Edwards		8-21-42	
					1+46.8	1+43.8		#3703	543 N Edwards		1-16-51	
					1+71	1+68						
2+0	118.20	112.40	5.8	2+35	1+98.2	1+95.2	#4889		534 N Gordon		6-6-51	
					2+25.6	2+22.6		#2146	537 N Edwards		3-19-40	
					2+53	2+50			602 N. R. below		5-9-83	
3+0	118.60	112.50	6.1		3+34.4	3+31.4	#3871				7-16-41	
					3+61.6	3+58.6						
					3+88.9	3+85.9	4850	#18460	606 N. Gordon	601-03 N. Edwards	7-1-57	3-23-67
4+0	118.50	112.60	5.9		4+13.3	4+10.3		#75478	607 N. Edwards		8-20-47	
					4+37.3	4+34.3		#3299	612 N. Gordon			
				4+69.5	4+61.6	4+58.6		#1340	611 N. Edwards			3-30-42
5+0	118.50	112.70	5.8		4+86	4+83		#2522	618 N. Gordon		11-18-49	
					5+10.6	5+07.3		14234	615 N. Edwards			7-10-85
					5+34.4	5+31.4		#2523	622 N. Gordon	615 N. Edwards	11-18-49	10-26-73
					5+58.8	5+55.8						3-13-48
					5+82.9	5+79.9		049011	621-23 N. Edwards			10-15-74
6+0	119.00	112.80	6.2		6+07	6+04		2003-02491	627 N. Edwards			9-11-02
					6+31.3	6+28.3		860				12-28-46
					6+55.3	6+52.3		#3298	632 N. Gordon	631 N. P. Edwards	2-14-50	10-1-84
					6+79	6+76		#2694	638 N. Gordon	637 N. Edwards	12-5-49	3-19-53
7+0	118.70	112.90	5.8	7+03.5	7+13	7+10						1-20-50
					7+34	7+31		#3431	643 N. Edwards			2-23-50
					7+58	7+55		#2695	644 N. Gordon		12-5-49	
					7+83	7+80			see below			
8+0	119.10	113.00	6.1		8+10	8+07		#2076	650 N. Gordon	647 N. Edwards	1-28-02	6-15-50
					8+34	8+31						
					8+58	8+55		#1546	653 N. Edwards			6-9-52
8+99.5	118.80	113.10	5.7	8+99.5	8+83	8+80	#2099		654 N. Gordon		2-26-40	
0+0			6'	0+0	0+32	0+51.5		593	434 W. Maple			7-3-91
					0+56	0+80		7486	Lawrence-Dumont			10-19-83
1+0					0+97 TAP	1+05	22533				2-3-89	(City TAP)
						1+31.6						
						1+59.6						
2+0					1+86	2+23.3	22532	#340	Lawrence-Dumont	452-06	150-7-3	7-8-37
					2+41.7	2+41.7		#88	Maple			3-31-36
					2+72	2+72		#89	Maple			3-31-36
3+0			6'	3+0	3+33	3+60.5						
					3+84	4+08.6						
					4+35.8	4+60.6						
					4+84	5+08						
5+0					5+31	5+29						
5+31				5+31								

2003-01272-5103-602N Gordon-4"40PVC Preco Saddle 135's of MH 4+69.5(3+34.5) '4" fall, 1122, 1145, dirt alley cut- Replaced last 12' to main
 2002-00248-128/02-650 N Gordon Ave. McClung - Down to urge (on ms mt) 1145, 1122, 1145, 1145, 1145 @ house - 4" 5440 PVC

Tap - #224-324 W. Maple - 5-13-37 - H. d. Geile.
 Tap - 1650 - Lawrence stadium - 6-16-39 W.W. Pray.
 Tap - 1153 - Lawrence stadium - 8-9-49 Park Syactmart
 #2629 - Tap - 626 N. Gordon - 11-30-49 - Frederick P/bg. Co.
 + 6334 - Tap - 601 N. Edwards - 9-1-53 - Cherry P/bg. Co. #C1292 - Lead off - 601 N. Edwards - 12-30-66 (Burdick P/bg.)
 #6155 - Tap - 430 W. Maple - Burdick P/bg. - 8-26-55