


*Note*  
 Contact Geo W. H. in  
 of Dr. Brown before  
 issuance of permits  
 for repair of new Con.  
 on this lateral both sides  
 DWB  
 9-25-78

SCALE 1" = 150'

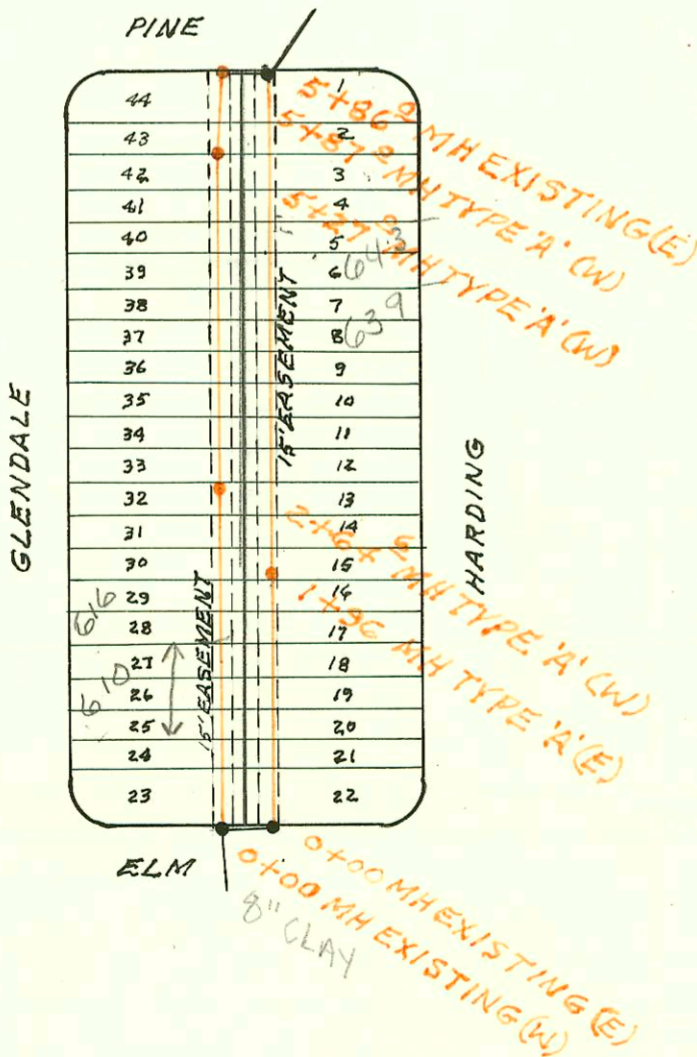

SCALE 1" = 150'

**LAT. X, DIST. 6, S. S. #12**

W. B. CARTER 1941

RECON PORTION LATX DIST 6 SS N#12  
 BUILT BY: W B CARTER CONST. CO.  
 PROJ. N# 468-76-245-81192-000-000-001  
 BOOKED 4-12-83 FROM AG 14

CONSTRUCTION RECORD						SERVICE RECORD						
STATION	ELEVATION		Depth	MANHOLE	4-INCH "Y" BRANCHES		No. of Permit		House Number		DATE OF PERMITS	
	Ground	Grade			North West	South East	North West	South East	North West	South East	North West	South East
0+0	172.18	166.00	6.18	0+0								
					0+86.4		#3106		4911 E Elm		2-9-41	
1+0	172.40	166.30	6.10									
				1+43.0								
2+0	172.80	166.60	6.20	2+00.0								
0+00	173.2	166.35	6.9	0+00 EXISTING	2+10.6		#3107		602 N. Glendale		1-24-83 2-8-41	
					2+26.5	0+25						
					2+56.6	0+84						
1+00	173.2	166.64	6.6		2+84.0		#3102 3107		610 N. NCR Glendale		1-24-83 1-22-41	6-21-99
3+0	173.00	166.80	6.20		3+05.5							
					3+30.2		#3103 3108		616 N. NC Glendale		1-24-83 2-8-41	
					3+45.8							
					3+79.2	1+45						
2+00	173.5	166.94	6.6	3+95.5								
4+0	173.20	167.00	6.20		4+03.2		#3109		620 N. W Glendale		1-24-83 2-8-41	
					4+19.0	2+20						
					4+52.6	2+69						
3+00	173.7	167.22	6.5		4+68.0		#3110		626 N. NE Glendale		1-24-83 2-8-41	
5+0	173.40	167.20	6.10		5+02.0		#3106 3111		632 N. NC Glendale		1-24-83 2-8-41	
					5+17.5	3+18						
					5+51.5		#3107 3109		640 N. NC Glendale		1-24-83 1-22-41	
4+00	174.1	167.47	6.6	5+89.8								
6+0	173.70	167.40	6.30		6+00.4							
					6+25.0							
					6+49.5	4+69						
5+00	174.7	167.71	7.0		6+68.8		#3108 3112		648 N. NC Glendale		1-24-83 2-8-41	
7+0	173.90	167.60	6.30		7+01.8		#3109 3113		652 N. NC Glendale		1-24-83 2-8-41	
					7+32.8							
					7+51.0	5+33						
					7+79.5							
	174.3	168.02	6.3	5+87.0								
	174.20	167.77	6+43	7+86.1								
0+0	172.80	166.77	6.03	0+0								
0+00	172.94	166.75	6.2	0+41.1 EXISTING								
					0+52.2							
					0+57.4		#3110		670 E Elm NC		1-24-83 3-16-48	
1+00	173.3	166.98	6.3		1+01.4		#3111		611 N. NC Harding		1-24-83 6-22-50	
1+0	172.70	167.10	5.60		1+29.3		#3112		615 N. NC Harding		1-24-83 4-15-41	
					1+54.5							
					1+76.0							
2+00	173.2	167.21	6.0	1+96			#3113		619 N. NC Harding		1-24-83 4-15-41	
2+0	172.80	167.20	5.60		2+19.4							
					2+35.7							
					2+43.7		#3114		623 N. NC Harding		1-24-83 4-15-41	
					2+67.6							
					2+93.0		#3115		629 N. NC Harding		1-24-83 3-17-41	
3+00	173.4	167.43	6.0		3+17.6							
3+0	173.40	167.50	5.90		3+42.3		#3116		633 N. NC Harding		1-24-83 3-17-41	
					3+67.3							
4+00	174.0	167.66	6.3		4+16.4		#3117		639 N. NC Harding		1-24-83 3-17-41	
4+0	173.50	167.70	5.80		4+41.3		#3118		643 N. NC Harding		1-24-83 3-17-41	
					4+65.8							
					4+90.0							
5+00	174.3	167.88	6.4		5+14.8		#3119		649 N. NC Harding		1-24-83 2-25-41	
5+0	173.90	167.90	6.00		5+39.2							
					5+67.6		#3120		653 N. NC Harding		1-24-83 3-17-41	
					5+91.5							
6+0	174.6	168.07	6.5	5+86.0								
	174.20	168.10	6.10		6+16.3							
	174.30			6+27.6								

2003-01109 4/23/03 643 N Harding - Reddi Rootr - new starts @ edge of house, 2H22, 8x4 existing saddle - PVC main 120's of MH to tap

Note #3313 - Tap into MH. 7+86.1 - 4902 E. King. - 4-15-41 - Chester Davidson (\$1000 special fee paid 4-15-41)