



M# 24+60.6  
B-259

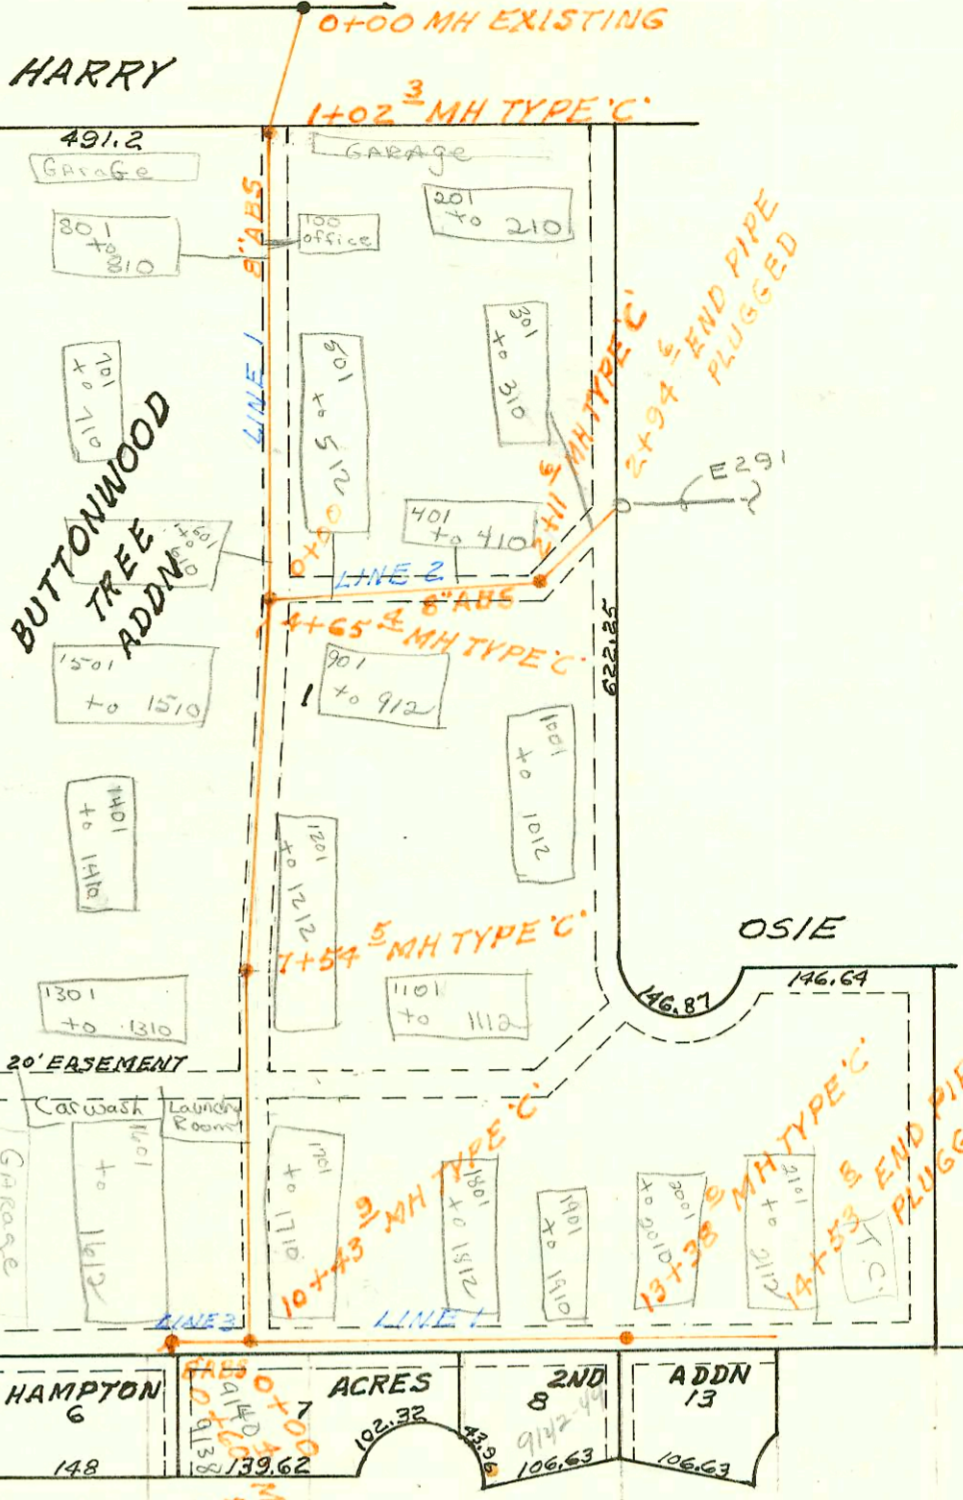

SCALE 1"=150'

LATERAL B MAIN 19 WAR INDUSTRIES SEWER  
 BUILT BY: UTILITY CONTR. INC.  
 PROJ. N<sup>o</sup> 468-76-245-80689-000-000-001  
 BOOKED 3-21-80 FROM SRL 13

S.S. FOR LOT 5 & S 330.7' of LOT 6 KAPAUN 1ST ADDN  
 BUILT BY: PRIVATE  
 PROJ. N<sup>o</sup> 468-76-245-80520-000-000-008  
 BOOKED 3-24-80 FROM 1H6

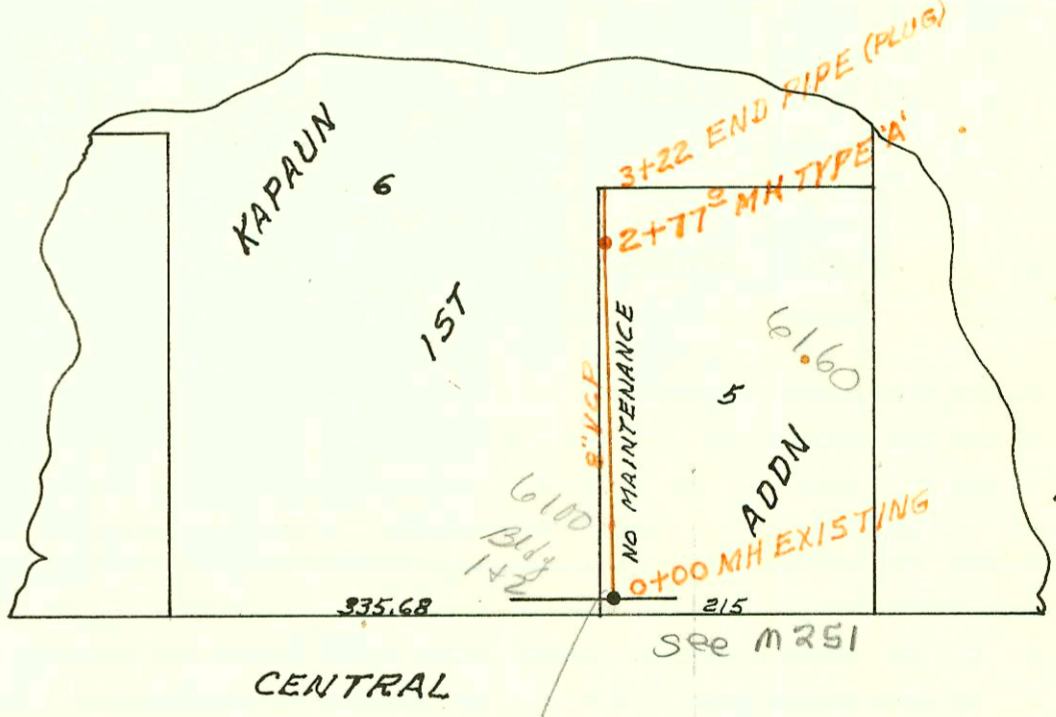

SCALE 1"=150'

Do not issue  
 Sewer Permit  
 for Lot 6 without  
 checking to see  
 arrangement on this  
 line. appears to  
 be private maint.  
 BX  
 10/29/93

