
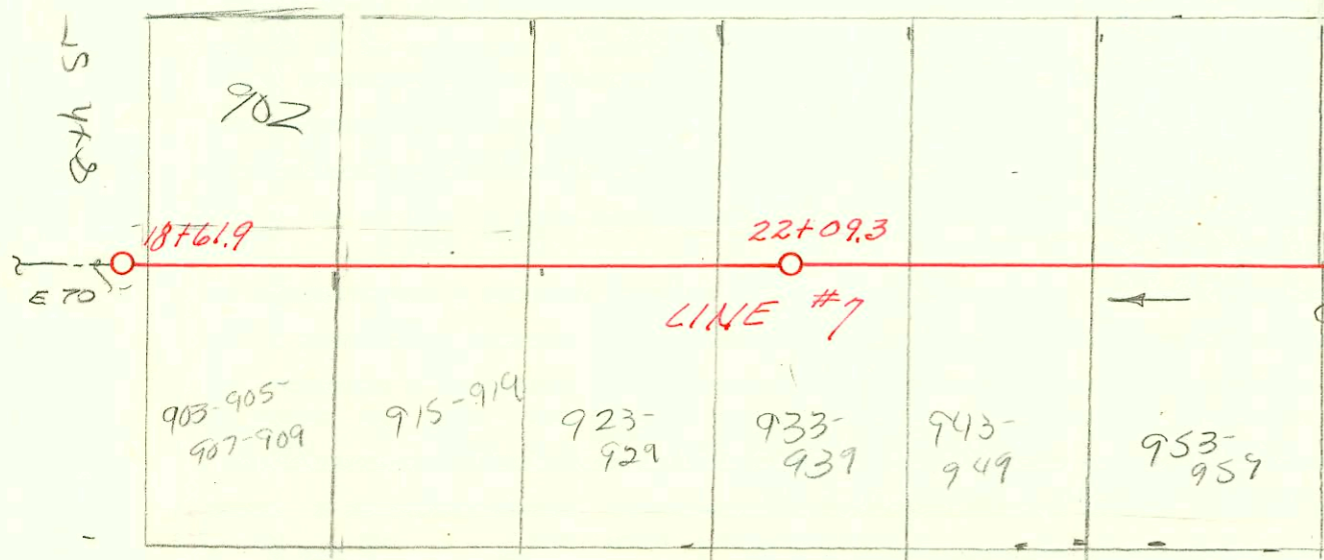


CRESTWAY AVE.

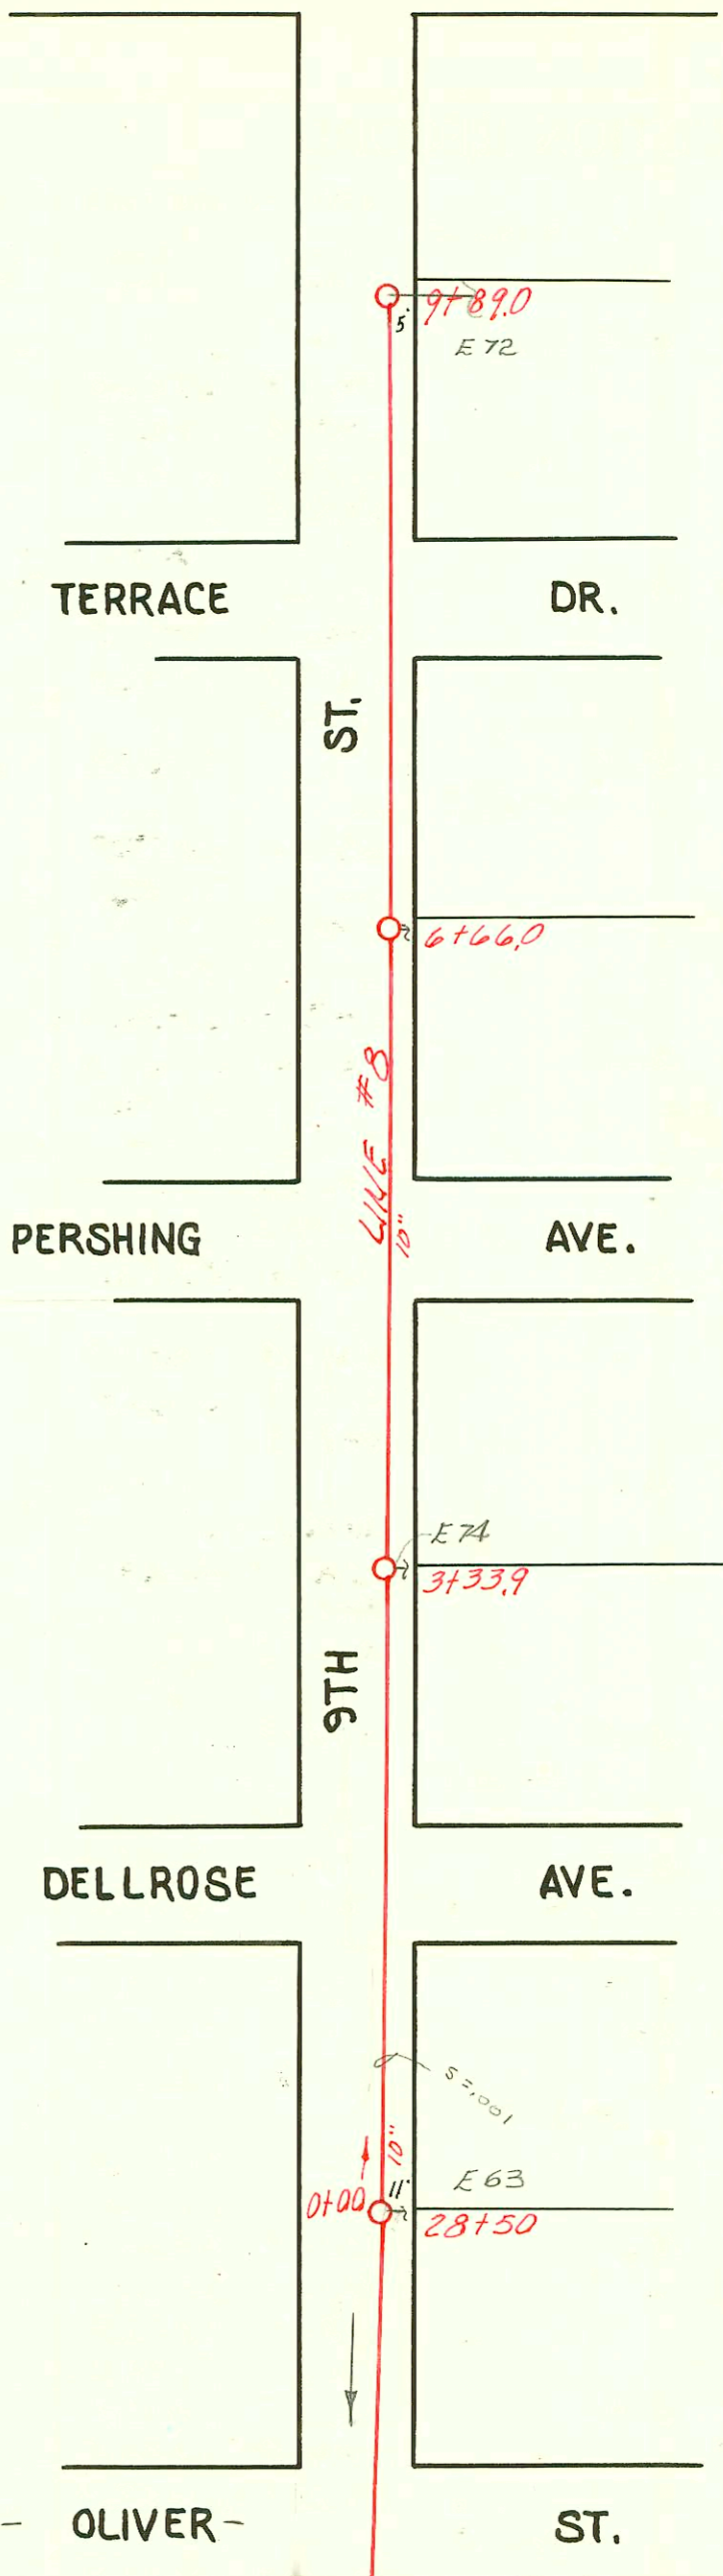

Glendale

**LAT. 3, D.C.S., S. S. 12**  
 W. B. CARTER 1941

#1129-Top-4802 E. 9th - 3-8-48 - Davidson Plbg Co.

CONSTRUCTION RECORD							SERVICE RECORD					
STATION	ELEVATION		Depth	MANHOLE	4-INCH "Y" BRANCHES		No. of Permit		House Number		DATE OF PERMITS	
	Ground	Grade			North West	South East	North West	South East	North West	South East	North West	South East
18+00	190.9	178.01	12.89		18+02.6	17+99.6	#2203		956 N. Oliver		10-27-42	
					18+30.2	18+27.2						
					18+54.3	18+51.3						
				18+61.9								
					18+79.6	18+76.6						
						18+99.6						
19+00	191.4	178.51	12.89		19+02.6	19+99.6	#2235		102 N. Oliver		7-6-42	
					19+30.3	19+27.3						
					19+54.6	19+51.6						
					19+78.7	19+75.7	#2236		712 N. Oliver		7-6-42	
20+00	192.0	179.0	13.0		20+03.0	20+00.0						
					20+30.3	20+27.3						
					20+54.9	20+51.9						
					20+79.2	20+76.2						
					21+02.7	20+99.7						
21+00	192.9	179.50	13.40		21+27.3	21+24.3	#2237		722 N. Oliver		7-6-42	
					21+54.3	21+51.3	#2564		723 N. Glendale		8-21-42	
					21+78.8	21+75.8	#2238	#2565	732 N. Oliver	733 N. Glendale	7-6-42	8-21-42
						21+99.5						
22+00	193.3	179.99	13.31		22+02.5							
				22+09.3								
					22+31.3	22+28.3						
					22+55.2	22+52.2						
					22+79.1	22+76.1						
						22+99.8						
					23+02.8							
23+00	192.8	180.49	12.31		23+27.3	23+24.3	#2239	#2566	942 N. Oliver	943 N. Glendale	7-6-42	8-21-42
					23+54.0	23+51.0						
					23+78.7	23+75.7						
					24+03.8	24+00.8						
					24+27.6	24+24.6						
25+00	194.4	181.48	12.92									
				25+12.4								
26+00												
27+00												
28+00				28+50.0								
0+00	197.90	182.05	15.85	0+0								
1+00	199.20	182.15	17.05									
2+00	200.30	182.25	18.05									
3+00	200.40	182.35	18.05									
				3+33.9								
4+0	2+00.9	182.45	18.45									
5+0	201.5	182.55	18.95									
6+0	201.9	182.65	19.25									
				6+66.0								
7+0	202.3	182.75	19.55									
8+0	202.5	182.85	19.65									
9+0	202.6	182.95	19.65									
	202.7	183.04	19.66	9+89.0								

#2240 - Tap - 952 N. Oliver - 7-6-42 - Chester Davidson  
 #2241 - Tap - 903 N. Glendale - 8-21-42 - Chester Davidson  
 #2563 - Tap - 913 N. Glendale - 8-21-42 - Chester Davidson  
 #2564 - Tap - 923 N. Glendale - 8-21-42 - Chester Davidson  
 #2567 - Tap - 953 N. Glendale - 8-21-42 - Chester Davidson