


5.44 eastward on rear of each lot

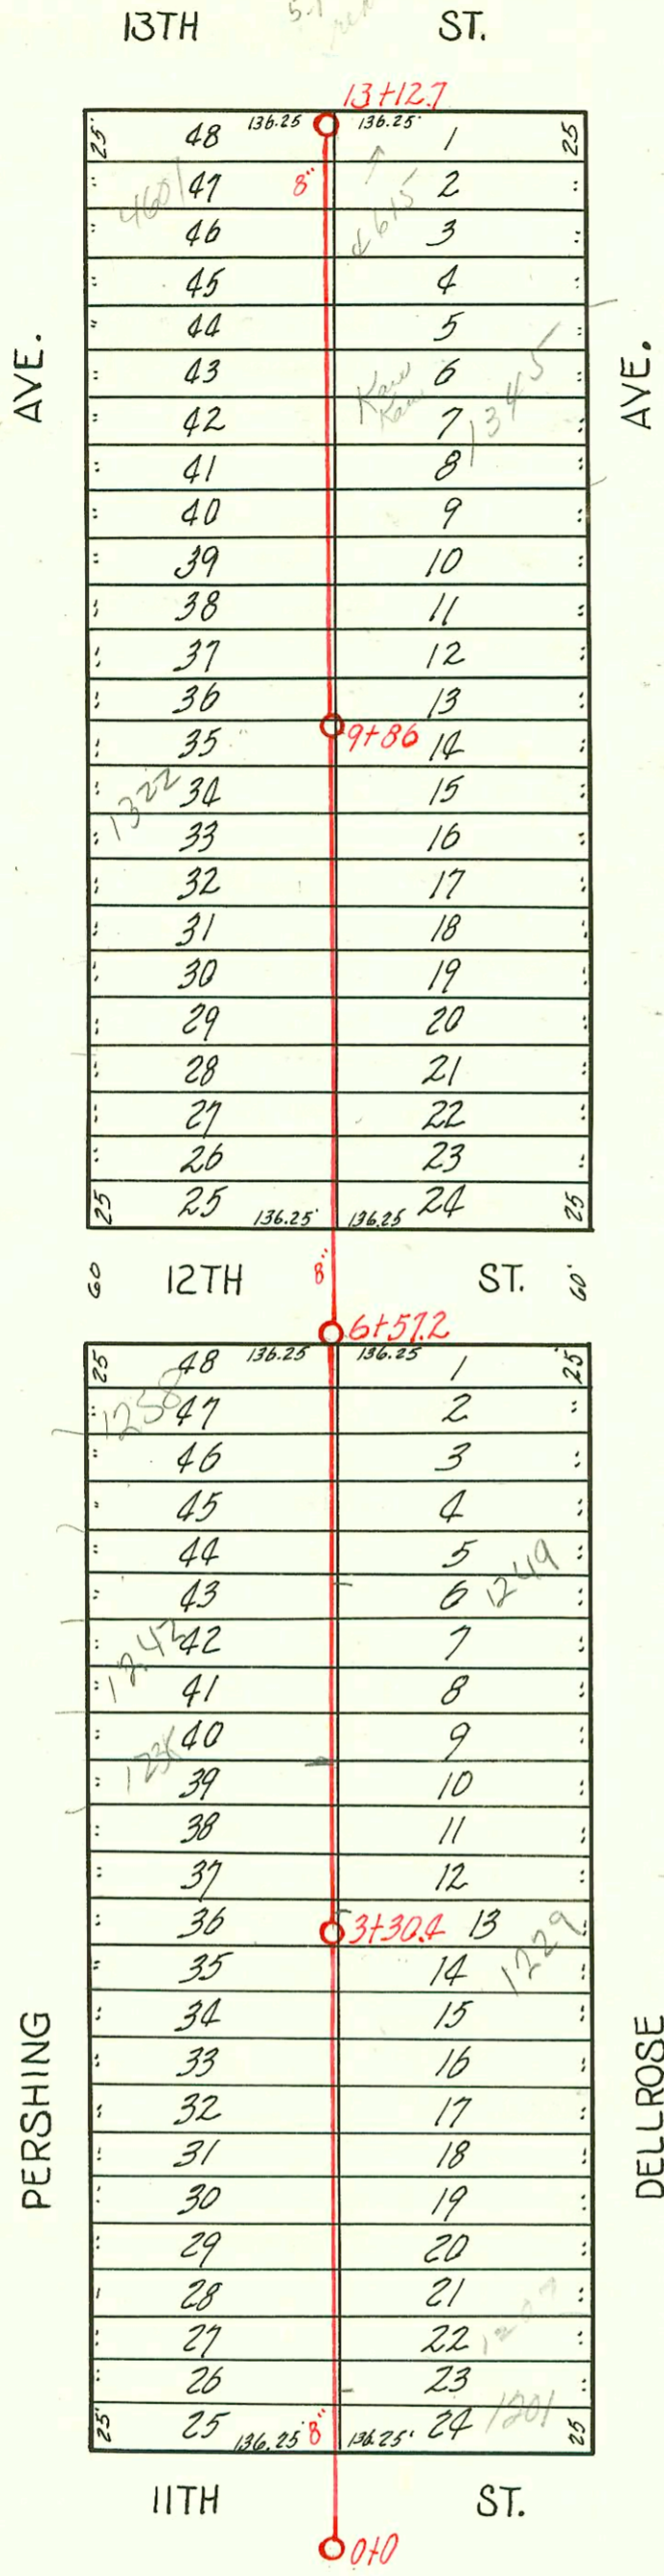

LAT. 13, D. C. S., S. S. 12

W. B. CARTER

1942

CONSTRUCTION RECORD							SERVICE RECORD					
STATION	ELEVATION		Depth	MANHOLE	4-INCH "Y" BRANCHES		No. of Permit		House Number		DATE OF PERMITS	
	Ground	Grade			North West	South East	North West	South East	North West	South East	North West	South East
0+0	203.80	194.00	9.8	0+0	0+71.8	0+68.8						
1+0	204.80	194.10	10.7		0+97.0	0+94.0	#1002	#2989	1202 N. Pershing	1201 N. Dellrose	8-23-43	11-6-42
					1+23.6	1+20.6		#433	1209 N. Dellrose			7-17-47
					1+47.7	1+44.7	#1003		1203 N. Pershing		8-23-43	
					1+72.2	1+69.2	#1009	#434	1212 N. Pershing	1211 N. Dellrose	1-8-48	7-17-47
					1+96.9	1+93.9		#201		1217 N. Dellrose		6-20-47
2+0	205.60	194.20	11.4		2+23.2	2+20.2	#788		1216 N. Pershing		9-24-47	
					2+47.2	2+44.2		#653		Dellrose		8-11-48
					2+72.0	2+69.0	#1004		1222 N. Pershing		8-23-43	
3+0	206.60	194.30	12.3		2+96.0	2+93.0	#1005		1228 N. Pershing		8-23-43	
				3+30.4	3+23.1	3+20.1						
					3+48.0	3+45.0		#202-01975	1229 N. Dellrose	R see below	7-18-62	
					3+72.7	3+69.7	#1006	#132	1232 N. Pershing	1233 N. Dellrose	8-23-43	6-3-48
					3+97.3	3+94.3			1239 N. Pershing	1237 N. Dellrose	2-23-49	7-17-47
4+0	207.60	194.40	13.2		4+21.0	4+18.0	#1984	#135	1244 N. Pershing	1243 N. Dellrose	8-23-43	7-17-47
					4+46.4	4+43.4	#1007	#436	1244 N. Pershing	1243 N. Dellrose	8-23-43	7-17-47
					4+72.2	4+69.2			1249 N. Pershing	1247 N. Dellrose	8-23-43	7-17-47
5+0	208.00	194.50	13.5		4+98.1	4+95.1	#1008	#437	1250 N. Pershing	1249 N. Dellrose	8-23-43	7-17-47
					5+21.5	5+18.5			1250 N. Pershing	1249 N. Dellrose	3-25-18	
					5+47.1	5+44.1	#1254		1259 N. Pershing	1259 N. Dellrose	1-30-47	11-6-42
					5+71.7	5+68.7	#1009	#2986	1259 N. Pershing	1259 N. Dellrose	8-23-43	11-6-42
6+0	208.40	194.60	13.8		5+96.2	5+93.2						
					6+23.2	6+20.2			1302 N. Pershing		8-30-43	
				6+57.2	6+47.9	6+44.9			1309 N. Pershing	1307 N. Dellrose	8-30-43	7-5-49
7+0	207.30	194.70	12.6		7+32.7	7+29.7	#1027		1312 N. Pershing		8-30-43	
					7+57.7	7+54.7	#1028	#768	1311 N. Pershing	1311 N. Dellrose	8-30-43	10-15-43
					7+82.1	7+79.1	#1029		1316 N. Pershing	1317 N. Dellrose	8-30-43	10-15-43
8+0	207.30	194.80	12.5		8+05.8	8+02.8			1322 N. Pershing		8-30-43	
					8+30.8	8+27.8	#1151		1323 N. Pershing	1323 N. Dellrose	10-11-43	
					8+57.9	8+54.9	#1030	#1150	1328 N. Pershing		10-11-43	
9+0	205.60	194.90	10.7		8+81.9	8+78.9						
					9+06.0	9+03.0	#1031		1329 N. Pershing	1329 N. Dellrose	10-11-43	
					9+31.0	9+28.0	#1149		1332 N. Pershing	1333 N. Dellrose	10-11-43	10-17-46
					9+55.0	9+52.0	#1140		1333 N. Pershing	1337 N. Dellrose	10-11-43	10-17-46
				9+86.0	9+77.3	9+74.3			1342 N. Pershing	1345 N. Dellrose	7-27-73	4-11-67
10+0	204.00	195.00	9.0		10+06.9	10+03.9	#1148		1342 N. Pershing	1343 N. Dellrose	10-11-43	4-10-67
					10+31.7	10+28.7	#1141	#802	1348 N. Pershing	1349 N. Dellrose	9-2-66	9-27-65
					10+58.3	10+55.3	#1142	#803	1352 N. Pershing	1352 N. Dellrose	9-2-66	10-11-43
11+0	203.40	195.10	8.3		10+83.7	10+80.7			1352 N. Pershing	1352 N. Dellrose	9-2-66	10-11-43
					11+07.4	11+04.4	#1143	#804	1352 N. Pershing	1352 N. Dellrose	9-2-66	10-11-43
					11+32.0	11+29.0	#1144	#805	1352 N. Pershing	1352 N. Dellrose	9-2-66	10-11-43
					11+57.7	11+54.7	#1145	#806	1352 N. Pershing	1352 N. Dellrose	9-2-66	10-11-43
					11+81.7	11+78.7	#1146	#807	1352 N. Pershing	1352 N. Dellrose	9-2-66	10-11-43
12+0	202.60	195.20	7.3		12+08.6	12+05.6	#1147	#808	1352 N. Pershing	1352 N. Dellrose	9-2-66	10-11-43
					12+33.3	12+30.3	#1148	#809	1352 N. Pershing	1352 N. Dellrose	9-2-66	10-11-43
					12+58.1	12+55.1	#1149	#810	1352 N. Pershing	1352 N. Dellrose	9-2-66	10-11-43
					12+82.1	12+79.1	#1150	#811	1352 N. Pershing	1352 N. Dellrose	9-2-66	10-11-43
13+0	204.00	195.30	8.7		13+05.8	13+02.8	#1151	#812	1352 N. Pershing	1352 N. Dellrose	9-2-66	10-11-43
	204.20	195.31	8.9	13+12.7								

2002-01975 7118ba 1229 N Dellrose, Jones

#258 - Tap - 1301 N. Dellrose - 6-19-47 - Burgan #1691  
 #C438 - Tap - 4601 E. 13th - 10-14-66 - R LaJay Pkwy (12+01.9) 6" Tap

Finished