



LATERAL 5 MAIN 13 WAR INDUSTRIES SEWER
 BUILT BY: MID STATES CONST. CO.
 PROJ. N^o 468-76-245-80469-000-000-001
 BOOKED 2-25-80 FROM AG 9

Draw NO

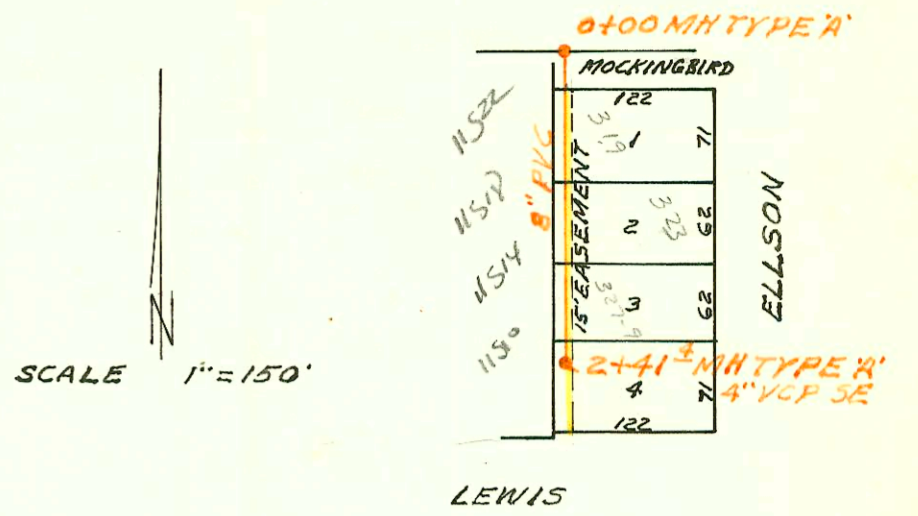

LATERAL 6 MAIN 22 WAR INDUSTRIES SEWER
 BUILT BY: W.B. CARTER CONST. CO.
 PROJ. N^o 468-76-245-80798-000-000-001
 BOOKED 2-28-80 FROM JLA 28

SCALE 1" = 200'

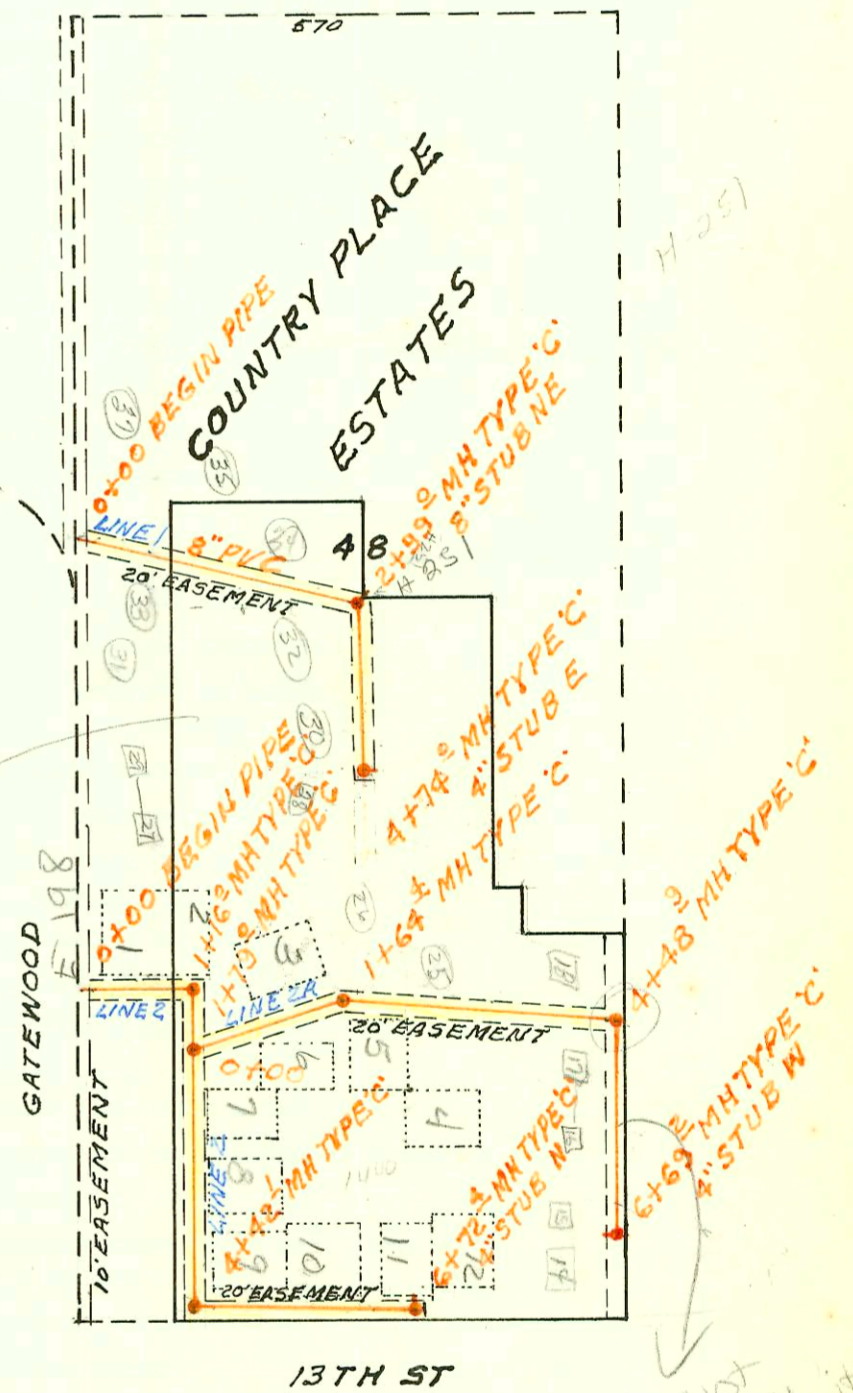

3/24/2003
 This area being
 platted into
 separate lots
 and ownership.
 Lawyer for Homeowner's
 Assoc will draw
 up agreement that
 grants different owners
 right to have sewer
 lines repaired if off
 their lot. Suggest
 Drain Layer advise
 homeowner to discuss
 issue with Homeowner's
 Assoc.
 BR

Do not
 issue any
 sewer permits
 to serve new
 plat East
 of this plat.
 2/12/02

