


See page 107 for wyes
West of 010 on lots 1 & 34.

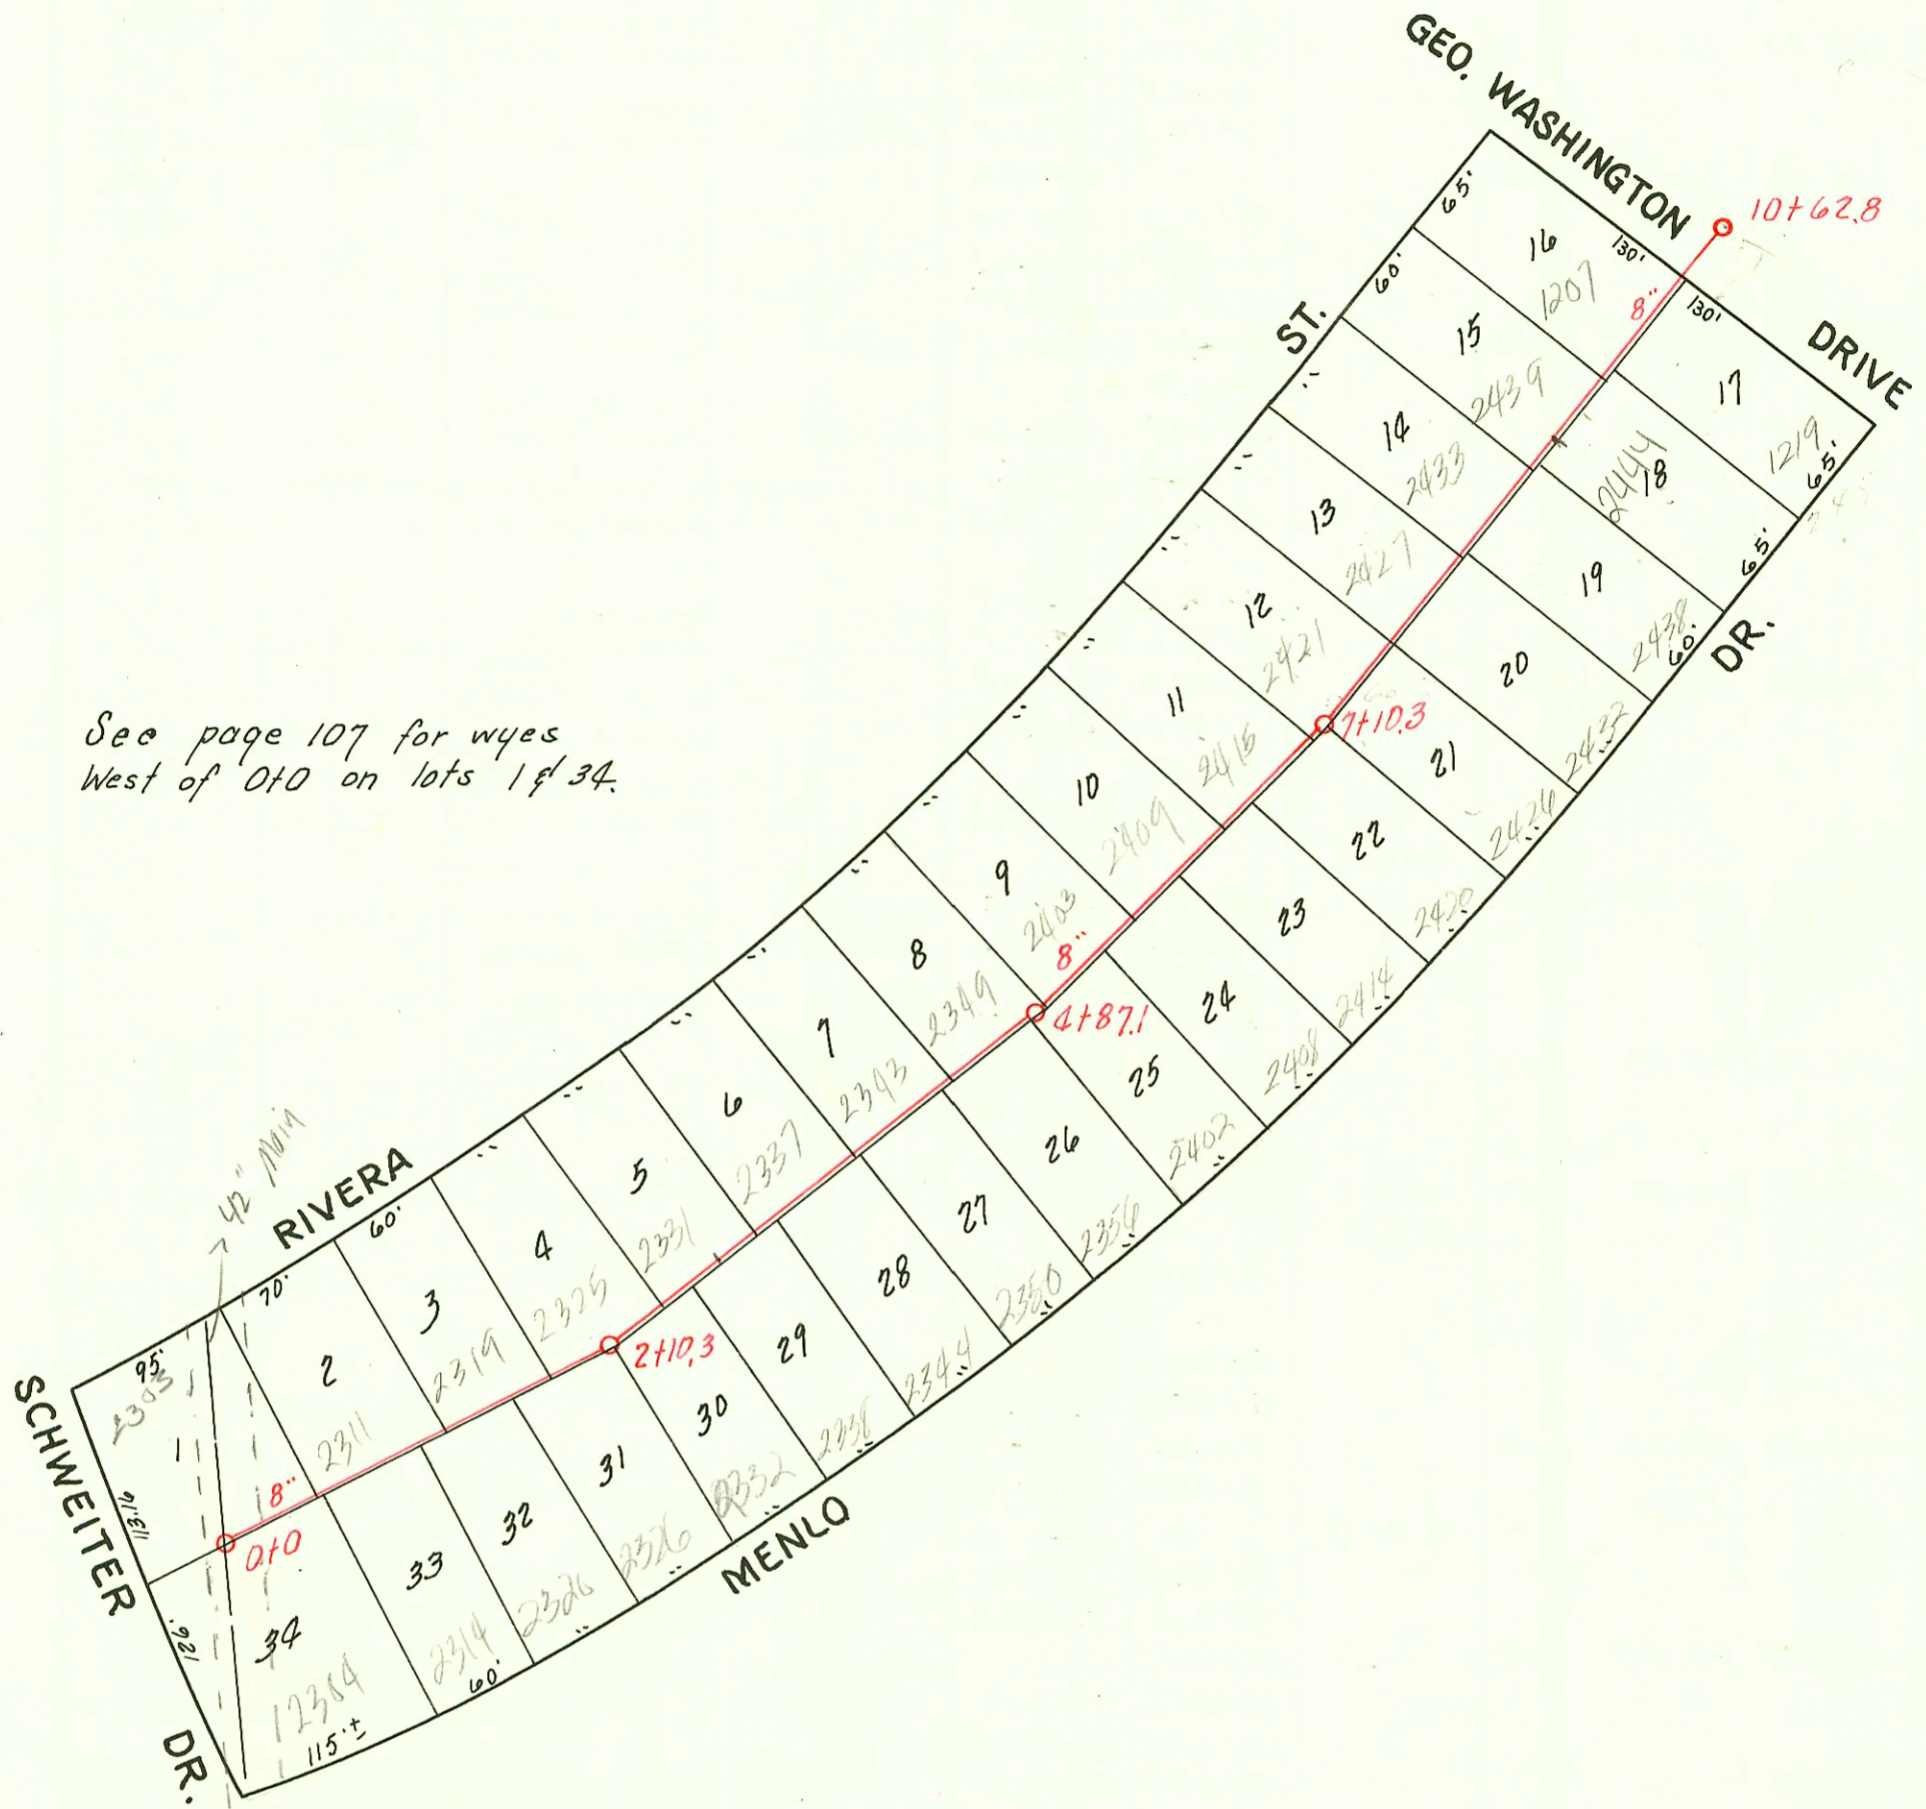

DIST. 9, S. S. # 12

W. B. CARTER 1942

CONSTRUCTION RECORD						SERVICE RECORD							
STATION	ELEVATION		Depth	MANHOLE	4-INCH "Y" BRANCHES		No. of Permit		House Number		DATE OF PERMITS		
	Ground	Grade			North West	South East	North West	South East	North West	South East	North West	South East	
0+0	103.40	95.00	8.40	0+0	0+08.6	0+11.6		#2641	2304	Menlo		7-1-42	
					0+40.7	0+43.7			2311	2314	Prince	8-20-42	
					0+84.2	0+72.4	#2555	#2640	2320	2326	Menlo	9-1-42	
						1+01.2			2319	2320	Menlo	9-1-42	
1+0	103.10	95.10	8.00		1+13.2	1+29.6	#2554	#2639	Rivera			8-20-42	
					1+47.1	1+53.6			2326			9-1-42	
					1+78.0	1+96.9		#2638	Menlo				
2+0	103.20	95.20	8.00	2+10.3	2+13.4	2+16.4	#2553	2002- 20071 #2637	2325 Rivera	2328 Menlo		8-20-42 3-19-42 7-1-42	
					2+47.9	2+63.7			2321			8-20-42	
					2+81.8	2+91.0	#2552	#2633	Rivera	2338		9-1-42	
3+0	103.20	95.30	7.90		3+12.0	3+18.5		#2636	2337	2344	Menlo	8-20-42	
					3+45.8	3+48.8	#2551	#2635	Rivera	Menlo		9-1-42	
					3+77.2	3+74.2			2303	2350		7-13-42	
4+0	102.90	95.40	7.50		4+14.1	4+02.5	#2550	#782	Rivera	Menlo		8-20-42	
					4+45.0	4+31.8			2304	2356		6-17-43	
					4+78.2	4+63.2	#2549	#731	Rivera	Menlo		8-20-42	
				4+87.1		4+92.6							
5+0	102.70	95.50	7.20		5+15.5	5+27.0	#2548	2001- 20053 #2634	2403 Rivera	2402 Menlo	AR see below	3-1-01 9-20-42 9-1-42	
					5+74.2	5+77.2		#2633	2408	Menlo		9-1-42	
6+0	102.40	95.60	6.80		6+04.2	6+07.2	#2547	#2632	2409 Rivera	2412 Menlo		8-20-42 9-1-42	
					6+35.0	6+58.5	#2546	#2631	2415 Rivera	2420 Menlo		8-20-42 9-21-42 9-1-42	
					6+71.2	6+85.6							
7+0	102.70	95.70	7.00	7+10.3	7+00.0	7+15.9			2421	2426	Rivera	Menlo	8-20-42
					7+37.7	7+40.7	#2545	#2630	Rivera	Menlo		9-1-42	
					7+64.0	7+73.7			2427	2432	Rivera	Menlo	8-20-42
					7+95.3	7+98.3	#2544	#2629	Rivera	Menlo		9-1-42	
8+0	103.00	95.80	7.20		8+25.0	8+28.0			2433	2438	Rivera	Menlo	8-20-42
					8+55.5	8+58.5	#2543	#2628	Rivera	Menlo		9-1-42	
					8+85.6	8+91.6			2439	2440	Rivera	Menlo	8-20-42
9+0	102.80	95.90	6.90		9+20.3	9+23.3	#2542	#2627	Rivera	Menlo		9-1-42	
					9+45.8	9+55.8	#2541	#2626	Geo Wash Geo Wash	Geo Wash Geo Wash		8-20-42	
					9+79.8	9+82.8							
	102.80	96.06	6.74	10+62.8									

2001-00453-2402 Menlo - 31101- Reddi Rootr - 4" SCH40 - CITY REPAIR 4" Predco, ITWINCO, 2VBA2