


BERRY ADDN SANITARY SEWER  
 BUILT BY: JIM & DAVE CONST. CO.  
 PROJ. N<sup>o</sup> 468-76-245-80828-000-000-008  
 BOOKED 3-8-80 FROM 261Y

*DN MZF*

ADJUSTMENTS OF CITY OWNED UTILITIES  
 FOR THE K-96 BYPASS  
 INDEX N<sup>o</sup>. 70021  
 Booked 11-12-91 from Plan

SCALE 1"=200'

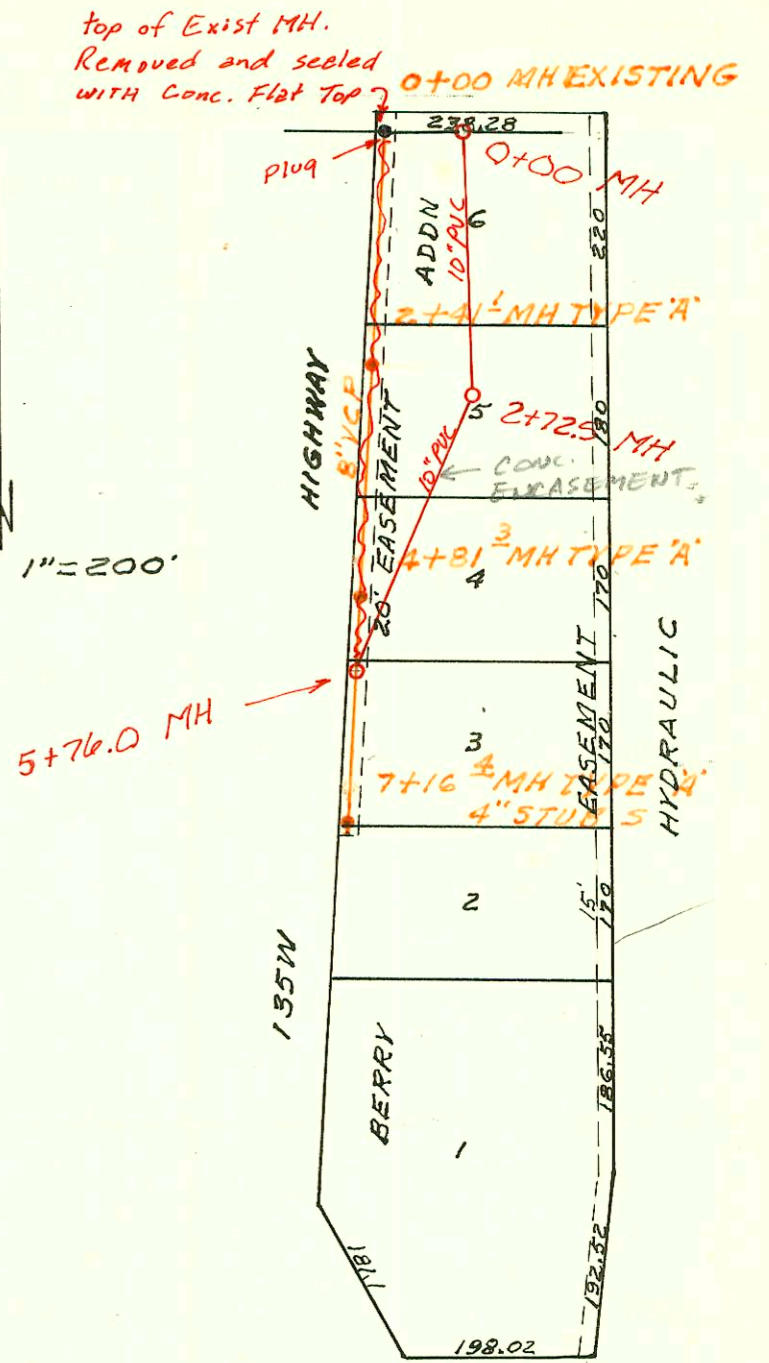


MAC ARTHUR

SCALE 1"=200'

MAC ARTHUR BEACH APTS SAN SEWER  
 BUILT BY: MID STATES CONST. CO.  
 PROJ. N<sup>o</sup> 468-76-245-80809-000-000-008  
 BOOKED 3-14-80 FROM 261Y

*DN MZF*

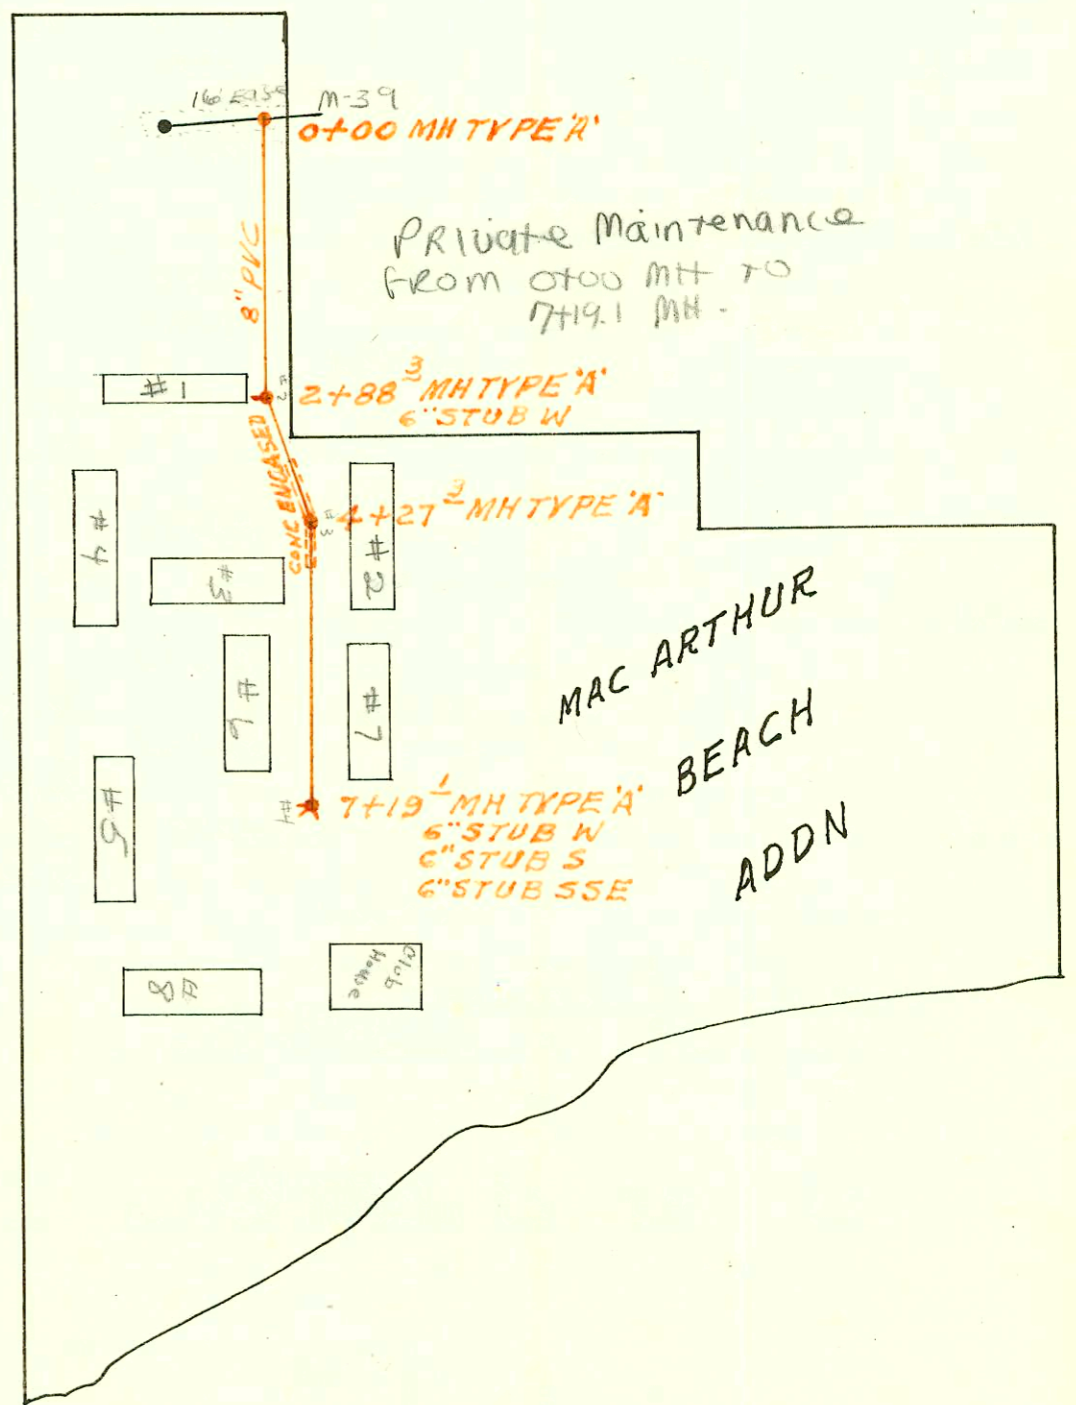

CONSTRUCTION RECORD

SERVICE RECORD

LINE #7  
See page 128 for Drawing.

| STATION | ELEVATION |        | Depth | MANHOLE | 4-INCH "Y" BRANCHES |            | No. of Permit |            | House Number |            | DATE OF PERMITS |            |            |            |
|---------|-----------|--------|-------|---------|---------------------|------------|---------------|------------|--------------|------------|-----------------|------------|------------|------------|
|         | Ground    | Grade  |       |         | North West          | South East | North West    | South East | North West   | South East | North West      | South East | North West | South East |
|         |           |        |       |         |                     |            |               |            |              |            |                 |            |            |            |
| 0+0     | 118.30    | 117.05 | 1.25  | 0+0     | 0+34.4              | 0+31.4     |               |            |              |            |                 |            |            |            |
|         |           |        |       |         | 0+63.8              | 0+60.8     | 6990          | 1729       | 2042         | 2051       | 6-1-67          | 3-12-71    |            |            |
|         |           |        |       |         | 0+88.3              | 0+85.3     |               |            |              |            |                 |            |            |            |
| 1+0     | 118.70    | 117.15 | 1.55  |         | 1+16.0              | 1+13.0     | 6991          | 1729       | 2042         | 2051       | 6-1-67          | 4-4-47     |            |            |
|         |           |        |       |         | 1+43.0              | 1+40.0     |               |            |              |            |                 |            |            |            |
|         |           |        |       |         | 1+73.9              | 1+70.9     | 6992          | 1729       | 2042         | 2051       | 6-1-67          | 4-4-47     |            |            |
| 2+0     | 119.60    | 117.25 | 2.35  |         | 2+00.9              | 1+97.9     |               |            |              |            |                 |            |            |            |
|         |           |        |       |         | 2+28.0              | 2+25.0     | 6993          | 1729       | 2042         | 2051       | 6-1-67          | 4-4-47     |            |            |
|         |           |        |       |         | 2+61.0              | 2+58.0     |               |            |              |            |                 |            |            |            |
|         |           |        |       |         | 2+91.4              | 2+88.4     | 6994          | 1729       | 2042         | 2051       | 6-1-67          | 4-4-47     |            |            |
| 3+0     | 118.80    | 117.35 | 1.45  |         | 3+24.2              | 3+21.2     |               |            |              |            |                 |            |            |            |
|         |           |        |       |         | 3+49.0              | 3+46.0     | 6995          | 1729       | 2042         | 2051       | 6-1-67          | 4-4-47     |            |            |
|         |           |        |       |         | 3+80.0              | 3+77.0     |               |            |              |            |                 |            |            |            |
| 4+0     | 119.90    | 117.45 | 2.45  |         | 4+06.8              | 4+03.8     |               |            |              |            |                 |            |            |            |
|         |           |        |       |         | 4+27.1              | 4+24.1     | 6996          | 1729       | 2042         | 2051       | 6-1-67          | 4-4-47     |            |            |
|         |           |        |       |         | 4+55.2              | 4+52.2     |               |            |              |            |                 |            |            |            |
|         | 119.30    | 117.52 | 1.78  | 4+70.4  |                     |            |               |            |              |            |                 |            |            |            |

BERRY ADDN SANITARY SEWER

|      |       |        |     |          |           |  |  |  |  |  |  |  |
|------|-------|--------|-----|----------|-----------|--|--|--|--|--|--|--|
| 0+00 | 133.1 | 123.22 | 9.9 | EXISTING |           |  |  |  |  |  |  |  |
| 1+00 | 132.8 | 123.44 | 9.4 |          |           |  |  |  |  |  |  |  |
| 2+00 | 132.2 | 123.67 | 8.5 |          |           |  |  |  |  |  |  |  |
|      | 132.0 | 123.76 | 8.2 | 2+41.1   |           |  |  |  |  |  |  |  |
| 3+00 | 131.7 | 123.89 | 7.8 |          |           |  |  |  |  |  |  |  |
| 4+00 | 131.2 | 124.12 | 7.1 |          |           |  |  |  |  |  |  |  |
|      | 130.9 | 124.30 | 6.6 | 4+81.3   |           |  |  |  |  |  |  |  |
| 5+00 | 130.8 | 124.34 | 6.5 |          |           |  |  |  |  |  |  |  |
| 6+00 | 130.5 | 124.57 | 5.9 |          |           |  |  |  |  |  |  |  |
| 7+00 | 130.8 | 124.79 | 6.0 |          |           |  |  |  |  |  |  |  |
|      | 130.8 | 124.83 | 6.0 | 7+16.4   | 4" STUB S |  |  |  |  |  |  |  |

MAC ARTHUR BEACH APTS SAN SEWER - (Private Maintenance)

|      |      |       |     |        |           |             |        |                     |                     |         |         |  |
|------|------|-------|-----|--------|-----------|-------------|--------|---------------------|---------------------|---------|---------|--|
| 0+00 | 95.2 | 85.45 | 9.8 | 0+00   |           |             |        |                     |                     |         |         |  |
| 1+00 |      | 85.65 |     |        |           |             |        |                     |                     |         |         |  |
| 2+00 |      | 85.85 |     |        |           |             |        |                     |                     |         |         |  |
|      | 89.0 | 86.02 | 3.0 | 2+88.3 | 6" STUB W | 073791      |        | 727 w Mac Arthur #1 |                     | 8-21-79 |         |  |
| 3+00 |      | 86.04 |     |        |           |             |        |                     |                     |         |         |  |
| 4+00 |      | 86.23 |     |        |           |             |        |                     |                     |         |         |  |
|      | 88.3 | 86.28 | 2.0 | 4+27.3 |           |             |        |                     |                     |         |         |  |
| 5+00 |      | 86.43 |     |        |           |             |        |                     |                     |         |         |  |
|      |      |       |     |        | 4+85.3    | 4+85.0      | 073794 | 073792              | 727 w Mac Arthur #2 | 8-21-79 | 8-21-79 |  |
| 6+00 |      | 86.64 |     |        |           |             |        |                     |                     |         |         |  |
|      |      |       |     |        | 5+20.9    |             | 073793 |                     | 727 w Mac Arthur #3 | 8-21-79 |         |  |
| 7+00 |      | 86.84 |     |        |           |             |        |                     |                     |         |         |  |
|      |      |       |     |        | 6+64.7    | 6+04.6      | 073796 |                     | 727 w Mac Arthur #7 | 8-21-79 |         |  |
|      |      |       |     |        | 7+15.1    |             | 964597 |                     | 727 w Mac Arthur #6 | 4-5-76  |         |  |
|      | 89.1 | 86.88 | 2.2 | 7+19.1 | 6" STUB W | 6" STUB SSE | 073795 | 073798              | 727 w Mac Arthur #5 | 8-21-79 | 8-21-79 |  |

Adjustments to CITY OWNED UTILITIES FOR K-96 BYPASS

|      |        |        |      |        |  |  |  |  |  |  |  |  |
|------|--------|--------|------|--------|--|--|--|--|--|--|--|--|
| 0+00 | 134.00 | 123.16 | 10.8 | 0+00   |  |  |  |  |  |  |  |  |
| 1+00 | 145.1  | 123.34 | 21.8 |        |  |  |  |  |  |  |  |  |
| 2+00 | 136.8  | 123.52 | 13.3 |        |  |  |  |  |  |  |  |  |
|      | 137.00 | 123.65 | 13.4 | 2+72.5 |  |  |  |  |  |  |  |  |
| 3+00 | 144.1  | 123.71 | 20.4 |        |  |  |  |  |  |  |  |  |
| 4+00 | 161.6  | 123.88 | 37.7 |        |  |  |  |  |  |  |  |  |
| 5+00 | 132.6  | 124.06 | 8.5  |        |  |  |  |  |  |  |  |  |
|      | 131.50 | 124.20 | 7.3  | 5+76.0 |  |  |  |  |  |  |  |  |

96-4597-7 4-5-96 727 w Mac Arthur - ground water clean up line  
AKA 901 w Mac Arthur FOR OKY USA INC - 4" PVC SCH 40 - top 3' N of MH #4