


21 ST ST.

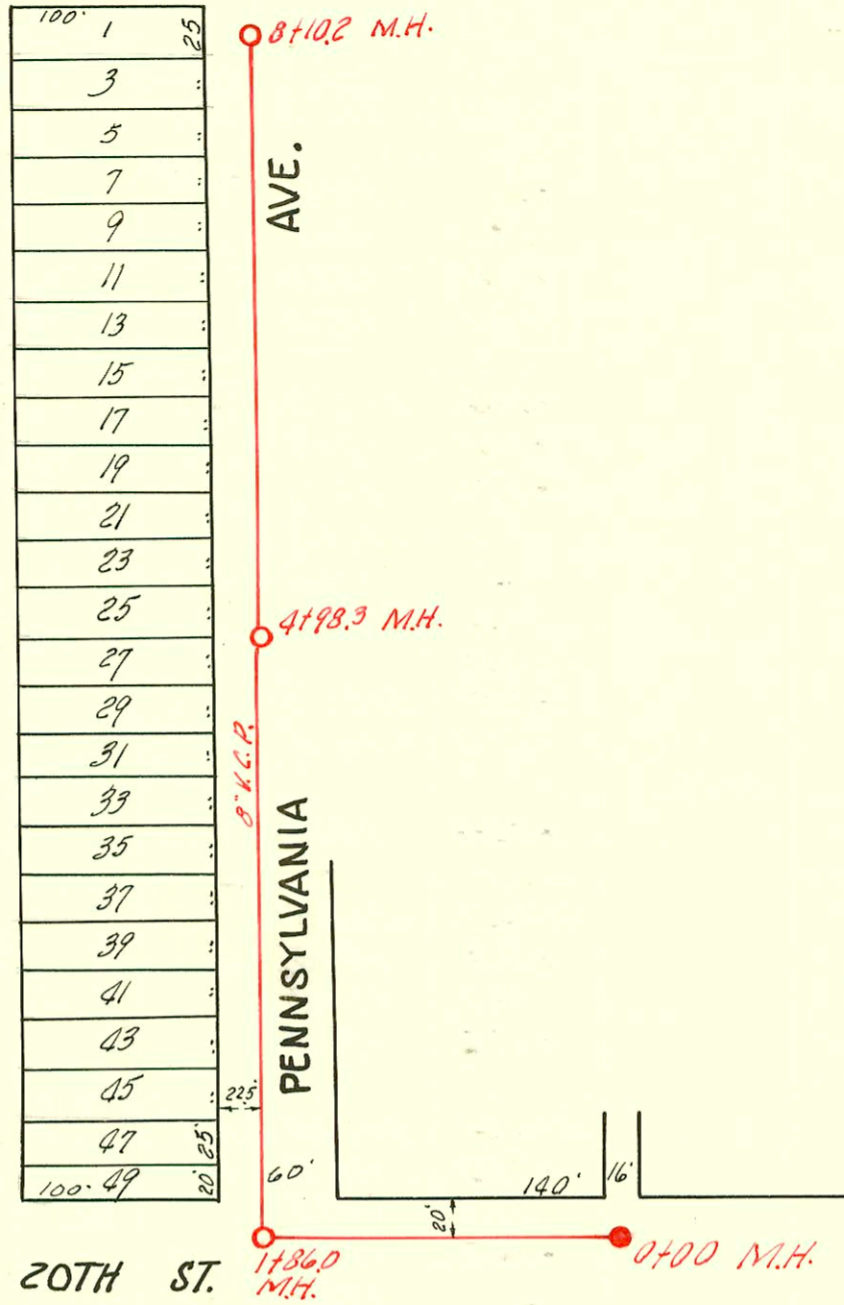

LAT. 4, DIST. T, S.S.#12

W. B. CARTER

1946

CONSTRUCTION RECORD						SERVICE RECORD						
STATION	ELEVATION		Depth	MANHOLE	4-INCH "Y" BRANCHES		No. of Permit		House Number		DATE OF PERMITS	
	Ground	Grade			North West	South East	North West	South East	North West	South East	North West	South East
0+0	121.9	116.66	5.60	Old M.H. 0+00								
1+0	122.6	116.76	6.10									
2+0	122.2	116.96	5.62	1+86								
					2+09.1							
					+33.0							
					+57.4							
					+81.7							
3+0	121.9	117.06	5.28									
					3+06.4							
					+27.4							
					+54.3							
					+78.6							
4+0	122.0	117.16	5.35									
					4+02.6							
					+30.2							
					+54.0							
					+81.0							
5+0	122.3	117.26	5.58	4+98.3								
					5+05.0							
					+33.2							
					+56.7							
					+82.0							
6+0	122.5	117.36	5.32									
					6+05.5							
					+29.7							
					+47.4							
					+72.2							
7+0	122.8	117.46	5.85									
					7+08.0							
					+23.0							
					+56.6							
					+80.5							
					+98.6							
8+0	122.9	117.56	6.42	8+10.2								

Permit # 3925
1277

2101
Penn.

8-6-65
12-11-46

Permit # 408
Seal off # 5683
113

2105
2111
Seal off
Penn.

8-17-65
3-23-54
5-19-66
7-22-49

Permit # 5664
Seal off # 3994

2121
Seal off
Penn.

5-19-66
11-6-50

Permit # 5665
Seal off # 3193

2127 Seal off
Pennsylvania

5-19-66
11-27-50

2355

2145
Pennsylvania

9-13-50

2356

2151
Pennsylvania

9-13-50