


LATERAL 5 MAIN 22 WAR INDUSTRIES SEW
 BUILT BY: W.B. CARTER CONST. CO.
 PROJ. NO 468-76-245-80718-000-000-001
 PHASE I
 BOOKED 3-15-80 FROM SRL 10
 PHASE II
 BOOKED 3-25-81 FROM DCD 24
 LATERAL 9 MAIN 22 WAR INDUSTRIES SEWER
 BUILT BY: W.B. CARTER CONST. CO.
 PROJ. NO 468-76-245-80840-000-000-001
 BOOKED 3-25-81 FROM AR 85

on map
13-40

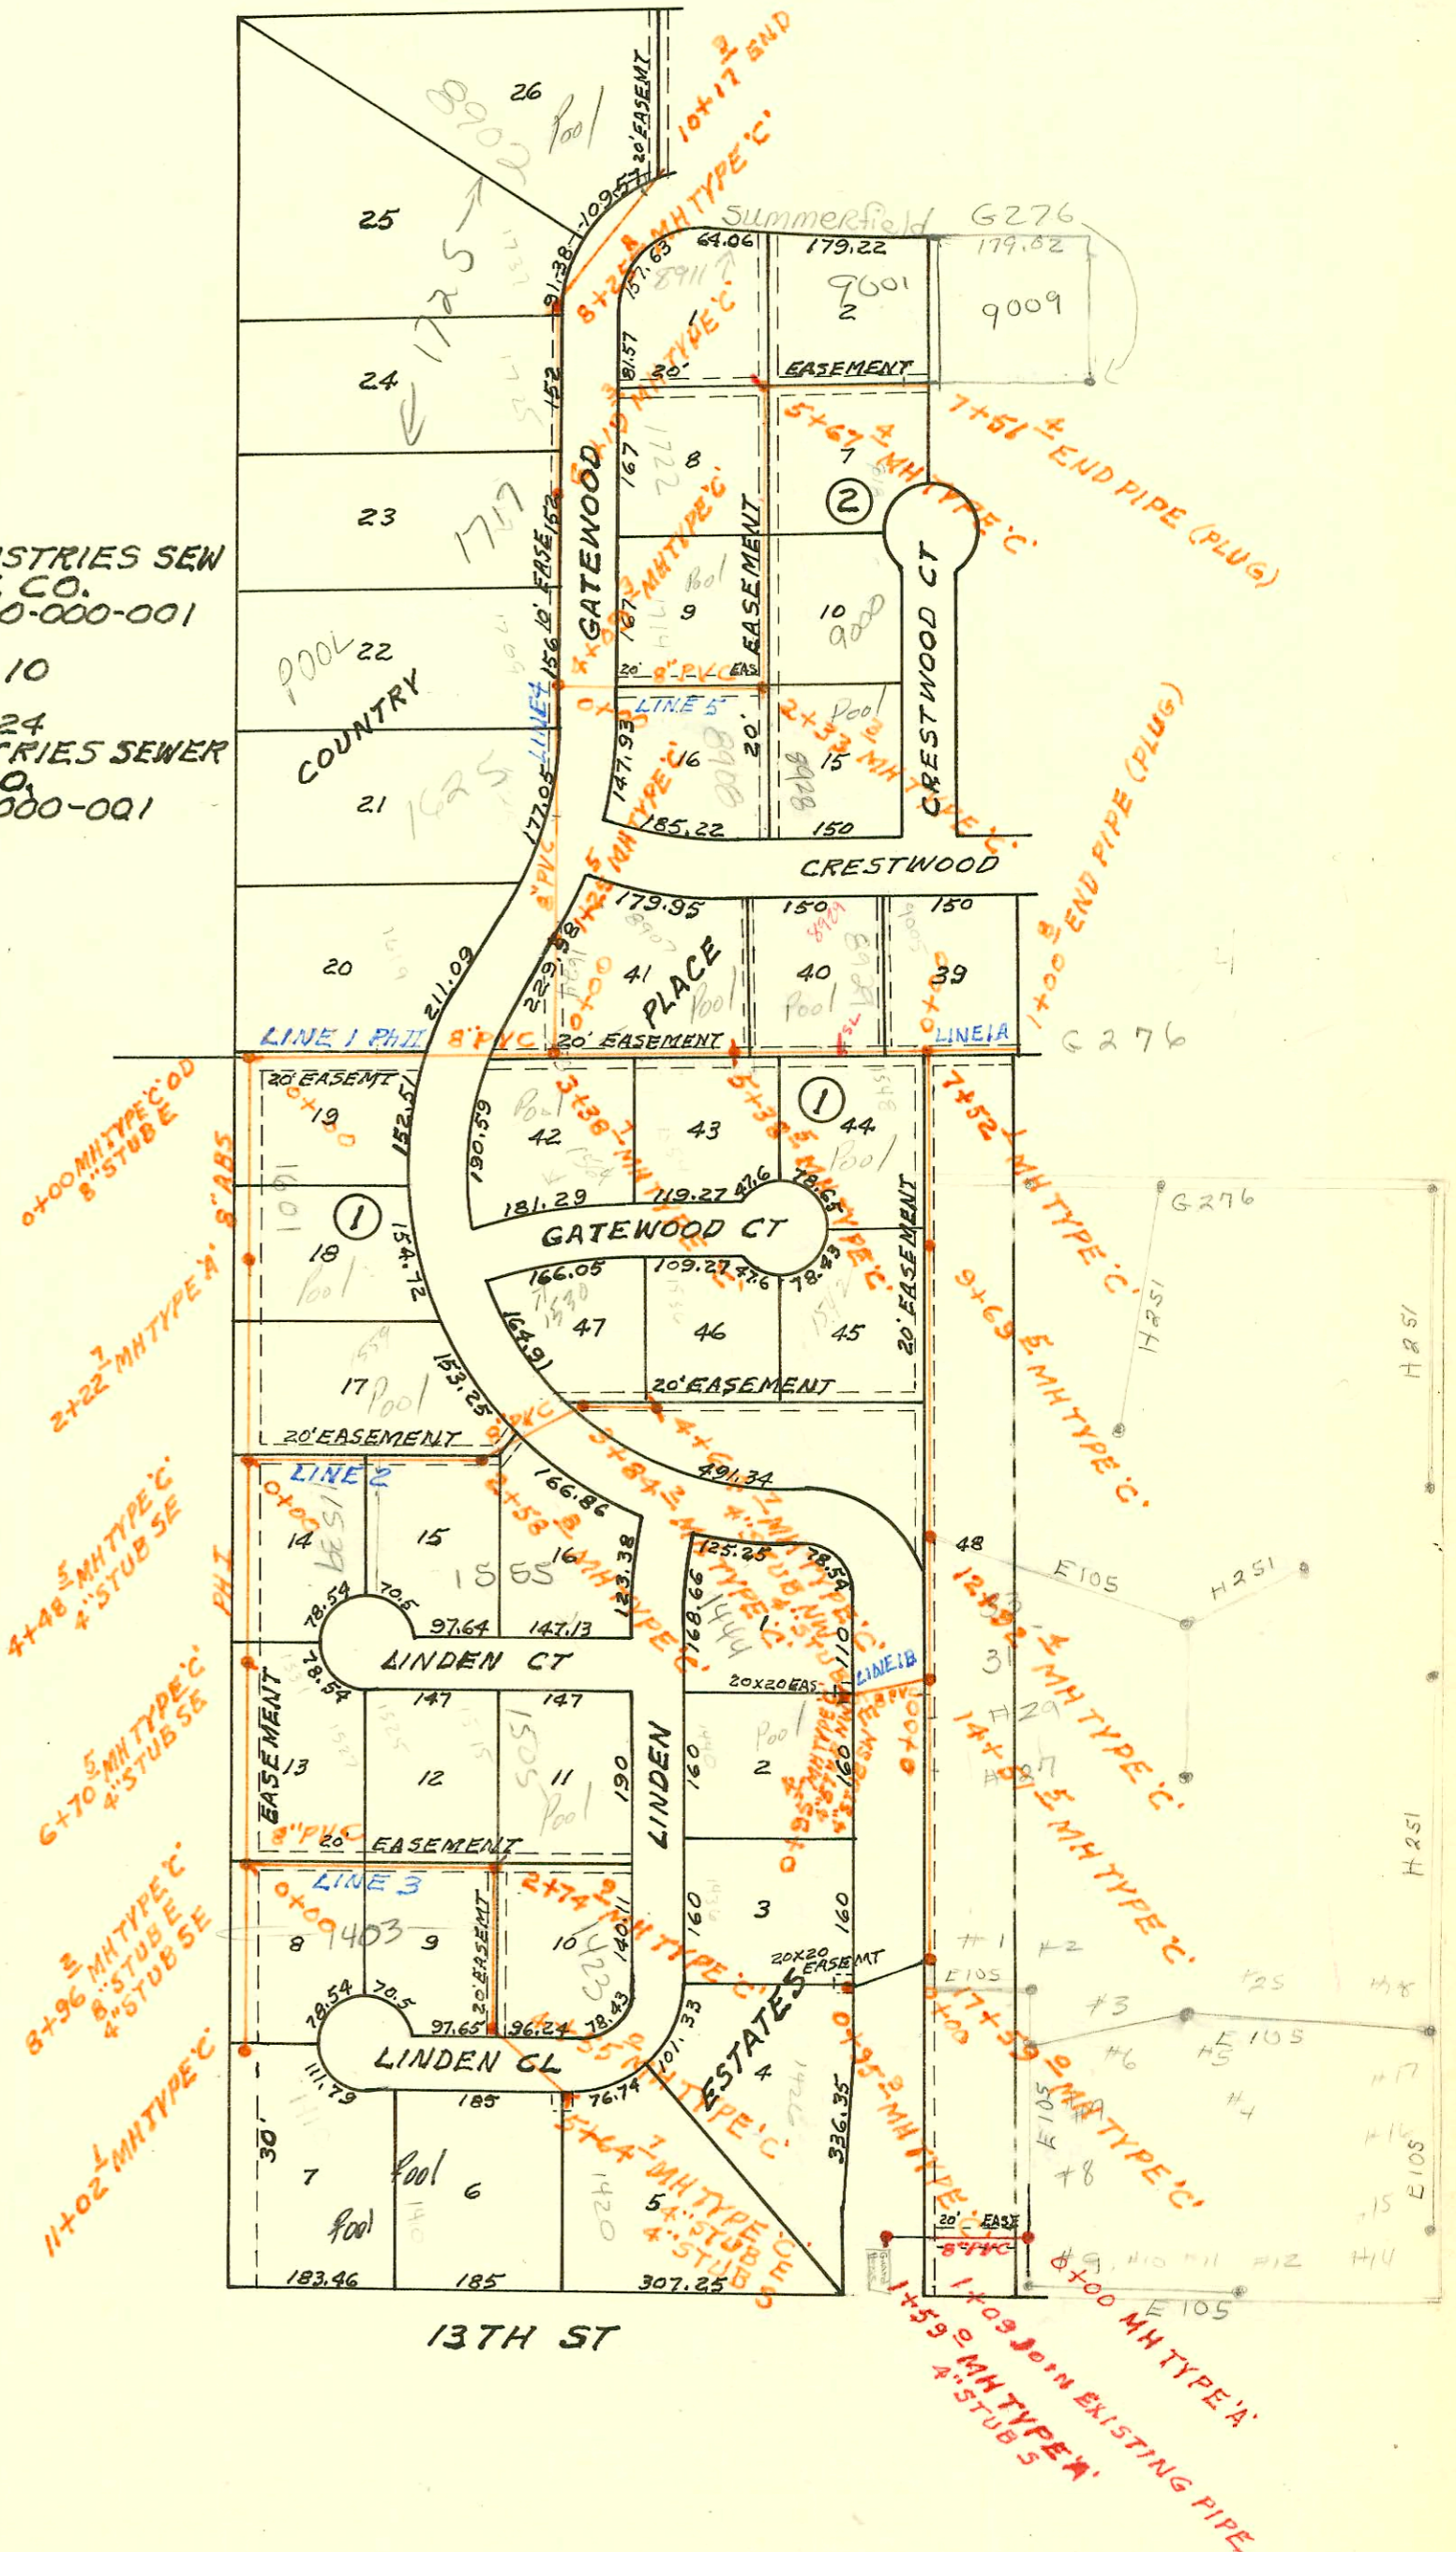

CONSTRUCTION RECORD

SERVICE RECORD

STATION	ELEVATION		Depth	MANHOLE	4-INCH "Y" BRANCHES		No. of Permit		House Number		DATE OF PERMITS	
	Ground	Grade			North West	South East	North West	South East	North West	South East	North West	South East
LATERAL 5 MAIN 22 WAR INDUSTRIES SEWER												
PHASE I 0+00	177.3	169.80	7.5	0+00		8" STUB E 30+80.6		276024		1601 Gatewood		1-8-80
1+00	176.8	170.20	6.6									
2+00	176.9	170.60	6.3									
	177.5	170.69	6.8	2+22.7								
3+00	179.6	171.00	8.6			3+64.5		7655		1539 Gatewood		3-11-83
4+00	182.5	171.40	11.1									
	183.7	171.59	12.1	4+48.5		4" STUB SE						
5+00	184.7	171.80	12.9			5+08.7		762		1539 Gatewood		7-16-81
6+00	186.3	172.20	14.1									
	187.1	172.49	14.6	6+70.5		4" STUB SE						
7+00	187.2	172.60	14.6									
8+00	186.7	173.00	13.7									
	185.3	173.38	11.9	8+96.2		8" STUB E 4" STUB SE		219061		1403 Linden CL		5-10-91
9+00	185.3	173.40	11.9									
10+00	183.9	173.80	10.1									
11+00	182.2	174.20	8.0									
	182.2	174.21	8.0	11+02.1		M N Cement Tap		275783		1410 Linden CL		12-19-79
PHASE II LINE I 0+00	177.19	166.66	10.5	0+00=0+00 Phase I								
1+00	179.2	167.38	11.8			1+47.0		4280		1619 Gatewood		10-8-81
2+00	180.4	168.10	12.3									
3+00	182.7	168.82	13.9									
	183.15	169.10 173.03	14.1 10.1	3+38.7		3+50.7		10897		1564 Gatewood		5-11-84
						3+66.7		3276		1624 Gatewood		5-12-81
4+00	184.7	173.31	11.4									
5+00	185.8	173.76	12.0									
	186.21	173.93	12.3	5+38.5		4" STUB N 4" STUB S		17461		1554 Gatewood		12-15-81
6+00	188.0	174.21	13.8									
						6+02.5		1533		1548 Gatewood		10-17-80
						6+57.1		2010		8939 Gatewood		12-4-80
7+00	190.0	174.66	15.3									
	190.67	174.88 174.98	15.8 15.7	7+52.1								
8+00	190.3	175.20	15.1									
9+00	188.6	175.65	13.0									
	189.52	175.96	13.6	9+69.5		8" stub E						
10+00	189.7	175.10	14.6									
						10+64.5		11149		1542 Gatewood		6-8-84
11+00	190.3	176.55	13.8									
12+00	191.5	177.00	14.5									
	192.71	177.41	15.3	12+92.4		8" STUB E						
13+00	192.8	177.45	15.4									
14+00	192.7	177.90	14.8									
	190.62	178.13	12.5	14+51.5								
						14193.5		1923		1440 Gatewood		11-19-80
15+00	192.2	178.35	13.9									
						15+51.5		1922		1440 Gatewood		11-19-80
16+00	192.7	178.80	13.9									

CONT'D NEXT PAGE

98-4922-7 4/8/92 - 1555 W. Linden ct (Det'd Garage Consecutive) N/C - Beund P/bj-