


LATERAL 5 MAIN 22 WAR INDUSTRIES SEW
 BUILT BY: W.B. CARTER CONST. CO.
 PROJ. NO 468-76-245-80718-000-000-001
 PHASE I
 BOOKED 3-15-80 FROM SRL 10
 PHASE II
 BOOKED 3-25-81 FROM DCD 24
 LATERAL 9 MAIN 22 WAR INDUSTRIES SEWER
 BUILT BY: W.B. CARTER CONST. CO.
 PROJ. NO 468-76-245-80840-000-000-001
 BOOKED 3-25-81 FROM AR 85

on map
13-40

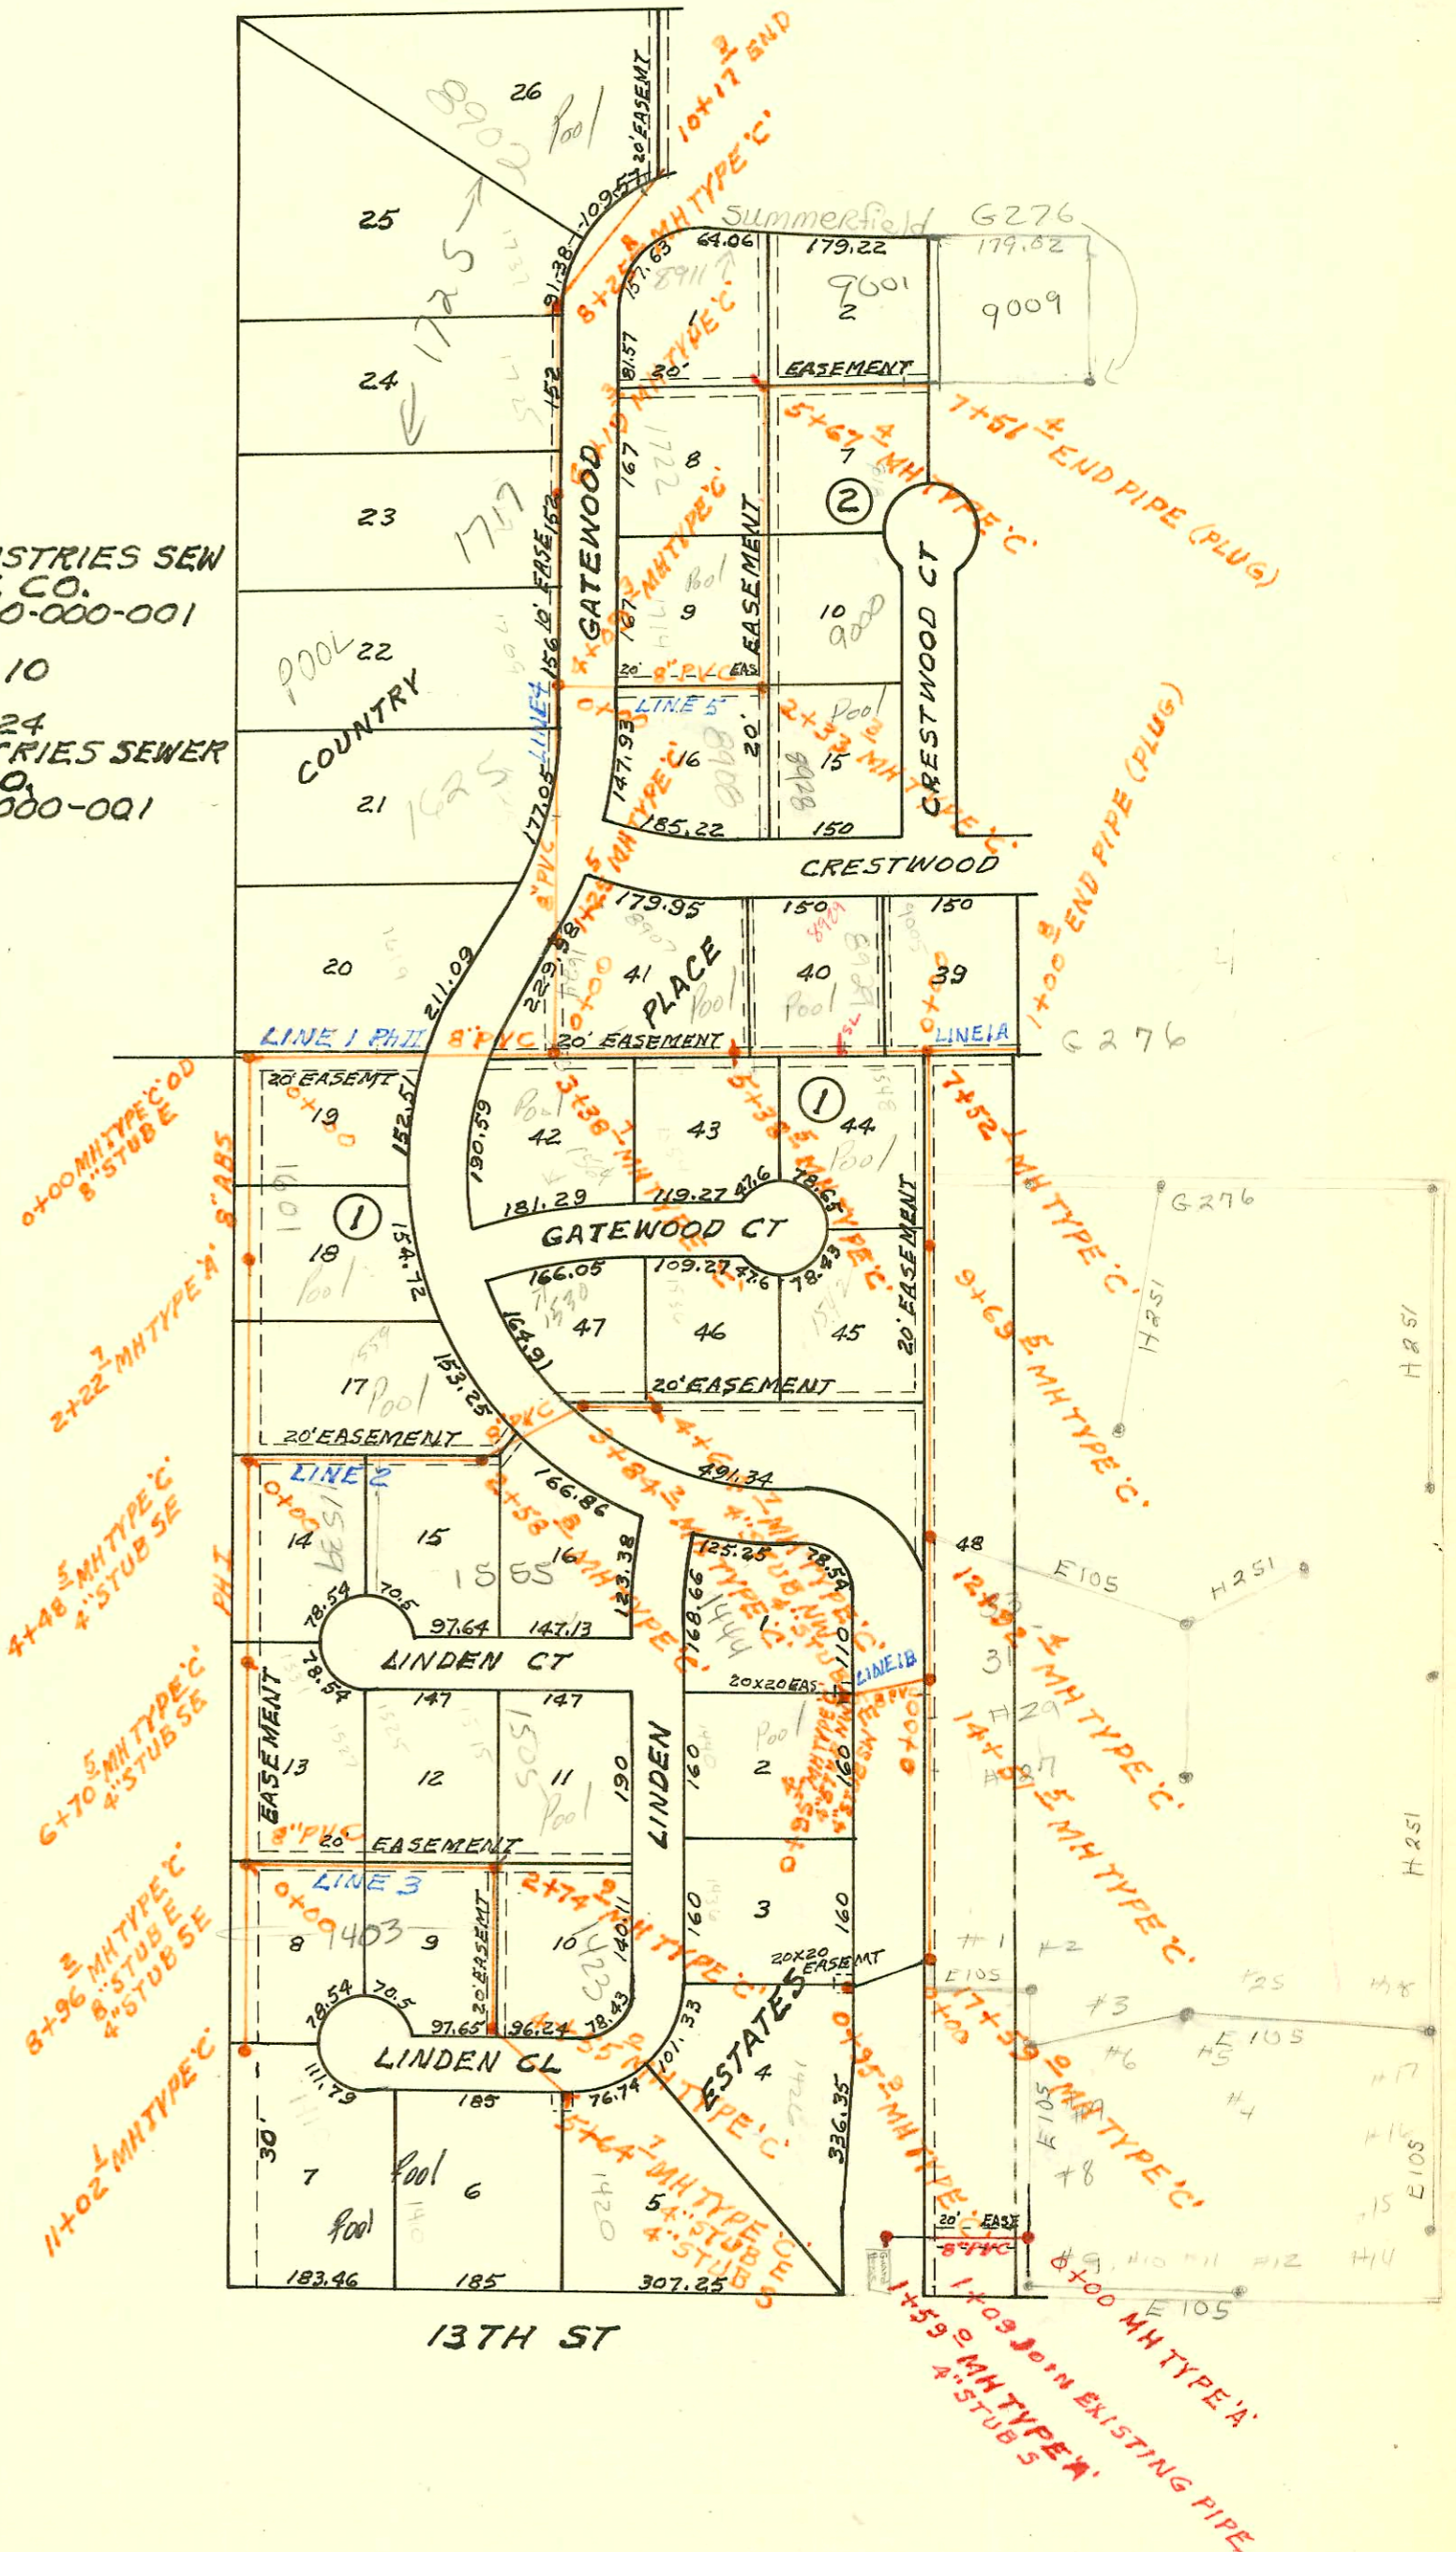

CONSTRUCTION RECORD

SERVICE RECORD

STATION	ELEVATION		Depth	MANHOLE	4-INCH "Y" BRANCHES		No. of Permit		House Number		DATE OF PERMITS	
	Ground	Grade			North West	South East	North West	South East	North West	South East	North West	South East
LAT 5 MAIN 22 WIS (CONT'D)												
LINE 1 CONT'D 17+00	193.2	179.25	14.0									
	194.2	179.51	14.7	17+59.0	8" STUB E							
LINE 2 0+00	184.0	171.79	12.2	0+00 = 4+48.5 Phase I								
1+00	182.7	172.19	11.5		1+03.8 ^{8"}		5970		1559 Gatewood		6-8-82	
2+00	182.7	172.59	10.1		4" PVC 40 2+16.8 TAP		924932-7		1555 De Linden St	old Gatewood & Conservatory	4-8-82	
	185.2	172.83	12.4	2+58.8								
		172.93	12.3		2+29.8 ^{8"}		20067		1555 Linden St		2-9-88	
3+00	182.8	173.09	9.7									
	184.7	173.43	11.3	3+84.2								
		173.63	11.2		3+93.2		14971		1530 Gatewood		11-4-85	
4+00	184.7	173.59	11.1									
	185.2	173.85	11.4	4+64.7	4" STUB NW 4" STUB SE		6967		1536 Gatewood		11-10-82	
LINE 3 0+00	185.51	174.48	11.0	0+00 = 8+96.2 Phase I								
1+00	186.8	174.88	11.9									
2+00	189.0	175.28	13.7		2+00.9 ^{8"} 4" STUB NE		13455		1515 Linden St		4-12-85	
	190.3	175.38	14.7	2+74.9			8418		15051 Linden		7-5-83	
		175.68	14.6									
3+00	190.2	175.78	14.4		3+06.9 ^{8"}		4603		1423 Linden		10-30-81	
4+00	189.3	176.18	13.1									
	188.5	176.40	12.1	4+55.0								
		176.60	12.0									
5+00	188.4	176.68	11.7									
	189.7	176.94	12.8	5+64.7	4" STUB E 4" STUB S		3457		1480 Linden		2-8-81	
LINE 4 0+00	183.2	169.20	14.0	0+00 = 3+38.7 LINE 1								
1+00	183.5	169.83	13.7									
	184.3	169.99	14.3	1+25.5								
2+00	183.6	170.46	13.1									
3+00	178.5	171.09	7.4		2+60.3 TAP		23082		1625 N. Gatewood		5-8-89 (McCullough)	
4+00	177.6	171.72	5.9									
	182.9	171.78	11.1	4+09.3	4+55.8 ^{8"}		12775		1709 Gatewood		12-12-84	
5+00	179.7	172.35	7.4									
6+00	181.7	172.98	8.7									
	184.7	173.10	11.6	6+19.3	5+98.3 TAP		26589		1717 N Gatewood		11-21-90	
7+00	181.7	173.61	8.1									
8+00	184.7	174.24	10.5									
	185.8	174.40	11.4	8+25.8								
		174.50	11.3									
9+00	186.6	175.23	11.4									
10+00	186.0	176.21	9.8		9+87.9 ^{8"}		658		8902 Summerfield		6-30-80	
10+17.9	186.0	176.38	9.6	(PLUG)								
LINE 5 0+00	182.9	171.88	11.0	0+00 = 4+09.3 LINE 4								
1+00	182.9	172.44	10.5									
					1+22.8 ^{8"}		2340		8908 Gatewood		1-12-81	
2+00	183.6	173.00	10.6									
	188.1	173.19	14.9	2+33.3	M.H. tap on 4" SDR 35 3+41.9 tap		6359		8928 E Gatewood		8-17-82	
		173.29	14.8				15716		1714 Gatewood		2-27-86	7-16-91
3+00	186.0	173.66	12.3									

CONT'D NEXT PAGE

3+00
2+33.3

E199B

Form 42-020

CONSTRUCTION RECORD

SERVICE RECORD

STATION	ELEVATION		Depth	MANHOLE	4-INCH "Y" BRANCHES		No. of Permit		House Number		DATE OF PERMITS	
	Ground	Grade			North West	South East	North West	South East	North West	South East	North West	South East
LAT 5 MAIN 22 WIS (CONT'D)												
LIN 5 CONT'D 4+00	188.0	174.22	13.8		4+41.9 tag		603		1722 Oakwood		603	
5+00	187.6	174.78	12.8						8711 E. Sunnyside		7-22-86	
	187.8	175.16 177.20	12.6 10.2	5+67.4	4" STUB NW 4" STUB SE		16652					
6+00	189.2	177.48	11.7									
7+00	191.2	178.33	12.9		7+77.4 tag		8859		9001 Sunnyside		8-1-83	
7+51.4	192.4	178.76	13.6	(PLUG)								
LINE IA 0+00 190.9 179.01 11.9 0+00 = 7+52.1 10+26.5 11.9 LINE 1												
1+00	192.7	180.34	12.4									
	192.7	180.35	12.4	1+00.8								
LINE IB 0+00 190.8 178.22 12.6 0+00 = 14+51.5 LINE 1												
	190.0	178.60	11.4	0+95.4	4" STUB NW 4" STUB SW		15102	16405 145-49	1440 Linden	Red L seen next pg 1440 Linden Bath House 11-23-85	6-3-86 8-20-85	
LINE IC 0+00 193.6 179.62 14.0 0+00 = 17+59.0 LINE 1												
	194.2	180.00	14.2	0+95.9	4" STUB SW		8128	1494	1456 Linden	1426 Linden	5-11-83	10-13-80
LATERAL 9 MAIN 22 WAR INDUSTRIES SEWER												
0+00	197.7	190.38	7.3	0+00								
1+00	197.5	191.18	6.3									
1+09	197.6	191.25	6.4	JOIN EXISTING PIPE								
	197.4	191.65	5.8	1+59.0	4" STUB S		458		1440 (Guard Gate) Oakwood		6-5-80	

2003-02665- 10/15/03 - 1444 N Linden Ln - Reroute line around pool - from house - (4" SDR35) to H45 -
up west side of pool to H45 across N side of pool to H45 down SE to dir'clo (wye)
to H45 to SDR 35 MH STUB (Stub SDR35)