


TRAP AREA

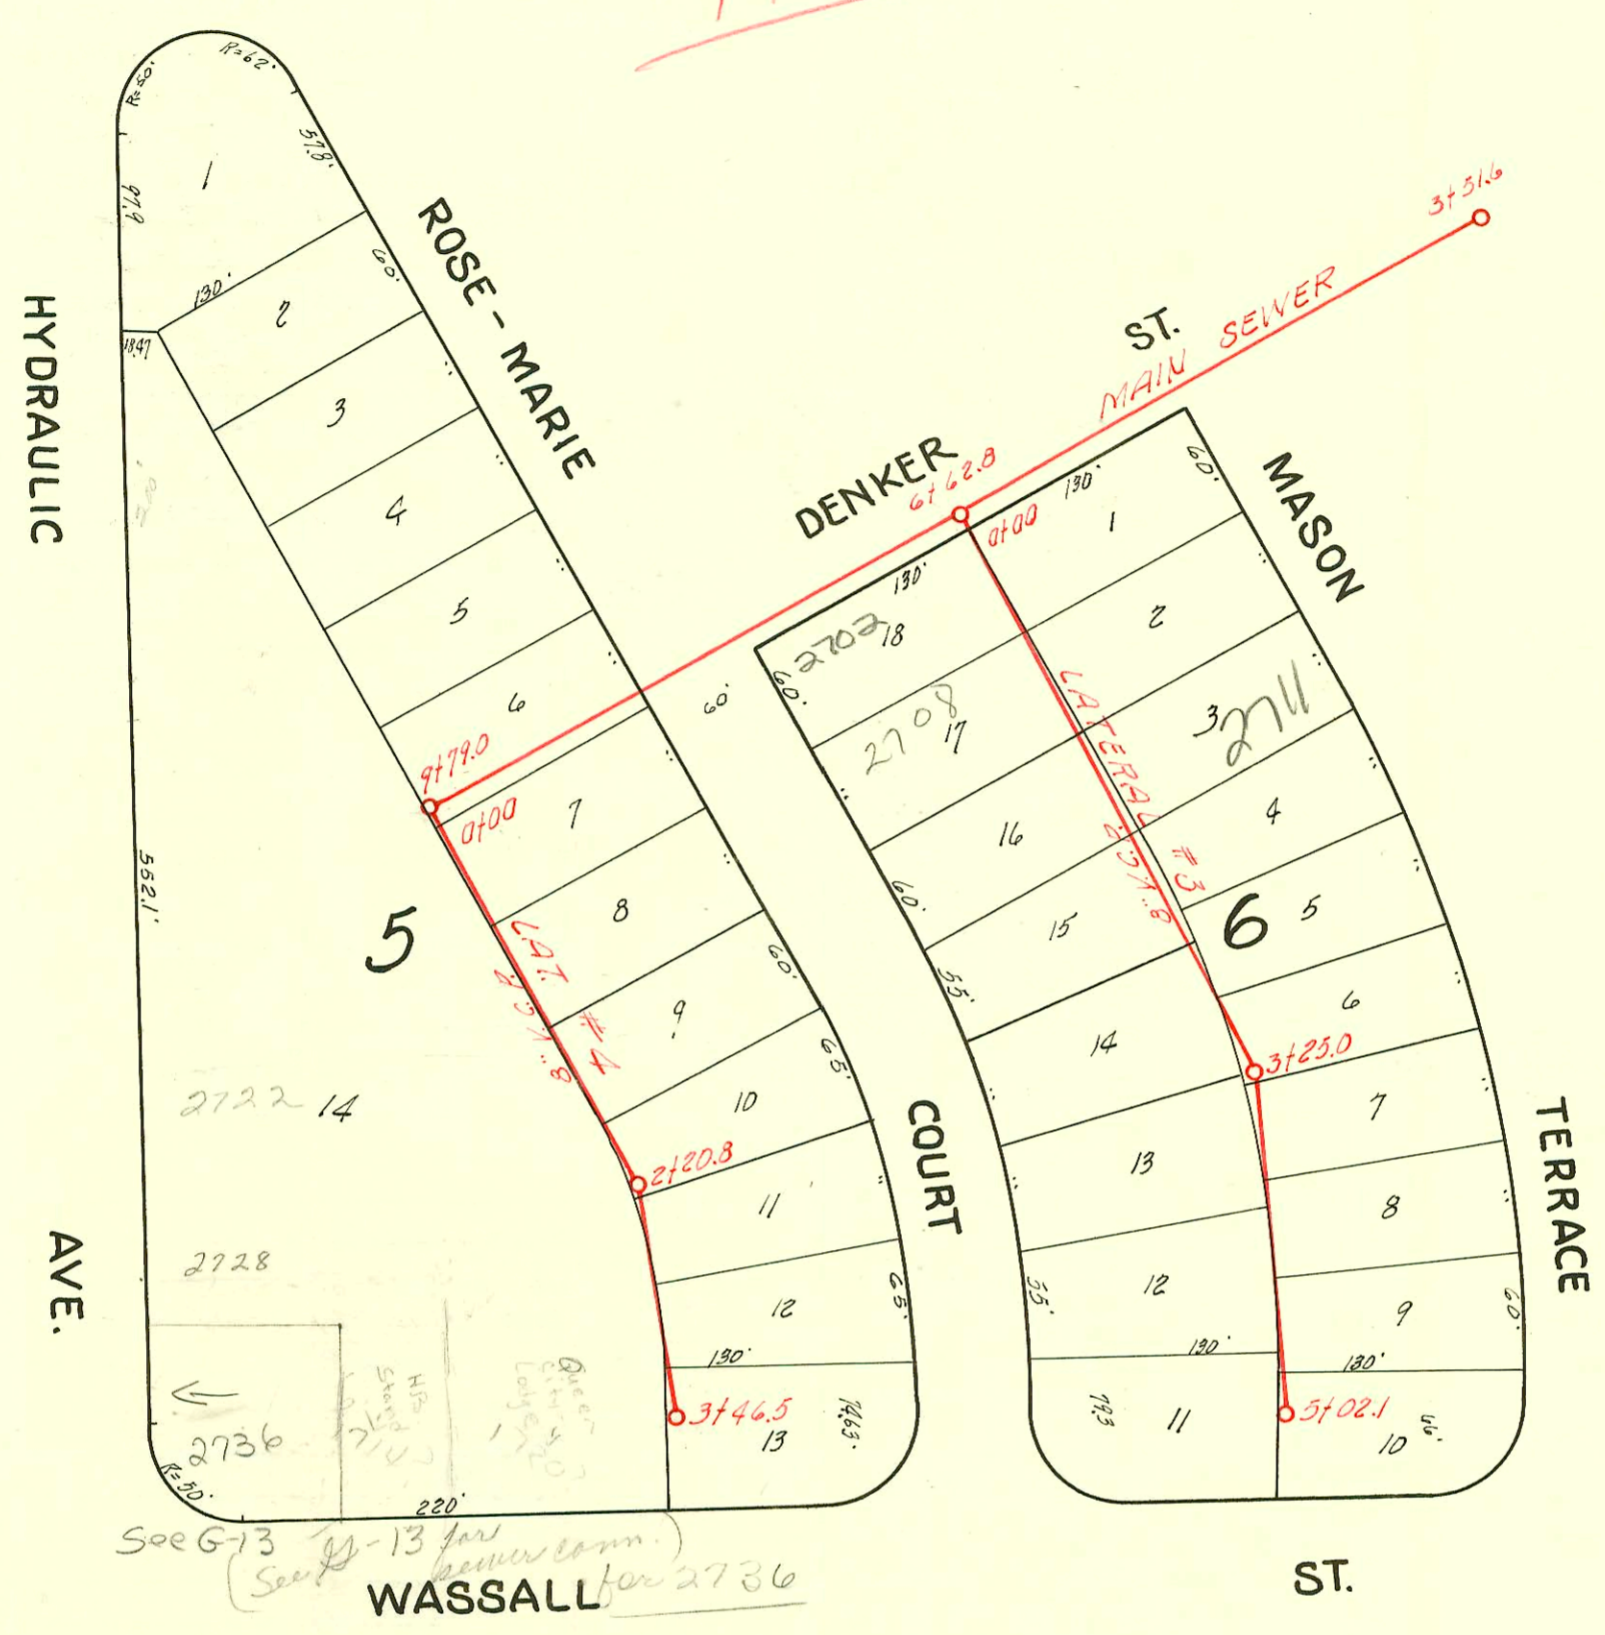

1" = 100'

Sewage disposal fee is collected with the rates and not to be paid in Finance Dept.

All service lines must be Trapped.
6" Traps.

CLASSEN PARKED SEWER

- #35 - Tap - 2708 S. Hydraulic - 3-4-50 Frederick H. Co.
- #348 - Tap - 2720 S. Hydraulic - 5-3-50 - E.B. Brannon.
- #B3221 - Seal off - 2712 S. Hydraulic (Classen Parked School) 4-16-65 Lippold P. Co. (2734) (277.5)

CONSTRUCTION RECORD						SERVICE RECORD						
STATION	ELEVATION		Depth	MANHOLE	4-INCH "Y" BRANCHES		No. of Permit		House Number		DATE OF PERMITS	
	Ground	Grade			North West	South East	North West	South East	North West	South East	North West	South East
Main Sewer Cont.												
5+00			9.21			5+96.9						
6+00			8.86			6+51.2						
				6+62.8								
7+00			7.82			6+91.7						
8+00			7.18			7+40.6						
9+00			6.54									
			6.68	9+79.0								
Lat. #3												
0+00			6.26	0+00	4+40-twin	0+29.4	0+26.4	#1320	#2085013	2732 R		1-5-04
						0+86.4	0+83.4	#1321	#1547	Rose Marie Mason T.		3-28-42
1+00			6.35		4" SCH 40 CO	1+44.9	1+41.9	#1322	#1548	Rose Marie Mason T.		3-28-42
2+00			5.86			2+04.6	2+01.6	#1323	#1549	Rose Marie Mason T.		3-28-42
						2+73.4		#1324	#1551	Rose Marie Mason T.		3-28-42
						2+94.0	2+94.0					4-18-42
3+00			5.23	3+25.0								
						3+67.7	3+38.2	#1552		2727 Mason T.		4-18-42
						3+94.0	3+94.0	#1554		2732 Rose Marie Mason T.		4-18-42
4+00			5.23			4+24.2	4+19.8	#1478		2743 Mason T.		4-15-42
						4+49.8	4+49.8	#1479		2749 Rose Marie Mason T.		4-15-42
						4+78.8	4+95.0	#1473		2744 Rose Marie Mason T.		4-15-42
5+00			5.76	5+02.1				#1553		2753 Rose Marie Mason T.		4-18-42
Lat. #4												
0+00			6.48	0+00			0+25.4	#1314		2753 Rose Marie Mason T.		3-28-42
							0+85.6	#1315		2749 Rose Marie Mason T.		3-28-42
1+00			6.09		1+22.8	1+41.4	1+41.4	#1316	036279	2725 S. Hydraulic Mason T.		12-7-72
						1+99.1	1+99.1	#1317		2721 Rose Marie Mason T.		3-28-42
2+00			5.74	2+20.8	2+32.2	2+50.5	2+50.5	#1318	031197	2728 S. Hydraulic Mason T.		3-24-72
						2+89.7	2+89.7	#1319		2725 Rose Marie Mason T.		3-28-42
3+00			5.54		3+17.0	3+32.2	3+32.2	#1325	071087	1714 Wansall Mason T.		4-1-80
			5.19	3+46.5	3+69.9			059315		1720 Wansall Mason T.		12-29-76

Tap #1550 - 2725 Mason Terrace, 4-18-42 - Wichita P/bq. Co.
 Tap #1546 - 2703 Mason Terrace - 4-18-42 - Wichita P/bq. Co.
 Tap #2674 - 2643 Rose Marie 9-16-42 Wichita P/bq. Co. (#25⁰⁰ Special fee paid 9-16-42)
 Tap #2337 - Classen Parked School 10-16-45; Moore - Robertson P/bq. Co. (2+77.5)
 Tap #3462 - 2712 S. Hydraulic - Frederick P/bq. Co. 2-27-50