


Line Shattered by Hillside paving project in 2003



1" = 100'
Dashed line for 2727 Maplewood
Dashed line for 3109
Dashed line for 3103
Dashed line for 3104
Dashed line for 3109
Dashed line for 3103

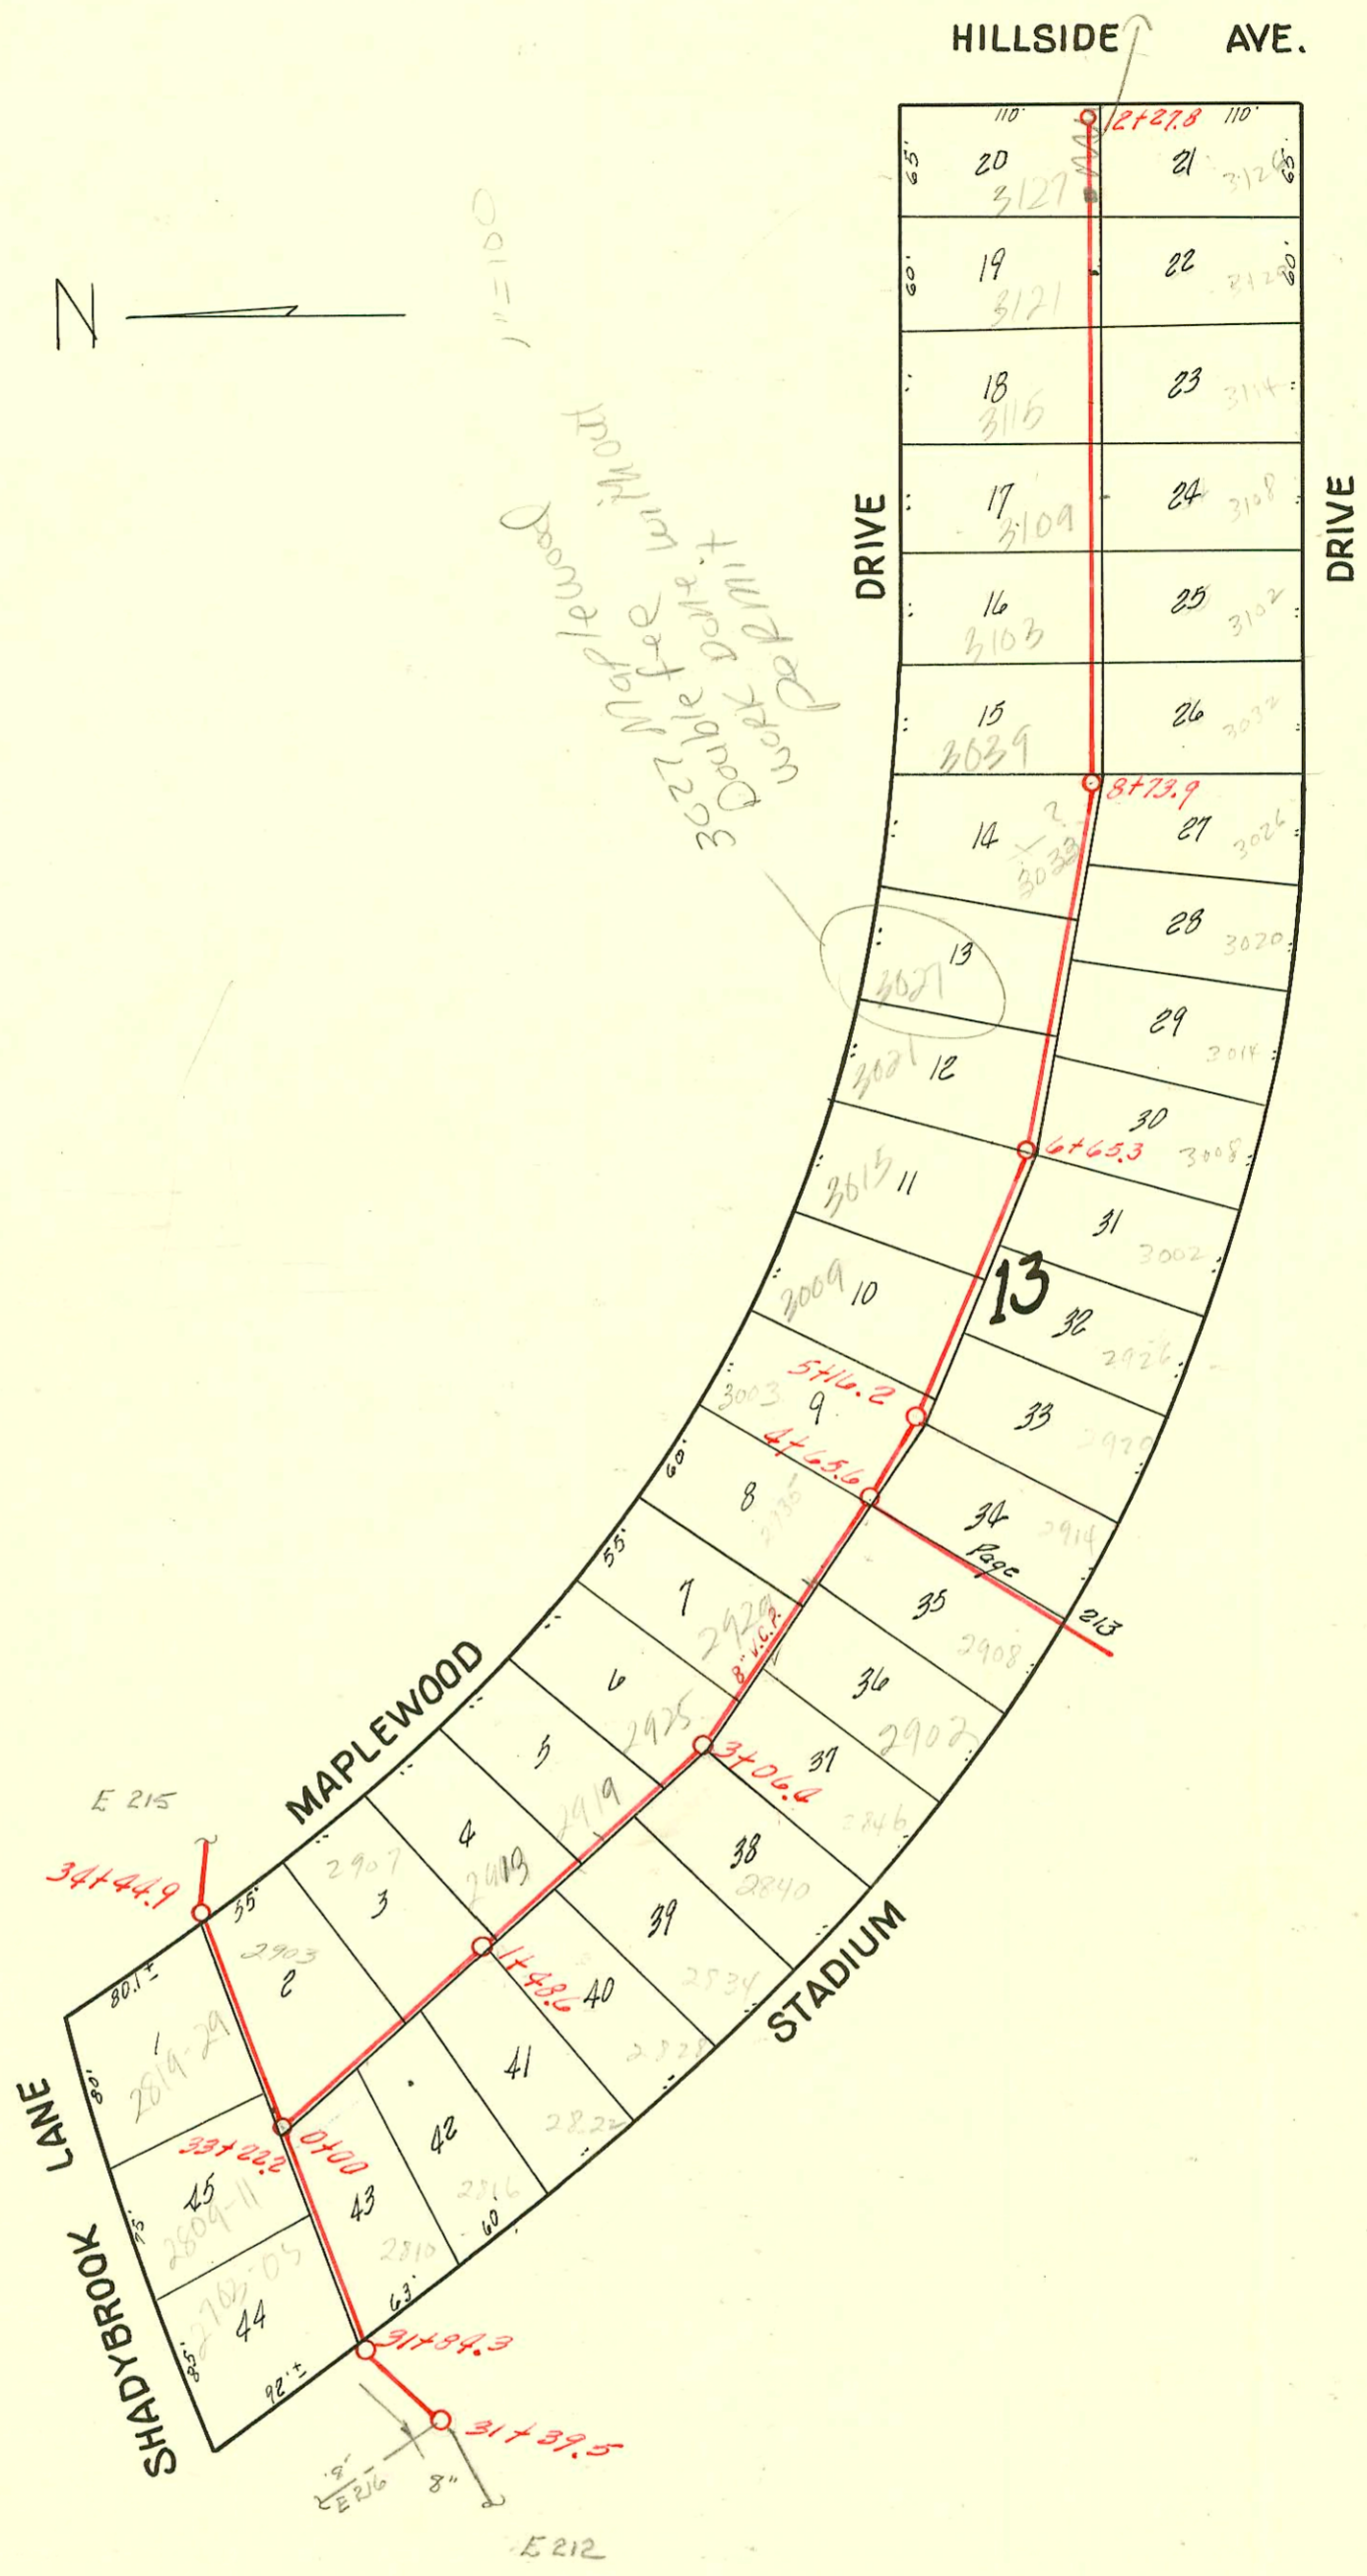

2001-20962-4/20/01-3108 Stadium Dr - Padgett ex - 4" SCH40 - CITY WYE REPAIR - 4" Predco 149' E of MH 8+73.9 (10+22.9)
 1 TWIN CO, 2V22

990128890701-7/5/99-3039 E Maplewood - McClung's - 4" SCH40 Predco 29.4' E of MH 8+73.9 (9+03.3)
 2-lane clearcuts 2V22

2003-01139-429103-2914 E Stadium - city wye repair 4" Predco 25' W of MH 5+16.2 (4+91.2) 4" 40PK 1V45,
 1V45, 1 TWIN CO, Shallow Kickout, Ifernco @ house

LAT. L, DIST. E, S. S. # 12
 W. B. CARTER 1942

CONSTRUCTION RECORD

SERVICE RECORD

No risers on this line.

STATION	ELEVATION		Depth	MANHOLE	4-INCH "Y" BRANCHES		No. of Permit		House Number		DATE OF PERMITS		
	Ground	Grade			West	East	North West	South East	North West	South East	North West	South East	
31+0	144.80	136.33 136.47 137.49	8.47	31+39.5 31+84.3									
32+0	146.20	137.53	8.67		31+92.8 32+66.2 32+80.5		#321		2331 R Shadybrook	4-19-79		3-18-43	
33+0	148.50	137.73 137.75 139.00	10.77				#322		2307 Shadybrook			3-18-43	
34+0	150.20	139.17	11.03	33+22.2	33+58.7 34+19.2		#323		2319 Shadybrook			3-18-43	
				34+44.9									
0+0	148.50	138.00	10.50	0+0	0+14.5 0+42.7 4" PVC 4" 0+140 0+55.6	0+11.5	#320	#320	2910 R Stadium	2703 Maplewood	9-24-98	3-18-43	3-18-43
							95-156-7 #319		2816 R Stadium		1-5-95	3-13-43	
						0+78.6 0+95.2		034056 #325	2922 Stadium	2907, 56 Maplewood		8-3-72	3-18-43
1+00	150.80	138.65	12.15		1+12.5 1+40.5 1+48.6	1+5.9 1+34.8	#318	4617	2922 Stadium	2907 Maplewood	3-18-43	11-5-81	
						1+74.3	#326		2915 R Maplewood			3-18-43	
					1+78.2 1+91.8		#317		2923 Stadium		1-27-71	3-18-43	
2+0	153.20	140.34	12.86		2+14.1 2+19.9 2+35.3 2+50.0 2+62.8	2+19.9 2+35.3	#316		2923 R Stadium	2834	3-31-93	3-18-43	
						2+83.0	#327		2919 Maplewood			3-18-43	
					2+89.0		#315		2840 Stadium	2925 Maplewood		3-18-43	
3+0	154.90	140.99 141.03 142.20	13.91	3+06.4	Risers Wyes N. 3+23.5 3+46.0 3+51.8 3+80.2	Risers Wyes S. 3+26.5 3+46.0	#250		2929 R Maplewood	2925 Stadium	9-16-42	2-23-43	
						4+00.2	#249		2929 R Maplewood			2-23-43	
4+0	156.10	142.61	13.49		Riser 55.6' w of MH 4+13.4 4+43.1 4+53.7	4+00.2 30.6 4+24.6 4+53.7	#248		2935 B Maplewood	2928 Stadium	10-13-89	3-16-42	2-23-43
		143.03 145.53	16' Flood out P&K Drainage Layer		4+82.2 4+97.3 4+94.3		#247		3003 Maplewood	2914 R Stadium	3-24-42	4-29-03	2-23-43
5+0	157.00	143.26 143.35 146.35	13.74	5+16.2	5+07.0 5+28.3 5+45.0 5+55.9 5+86.4 5+71.3	5+28.3 5+55.9	#246		2920 Stadium			2-23-43	
						5+71.3	#245		3009 R Maplewood	2926 Stadium	3-16-42	2-23-43	
6+0	159.20	146.90 147.31 150.00	12.30	6+65.3	6+25.5 6+28.5 6+43.3 6+58.4 6+97.4 6+87.8	6+28.5 6+58.4	#244		3015 Maplewood	3002 R Stadium	3-24-42	9-29-03	2-23-43
						6+87.8	#243		3015 R Maplewood	3008 Stadium	3-16-42	1-25-72	2-23-43
7+0	160.50	150.24	10.26		7+18.7 7+48.5 7+70.1 8+00.1	7+11.8 7+36.7 7+85.0	#242		3014 Stadium			2-23-43	
						8+23.1	#241		3027 Maplewood	3020 Stadium	3-24-42	8-19-43	
8+0	163.90	150.89	13.01		8+18.7 8+37.2 8+40.2	8+18.7 8+40.2	#240		3033 R Maplewood	3026 R Stadium	12-10-72	9-21-49	12-19-72
		151.35 155.00		8+73.9	8+54.3 8+66.6	8+66.6	#239		3033 R Maplewood	3026 R Stadium	3-16-42	2-19-43	
9+0	168.10	155.58	12.52		9+03.3 9+16.4 9+37.5 9+67.9	8+92.8 8+92.8 9+19.4 9+42.5	#238		3037 R Maplewood	3032 R Stadium	7-5-99	5-30-90	3-16-42
						9+64.9	#237		3102 Maplewood	3102 Stadium	3-16-02	3-16-42	
10+0	171.70	157.58	14.12		10+04.2 10+26.1 10+44.7 10+78.4	10+07.2 10+23.1 10+47.7 10+78.4	#236		3009 R Maplewood	3108 R Stadium	see next pg	4-20-01	3-30-42
						10+78.4	#235		3108 R Maplewood		3-16-42	3-30-42	
						10+47.7	#234		3105 R Maplewood	3112 R Stadium	3-16-42	4-14-92	3-30-42
11+0	174.60	159.58	15.02		11+01.0 11+23.3 11+45.0 11+80.3	11+04.0 11+26.3 11+42.0 11+83.3	#233		3121 Maplewood	3120 Stadium	3-16-42	3-30-40	3-30-42
						11+83.3	#232		3121 Maplewood		3-16-42	3-30-42	
12+0	176.60	161.58	15.02		12+27.8 12+42.4	12+15.4	#231		3121 Maplewood	3120 Stadium	5-2-03	3-2-50	5-2-03

#14784 Riser 3033 Maplewood 10-6-01
 #16852 Jap 2902 Stadium 3-26-63 (3+84.4) - Riser 214.3
 #92-5187-7 tap 3114 E. Stadium 4-10-92 (10+76.8 tap 4" PVC 90)