


TOWNE WEST SQUARE SAN SEWER
 BUILT BY: W.B. CARTER CONST. CO.
 PROJ. NO 468-76-245-80612-000-000-008
 BOOKED 4-30 -80 FROM W.S.J 06

on map



2002-02450 9/5/02 4600 W Kellogg (serv Merchandise) Boardman - 4" cast iron line slo at cleansat at west side of bldg - 30' from main + 15' N of sw corner of bldg.

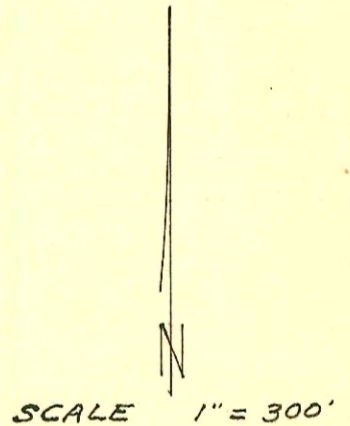