


TOWNE WEST SQUARE SAN SEWER
 BUILT BY: W.B. CARTER CONST. CO.
 PROJ. NO 468-76-245-80612-000-000-008
 BOOKED 4-30 -80 FROM W.S.J 06

on map

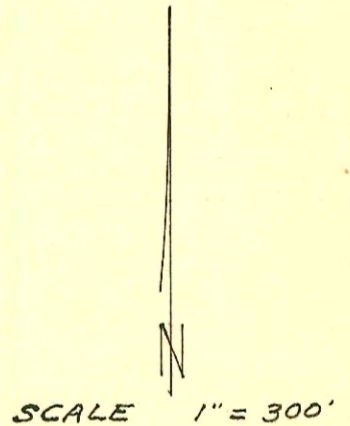

2002-02450 9/5/02 4600 W Kellogg (serv Merchandise) Boardman - 4" cast iron line slo at cleansat at west side of bldg - 30' from main + 15' N of SW corner of bldg.

CONSTRUCTION RECORD

SERVICE RECORD

STATION	ELEVATION		Depth	MANHOLE	4-INCH "Y" BRANCHES		No. of Permit		House Number		DATE OF PERMITS	
	Ground	Grade			North West	South East	North West	South East	North West	South East	North West	South East
TOWN WEST SQUARE SAN SEWER (CONT'D)												
LINE A CONT'D	16+00	110.21				16+37.1 ^{to}		C71142		4600 w Kellogg		4-9-79
	17+00	110.52								4600 w Kellogg		4-9-79
	17+00	116.1	5.4	17+47.1	6" stub NE	6" stub E		C71141		4600 w Kellogg		4-9-79
	18+00	110.82										
	19+00	111.12				seal off 19+27.2		2001-0497 576		seal off 4600 w Kellogg	10A Latic	6-13-80
	20+00	111.41				seal off 6" stub E ^{ok}		2001-0493 C71153		4600 w Kellogg	S10 Lot 5	6-15-01 4-9-79
LINE B	0+00	105.56 out 105.64 in 105.84	8.8 8.6	0+00 = EXISTING 0+19.0								
	1+00	106.16										
	2+00	106.56										
	3+00	106.95										
	3+00	117.1	10.0	3+37.8	6" stub W ^{ok}	6" stub S ^{ok}	C71150	C71151	4600 w Kellogg	4600 w Kellogg	4-9-79	4-9-79
LINE C	0+00	114.4	8.4	0+00 = 0+19 LINE B	6" stub W	6" stub S						
	1+00	106.23										
	2+00	106.46 106.49 106.59	9.0 8.9	2+13.5		6" stub S ^{ok}		C71132		4600 w Kellogg		4-9-82
	3+00	106.89				3+14.4 ^{to}		C71131		4600 w Kellogg		4-9-82
	4+00	107.24										
	4+00	115.3	7.7	4+98.4		4+81.4 ^{to}		C71130		4600 w Kellogg		4-9-82
	5+00	108.30				5+77.0 ^{to}		C71129		4600 w Kellogg		4-9-82
	6+00	107.95				6+92.0 ^{to}		C71128		4600 w Kellogg		4-9-82
	7+00	108.30										
	7+00	115.6	7.0	7+82.0		6" stub S ^{ok}		C71127		4600 w Kellogg		4-9-79
LINE D	0+00	115.5	8.9	0+00 = 2+18.5 LINE C								
	1+00	107.59				0+18.0 ^{to}		C71133		4600 w Kellogg		4-9-82
	1+00	116.1	8.3	1+22.3		6" stub SW ^{ok}		C71134		4600 w Kellogg		4-9-82
LINE E	0+00	105.9		0+00 EXISTING								
	1+00	106.29 out 106.44 in 106.54	9.7 9.6	1+37.2								
	2+00	106.71										
	3+00	106.98										
	3+00	115.0	7.8	3+64.1								
	4+00	107.27										
	5+00	107.59										
	6+00	107.91										
	6+00	115.7	7.7	6+20.5								
	7+00	108.23										
						7+74.0 ^{to}		C71135		4600 w Kellogg		4-9-79

