



SCALE 1" = 300'

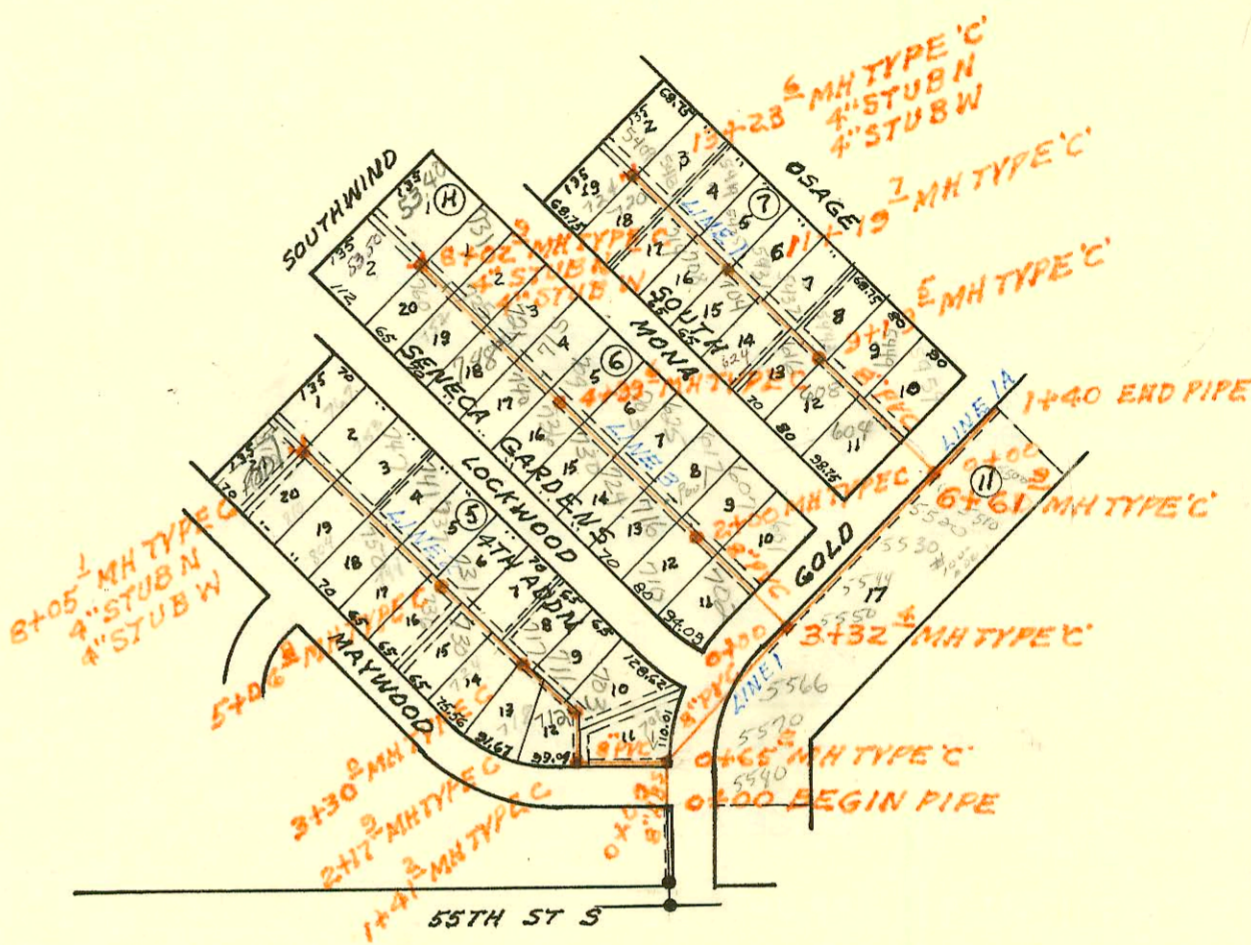

LATERAL 141 SOUTHWEST INTERCEPTOR
 BUILT BY: MID STATES CONST. CO.
 PROJ. NO 468-76-245-80748-000-001
 BOOKED 5-8-80 FROM AG 10

on map

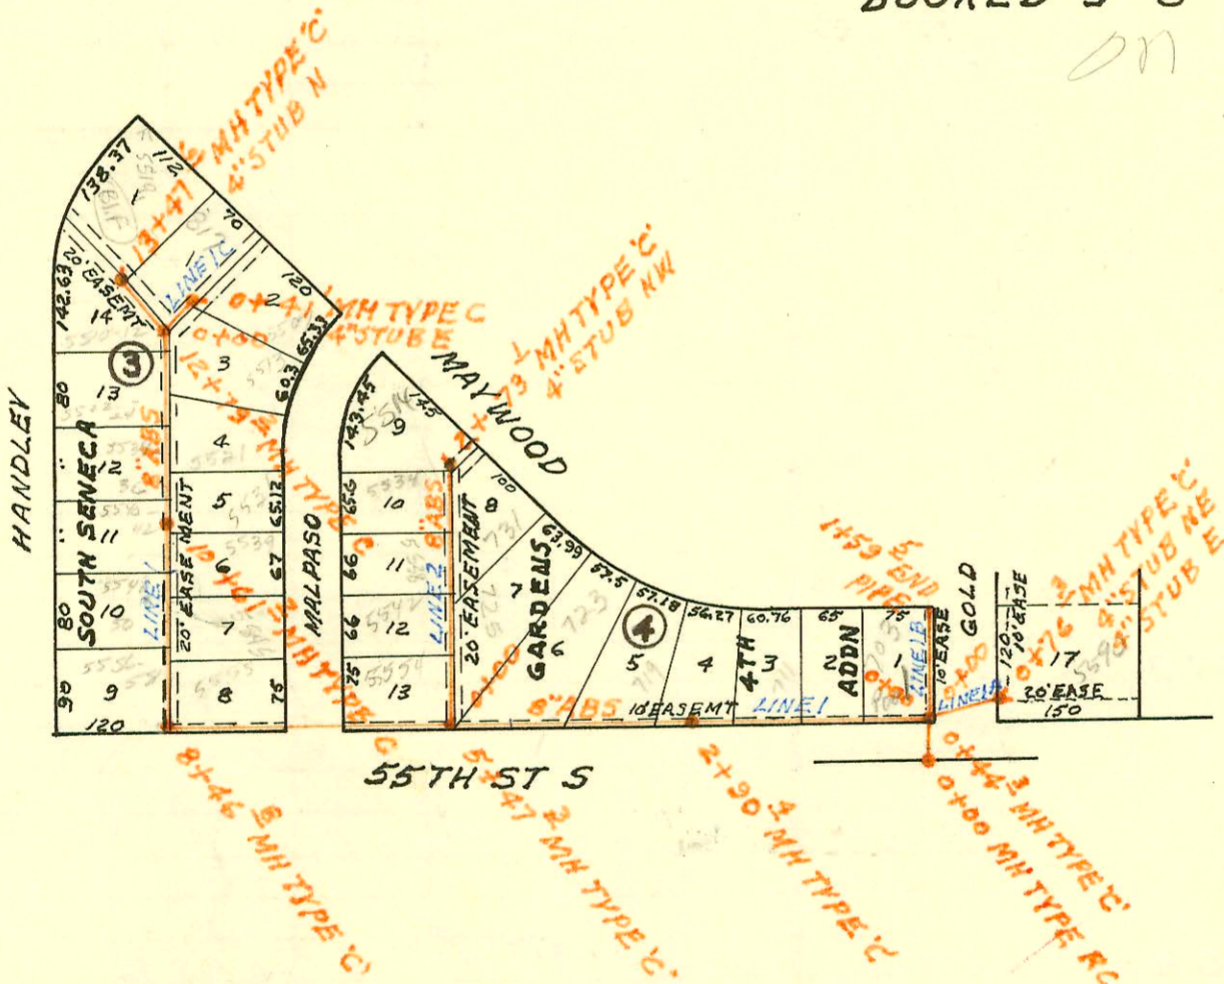

SCALE 1" = 200'

LATERAL 143 SOUTHWEST INTERCEPTOR
 BUILT BY: COLEMAN CONST. CO.
 PROJ. NO 468-76-245-80820-000-001
 BOOKED 5-10-80 FROM DCD 171
 CSEE PAGE E258

on map

06-8

CONSTRUCTION RECORD

SERVICE RECORD

STATION	ELEVATION		Depth	MANHOLE	4-INCH "Y" BRANCHES		No. of Permit		House Number		DATE OF PERMITS	
	Ground	Grade			North West	South East	North West	South East	North West	South East	North West	South East
LAT 8 MAIN 14 55 N^o22 (CONT'D)												
LINE 3 CONT'D 7+00		103.59										
8+00		103.99										
9+00	109.6	104.19	5.4	8+50.7								
	110.2	104.39		9+40.8			95-180127		1835 S. Florence		10-27-95	
		104.68	5.5	9+72.0	6" STUB NW		2872		1835 S. Florence		3-18-81	
							#0912		1835 S. Florence		11-18-80	
LINE 4												
0+00	109.6	104.40	5.2	0+00 = 8+50.7 LINE 3								
1+00		104.80			1+15.5			1888	1834 S. Florence		11-13-80	
2+00		105.20										
	110.4	105.32	5.1	2+29.5	6" STUB NE			7234	1834 S. Florence		12-21-82	
LINE 3A												
0+00	110.4	103.08	7.3	0+00 = 5+46.1 LINE 3								
	110.4	103.22	7.2	0+35.0	6" STUB SW			2002-03083	4330 W Addition to North end of bldg		11-13-02	
								19825	4330 W. May		12/04/87	
LATERAL 141 SOUTHWEST INTERCEPTOR												
LINE 1 0+00	80.9	71.32	9.6									
	81.5	71.45	10.1	0+65.0								
		71.55	10.0									
1+00	80.5	71.62	8.9									
2+00	80.3	71.82	8.5									
										5570		7-25-81
3+00	80.5	72.02	8.5									
	82.0	72.08	9.9	3+32.4								
		72.18	9.8							5566		7-25-81
4+00	80.5	72.32	8.2									
										5550		7-25-84
5+00	80.7	72.52	8.2									
										5544		7-25-84
6+00	80.8	72.72	8.1									
	82.1	72.84	9.3	6+61.9								
		72.94	9.2							5530		3-30-84
7+00	81.0	73.05	8.0									
										5520		9-7-84
8+00	81.2	73.35	7.9									
9+00	81.0	73.65	7.4									
	81.0	73.71	7.3	9+19.5								
10+00	80.9	73.95	7.0									
11+00	81.3	74.24	7.1									
	81.4	74.30	7.1	11+19.7								
12+00	81.3	74.54	6.8									
13+00	81.2	74.84	6.4									
	81.6	74.91	6.7	13+23.6								
LINE 1A												
0+00	82.1	72.94	9.2	0+00 = 6+61.9 LINE 1								
1+40	80.8	73.22	7.6									
LINE 2												
0+00	81.5	71.55	10.0	0+00 = 0+65 LINE 1								
1+00	80.4	71.85	8.4									
	81.9	71.98	9.9	1+41.2								
		72.08	9.8									
2+00	80.5	72.25	8.3									
	80.5	72.30	8.2	2+17.9								
		72.40	8.1									
3+00	80.6	72.65	8.0									

CONT'D NEXT PAGE

95-18012-7 10-27-95- 1835 S. Florence - Bldg Add. - Ran 160' of 4" sch 40 pipe & tied into EXIST Bldg LIne.