
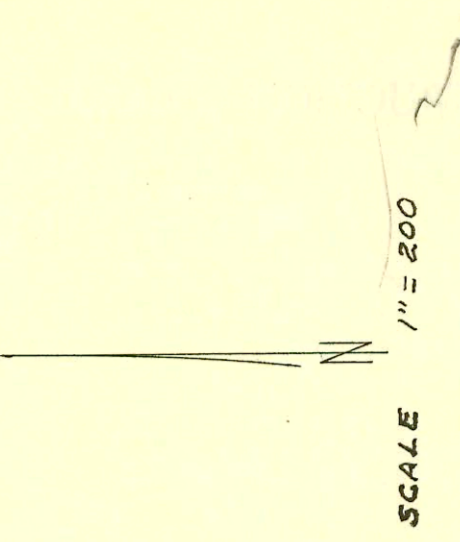


ALL LOTS & BLOCKS IN WESTLINE VILLAGE 18TH ADMN ARE BENEFIT DISTRICT

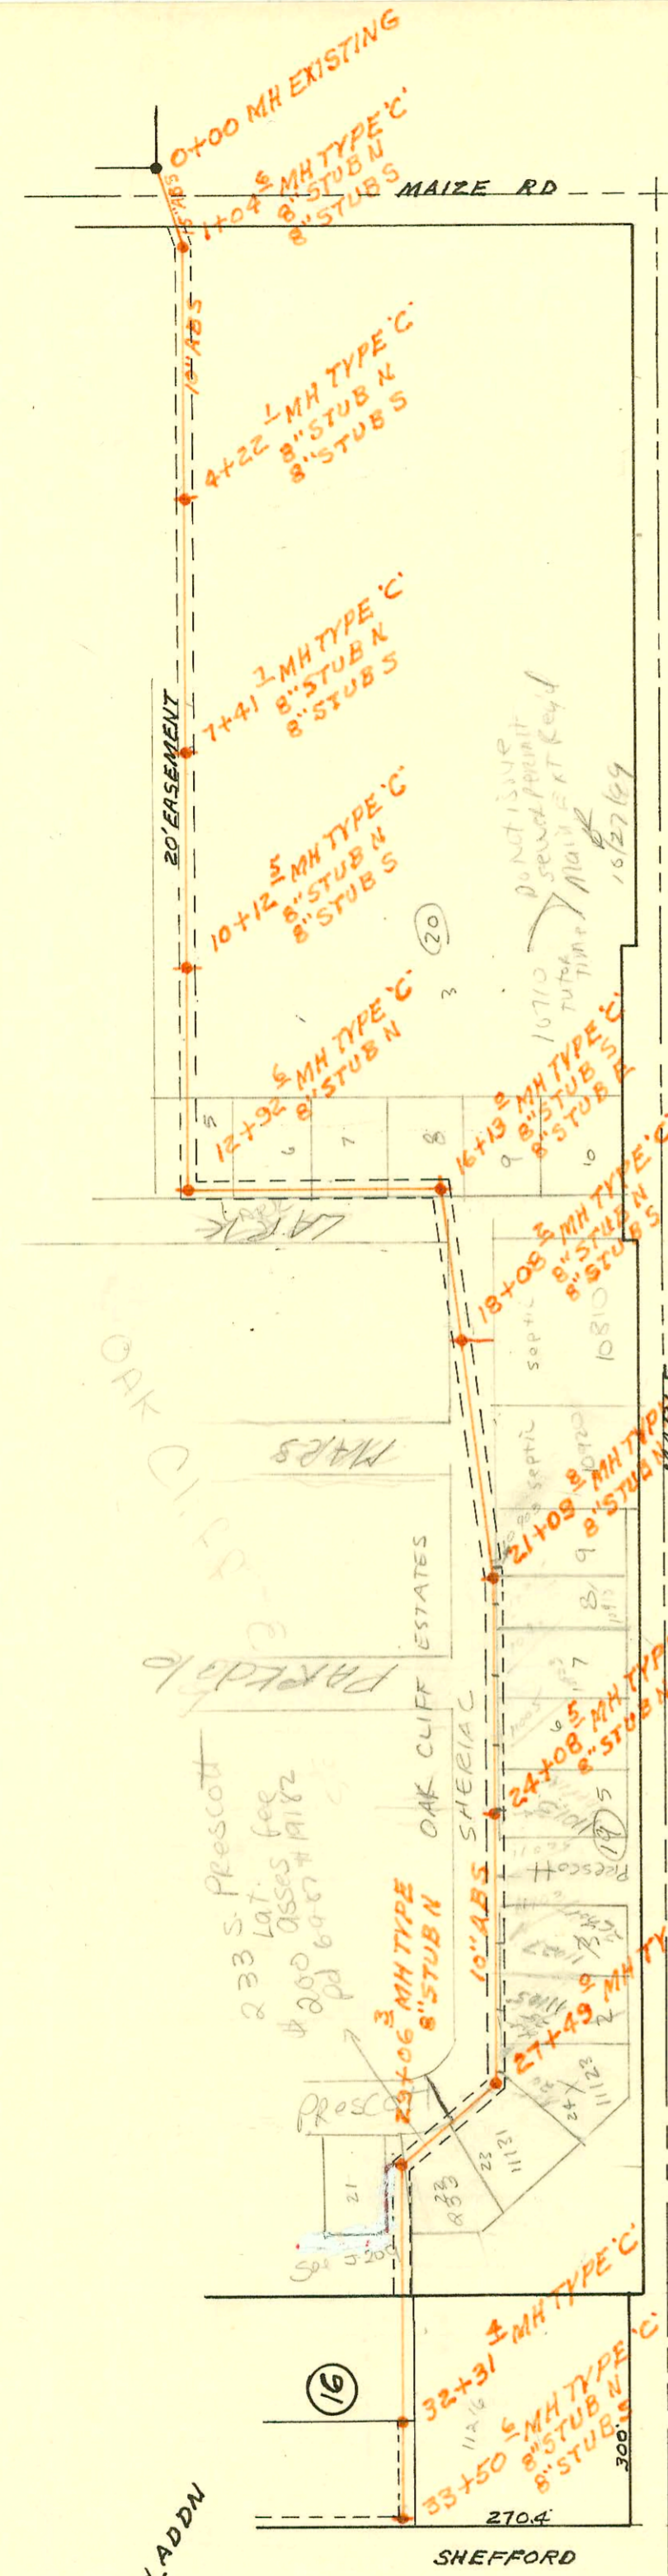

NOTE
 Riser are approx. 12ft S of S ab and B. depth they are flagged. Require inspector to take field meas. all connections.

MAIN 9 SOUTHWEST INTERCEPTOR
 BUILT BY: UTILITY CONTR. INC.
 PROJ. NO 468-76-245-80703-000-000-001
 BOOKED 5-24-80 FROM SRL 5

Requires 200 gpd. permit in lieu of sewer assessor

Check with Permit Dept. before making connections. 8' stops for lateral ass. Not done

M.M.

CONSTRUCTION RECORD

SERVICE RECORD

STATION	ELEVATION		Depth	MANHOLE	4-INCH "Y" BRANCHES		No. of Permit		House Number		DATE OF PERMITS	
	Ground	Grade			North West	South East	North West	South East	North West	South East	North West	South East
LAT 18 MAIN / WESTLINK (CONT'D)												
LINE 6 0+00	151.0	139.50	11.5	EXISTING	0+40.2		18208		8015 W 2nd		9-3-87	
1+00		139.80			1+36.4 TAP		4745		8009 W 2nd		11-19-81	
2+00		140.10										
2+24		140.17	10.8	2+24								
MAIN 9 SOUTHWEST INTERCEPTOR												
0+00	131.7	116.96	14.7	EXISTING								
1+00	134.8	117.21	17.6		1+04.6	8" STUB N 8" STUB S						
	134.9	120.05	14.9									
2+00	136.5	120.33	16.2									
3+00	137.6	120.63	17.0									
4+00	138.1	120.93	17.2		4+22.1	8" STUB N 8" STUB S						
	138.6	121.00	17.6									
5+00	138.6	121.23	17.4									
6+00	139.4	121.53	17.9									
7+00	140.0	121.83	18.2		7+41.7	8" STUB N 8" STUB S						
	140.0	121.96	18.0									
8+00	140.2	122.13	18.1									
9+00	140.8	122.43	18.4									
10+00	141.1	122.73	18.4		10+12.5	8" STUB N 8" STUB S						
	141.2	122.77	18.4									
11+00	141.6	123.03	18.6									
12+00	142.0	123.33	18.7		12+92.6	8" STUB N						
	141.9	123.61	18.3									
		123.71	18.2									
13+00	141.9	123.73	18.2				3867		204-6 S. Park		8-11-81	
14+00	141.4	124.03	17.4				3866		202-14 S. Park		8-11-81	
15+00	140.9	124.33	16.6				3865		222-4 S. Park		8-11-81	
16+00	140.4	124.63	15.8		16+13.0	8" STUB E 8" STUB S						
	140.4	124.68	15.7									
		124.78	15.6									
17+00	141.3	125.03	16.3									
18+00	141.9	125.33	16.6		18+08.2	8" STUB N 8" STUB S 40'						
	141.9	125.36	16.5									
19+00												
19+00	142.3	125.63	16.7									
20+00	142.8	125.93	16.9									
21+00	143.4	126.23	17.2		21+09.8	8" STUB N 21+37.3	6323		10903 Change		8-10-82	
	143.5	126.27	17.2									
		126.37	17.1				5350		10915 Change		3-15-82	
22+00	145.0	126.63	18.4									
22+00	145.0	126.63	18.4				5393		10923 Change		4-12-82	
23+00	146.2	126.93	19.3									
23+00	146.2	126.93	19.3				5390		10905 Change		4-12-82	
24+00	147.4	127.23	20.2		24+08.5	8" STUB N						
	147.5	127.26	20.2									
							10430		11013 Change		3-8-81	
25+00	147.9	127.53	20.4									
							13470		11027 Change		4-15-85	

CONT'D NEXT PAGE

21+09.8
20+30.0
20+19.8

100 3-15-82
Paul Thompson

CONSTRUCTION RECORD

SERVICE RECORD

STATION	ELEVATION		Depth	MANHOLE	4-INCH "Y" BRANCHES		No. of Permit		House Number		DATE OF PERMITS	
	Ground	Grade			North West	South East	North West	South East	North West	South East	North West	South East
MAIN 9 SWI (CONT'D)												
26+00	148.3	127.83	20.5									
27+00	147.8	128.13	19.7					13469	1105 W. Sherman			4-15-85
	147.3	128.28	19.0	27+49.0	4" RISER 8' DEEP			15478	1133 Sherman			1-20-86
		128.38	18.9		4" RISER 8' DEEP							
28+00	144.9	128.53	16.4		27+64.0 TAP			15477	1131 Sherman			1-20-86
								18229	223 S. Prescott			5-14-87
29+00	143.4	128.83	14.6		28+43.3 TAP							
	143.4	128.85	14.6	29+06.3								
		128.95	14.5									
30+00	142.3	129.23	13.1									
31+00	141.8	129.53	12.3									
32+00	142.4	129.83	12.6									
	142.6	129.93	12.7	32+31.4	4" STUB S			01393	1126 W. Maple			9-30-80
33+00	143.0	130.13	12.9									
	143.9	130.29	13.6	33+50.6								
MAIN 10 SOUTHWEST INTERCEPTOR												
LINE 1 0+00	135.06	121.00	14.1	EXISTING								
1+00	134.4	121.40	13.0									
	135.0	121.45	13.6	1+11.5								
		122.05	13.0									
2+00	134.7	122.26	12.4									
3+00	137.0	122.51	14.5									
	137.5	122.58	14.9	3+28.5								
4+00	139.0	122.76	16.2									
5+00	141.0	123.00	18.0					97150907	557 K			8-27-97
	142.1	123.09	19.0	5+37.4				13453				1-15-86
		123.19	18.9									
6+00	141.8	123.35	18.5		4" RISER W ✓			9251047	10508			4-13-72
					6+12.4 133.29				10512 CT			2-17-91
					4" RISER W 4" W/3			91391767	10512 CT			
					6+60.5 132.46							
7+00	140.4	123.60	16.8									
	139.8	123.74	16.1	7+55.8								
		123.88	15.9									
8+00	139.6	123.99	15.6									
					4" RISER 57+75.2			1737	10516			12-23-91
					8+53.8 133.05				Merbeary CT			
9+00	140.2	124.24	16.0									
	142.6	124.49	18.1	10+01.5								
		124.59	18.0									
	143.7	124.65	19.1	10+26.1								
11+00	142.3	124.84	17.5									
12+00	140.0	125.08	14.9									
	138.7	125.32	12.8	12+92.5	8" STUB W							
13+00	138.0	125.34	12.7					10223	314 W LARK			2-16-84
14+00	137.3	125.59	11.7									
15+00	135.7	125.84	9.9									
	135.8	125.86	9.9	15+08.8				18053	520 W LARK			4-2-87
		125.96	9.8									
16+00	135.7	126.20	9.5									
17+00	135.5	126.44	9.1									
	135.3	126.53	8.8	17+35.8	17+03.8 TAP			17687	330 W LARK			1-26-87
					8" STUB SW			16927	336 LARK			9-9-86
					17+94.8							
18+00	135.0	126.69	8.3									
19+00	134.5	126.94	7.6									
	134.1	127.15	7.0	19+85.3	19+09.2 TAP			18891	340 LARK			8-18-87
		127.25	6.9									
20+00	134.4	127.29	7.1					1921	346 N LARK			11-19-80

CONT'D NEXT PAGE