

NOTE:  
 BLOCK 5  
 LOTS 5-23  
 NO add'l lat. fee  
 req'd as these lots  
 paid extra in orig.  
 benefit dist to user  
 main.


BLOCK 3 - Lots 6-7  
 " 4 " 5-6  
 These covered in Benefit  
 Dist. For lateral 2  
 NO add'l fee req'd.

11-18-72  
 per. Virky Huang's office  
 City Eng's Office  
 (CH)

MAIN 10' SOUTHWEST INTERCEPTOR SEWER  
 BUILT BY: MID STATES CONST. CO.  
 PROJ. N# 468-76-245-80688-000-001  
 BOOKED 5-31-80 FROM LES 25

ON MAP

Clear except line 1A

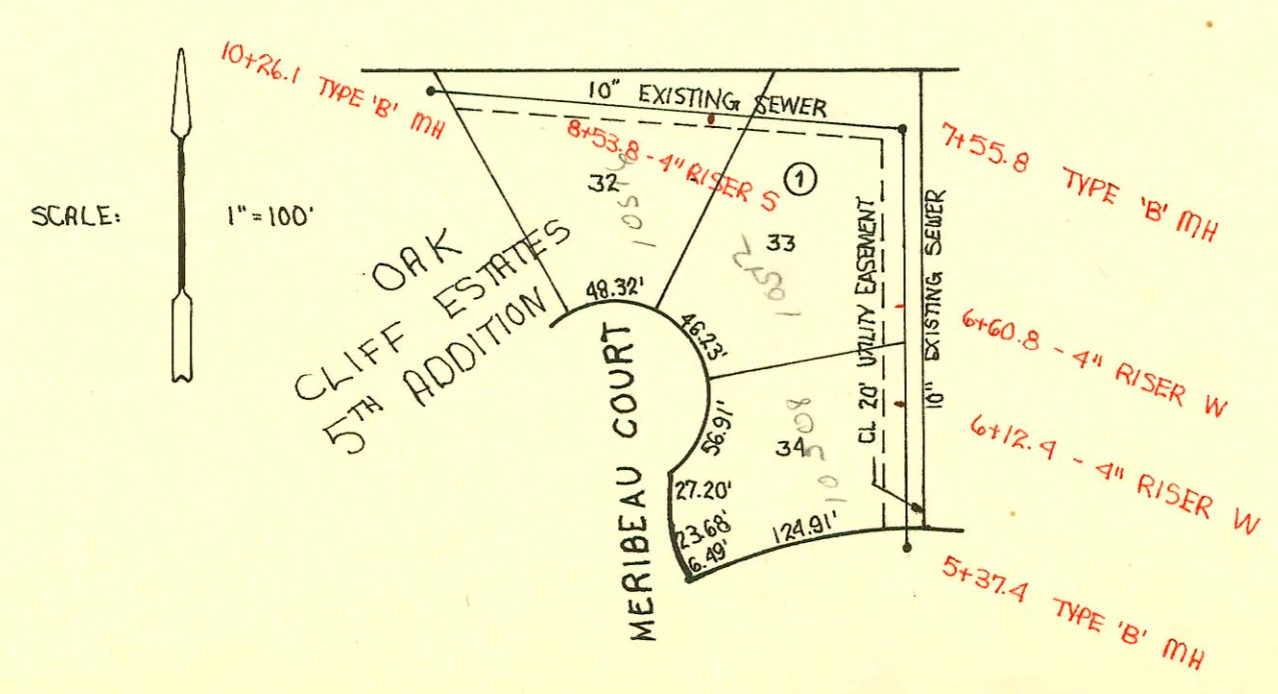

CONSTRUCTION RECORD

SERVICE RECORD

STATION	ELEVATION		Depth	MANHOLE	4-INCH "Y" BRANCHES		No. of Permit		House Number		DATE OF PERMITS	
	Ground	Grade			North West	South East	North West	South East	North West	South East	North West	South East
<b>MAIN 10 SWI (CONT'D)</b>												
LINE 1 CONT'D 21+00	134.5	127.54	7.0		4" SDR35 21+47.8 TAP		92-4268-7		350 LARK		11-18-72	
22+00	134.6	127.79	6.8		22+33.3 TAP		19915		360 LARK		12-20-77	
	134.6	127.83	6.8	22+15.3	22+96.4 TAP		8761		360 LARK		7-21-83	
23+00	134.6	128.04	6.6									
24+00	134.6	128.29	6.3		14" P 24 5" PL		15090		366 N LARK		11-20-85	
	135.0	128.40	6.6	24+45.8	25+10.8 TAP		13192		404 N LARK		3-12-85	
25+00	135.2	128.54	6.7		26+07.8 TAP		10330		410 N LARK		2-28-84	
26+00	135.2	128.79	6.4									
	135.1	128.98	6.1	26+77.3	27+50.7 TAP		10905		418 N LARK		5-14-84	
27+00	135.3	129.04	6.3									
28+00	135.6	129.29	6.3									
	136.0	129.36	6.6	28+29.3	28+72.3 TAP		19600		426 LARK		11-18-87	
		129.46	6.5									
29+00	138.5	129.64	8.9									
30+00	138.2	129.89	8.3		29+81.5 TAP		23150		432 LARK		5-12-89	
	136.0	130.05	6.0	30+65.5	8" STUB N							
		130.15	5.9									
31+00	143.6	130.24	13.4									
	144.6	130.40	14.2	31+65.5								
		130.50	14.1									
32+00	144.4	130.59	13.8		32+09.5 TAP		22659		504 Parkdale		2-22-89	
33+00	144.7	130.84	13.9									
	145.7	130.98	14.7	33+55.0								
34+00	145.4	131.09	14.3									
	144.5	131.23	13.3	34+55.9	8" STUB N							
		131.43	13.1									
35+00	143.5	131.56	11.9									
36+00	145.0	131.86	13.1									
37+00	143.1	132.16	10.9									
	143.4	132.31	11.1	37+49.4	8" STUB N							
38+00	145.0	132.46	12.5									
	144.7	132.53	12.2	38+17.7								
		132.62	12.1									
39+00	145.0	132.86	12.1									
40+00	147.5	133.16	14.3									
	149.5	133.29	16.2	40+43.2	8" STUB N							
<b>LINE 1A</b>												
0+00	135.1	129.18	5.9	0+00=26+77.3 LINE 1								
1+00	137.0	129.58	7.4									
1+76	139.8	129.88	9.9									
<b>LATERAL 2 MAIN 10 SOUTHWEST INTERCEPTOR</b>												
LINE 1	0+00	136.0	130.25	5.8	0+00 EXISTING		#2008		5107 PARKDALE		12-4-80	
	1+00	137.4	131.00	6.4		0+31.0 TAP	2009		516 N Parkdale		12-9-80	
		140.4	131.43	9.0	1+57.3	1+07.0 TAP						
2+00	141.0	131.75	9.3		4" SDR40 2+14.9		9543567		10909 W RONA		3-30-95	
3+00	141.7	132.50	9.2									
	141.8	132.69	9.1	3+25.5								

CONT'D NEXT PAGE