


LATERAL 27 DIST B SAN SEWER N^o 20
BUILT BY: W.B. CARTER CONST. CO.
PROJ. N^o 468-76-245-80169-000-000-001
BOOKED 6-24-80 FROM 9F

on map
9-68


SCALE 1" = 150'

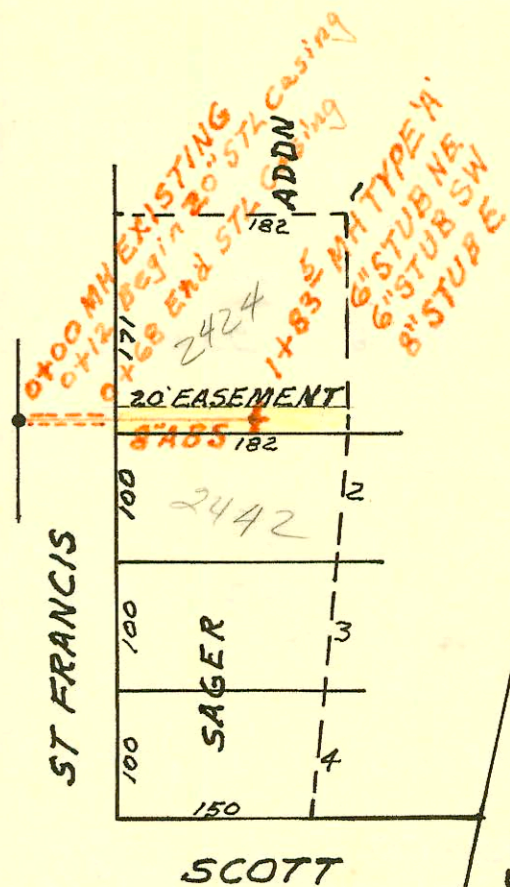

LATERAL 81 MAIN 4 SAN SEWER N^o 23
BUILT BY: ARKANSAS CONST. CO.
PROJ. N^o 468-76-245-80115-000-000-001
BOOKED 6-24-80 FROM 9F

on map
7-80

SCALE 1" = 150'

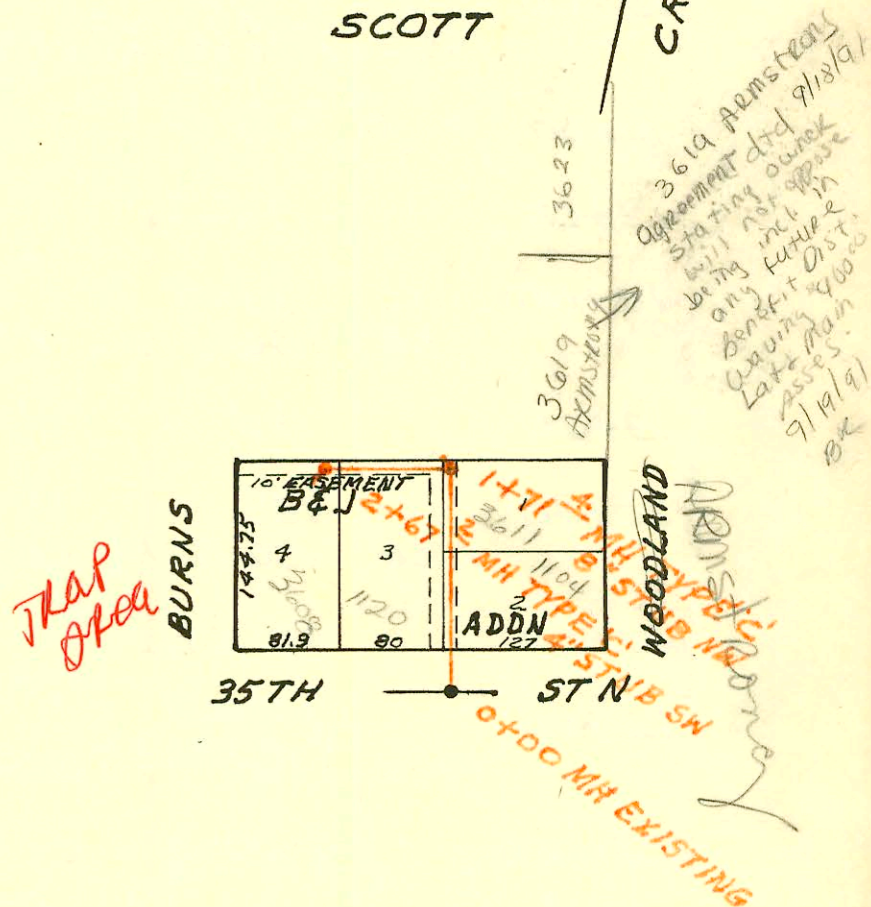

SCALE 1" = 150'

LATERAL 15 MAIN 7 SAN SEWER N^o 23
BUILT BY: MID STATES CONST. CO.
PROJ. N^o 468-76-245-80667-000-000-001
BOOKED 6-26-80 FROM DCD 95

12-27-80
13-25-80
14-11-80
15-11-80
16-11-80
100-11-80

Refer to sewer
BOOK M 265 for sewer

