

PAWNEE

ATLANTA


MAXWELL

SAVANNAH

HADDEN

CRAWFORD

SCALE 1" = 150'

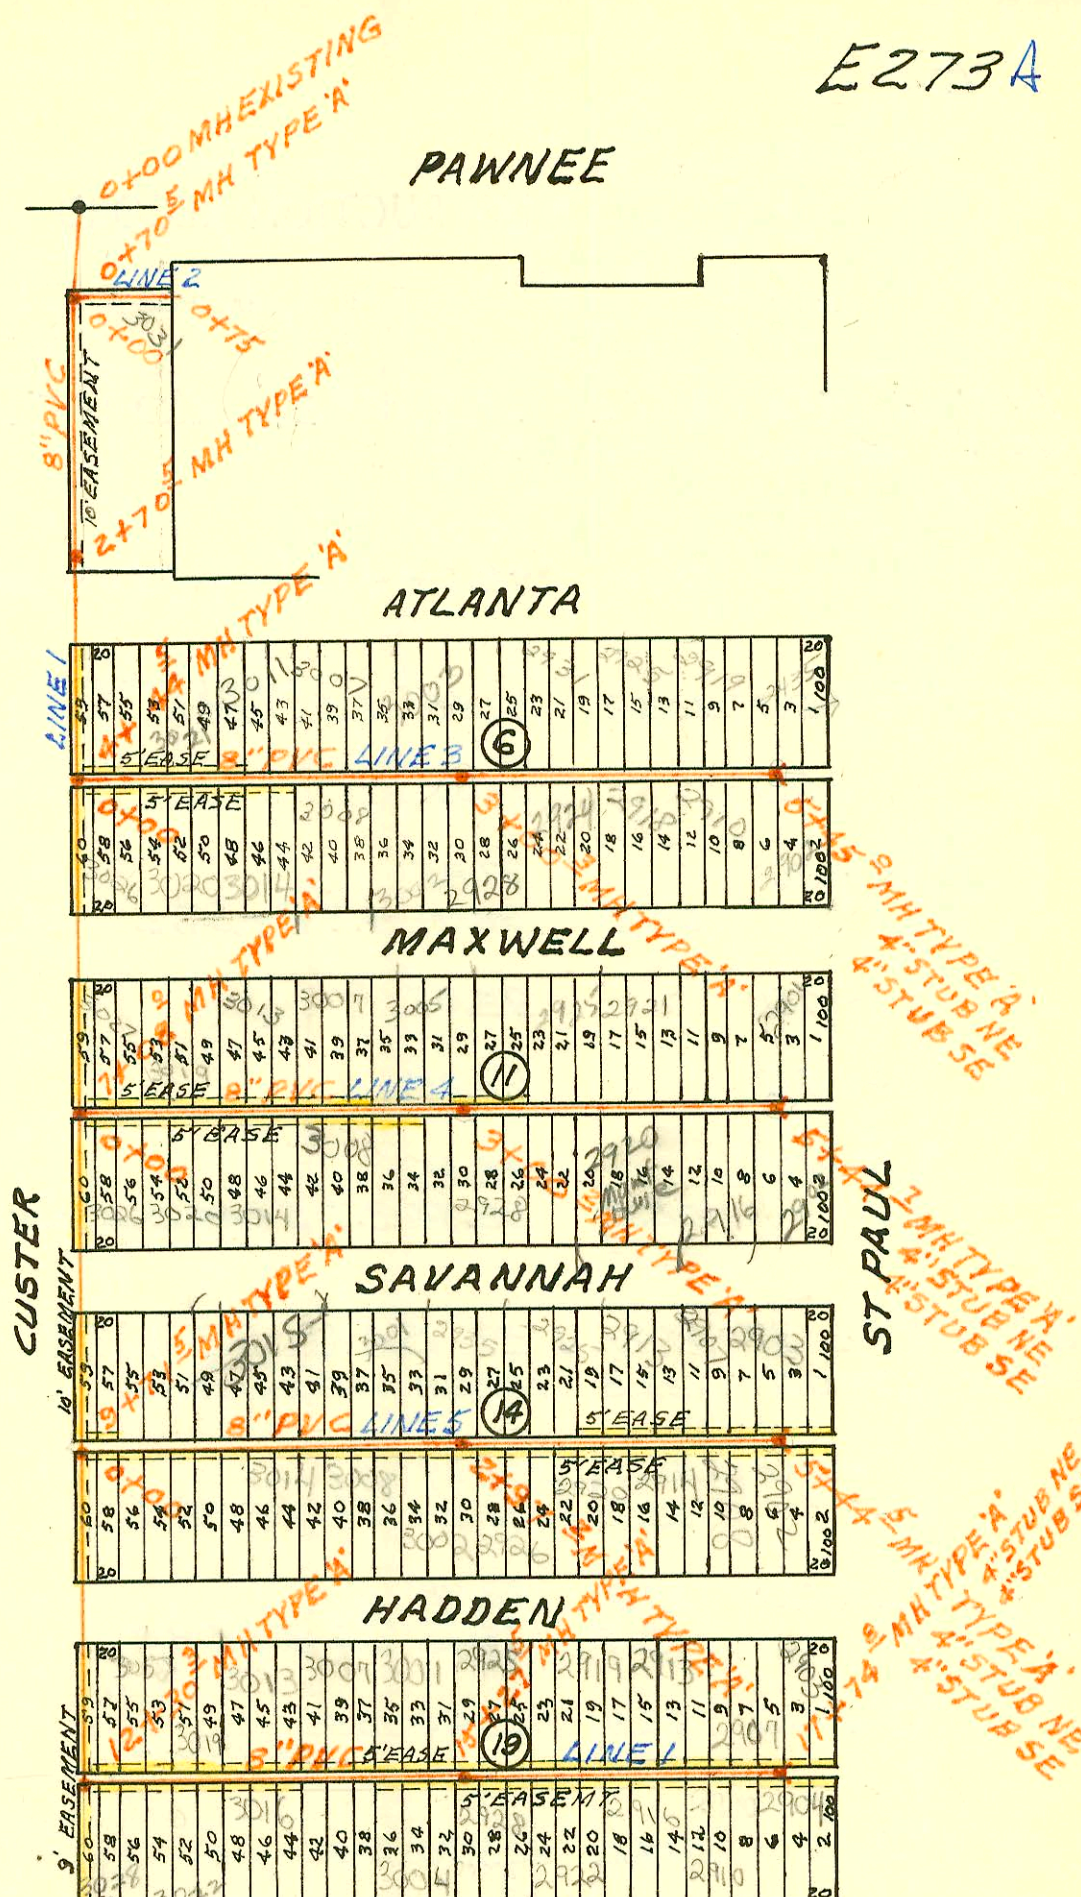

LATERAL 7 MAIN 16 SAN SEWER NO 22  
 BUILT BY: CLEARWATER EXCAVATING CO.  
 PROJ. NO 468-76-245-80705-000-000-001  
 BOOKED 7-25-80 FROM DCD 95

on map

CONSTRUCTION RECORD

SERVICE RECORD

STATION	ELEVATION		Depth	MANHOLE	4-INCH "Y" BRANCHES		No. of Permit		House Number		DATE OF PERMITS			
	Ground	Grade			North West	South East	North West	South East	North West	South East	North West	South East	North West	South East
LAT 7 MAIN 16 55 N <sup>o</sup> 22 CONT'D														
LAT 7 LINE 4 CONT'D	4+00	97.75												
	5+00	97.95												
	102.4	98.04	4.4	5+44.7	4" STUB NE	4" STUB SE	17478	253 01121	2927 W. Maxwell	2920 Savannah	2916 Savannah	11-5-81 5-30-84 7-21-89 5-29-83		
LINE 5														
	0+00	103.9	6.5	0+00=9+71.5 LINE 1										
	1+00	97.65												
	2+00	97.85												
	102.3	98.04	4.3	2+97.2										
	3+00	98.05												
	4+00	98.25												
	5+00	98.45												
	102.2	98.54	3.7	5+44.5	4" STUB NE	4" STUB SE	#3	076539	3027 Savannah	3036 Hadden	3014 Hadden	12-20-86 11-21-80 3-26-92 2-22-80 2-22-80 2-22-80 5-28-84 2-22-80 2-22-80 2-22-80 7-2-80 7-2-80 2-22-80 2-22-80		
LATERAL 31 MAIN 21 SAN SEWER N <sup>o</sup> 22														
LATERAL LINE 1	0+00	133.8	122.28	11.5	EXISTING									
	1+00	133.3	122.58	10.7										
	133.7	122.81	10.9	1+44.3										
	2+00	133.8	122.98	10.8										
	133.7	123.30	10.4	2+68.8										
	3+00	133.9	123.40	10.5										
	134.2	123.66	10.5	3+86.3										
	4+00	134.2	123.70	10.5										
	5+00	134.7	124.00	10.7										
	135.2	124.20	11.0	5+66.6										
	6+00	135.5	124.29	11.2										
	7+00	135.2	124.59	10.6										
	135.0	124.68	10.3	7+28.6										
	8+00	135.2	124.89	10.3										
	9+00	135.4	125.19	9.7										
	135.0	125.45	9.6	9+52.8										
	10	135.3	125.56	9.7										
		125.66	9.6	9+87.7										
	10+00	135.3	125.70	9.6										
	11+00	134.8	126.00	8.8										
	12+00	134.5	126.30	8.0										
		126.48	7.9	12+61.2										
	13+00	134.5	126.70	7.8										
	14+00	133.7	126.99	6.7										
	133.6	127.21	6.4	14+72.4										
	15+00	133.8	127.40	6.4										
	134.0	127.63	6.4	15+78.4	4" STUB NE									
LINE 1A														
	0+00	135.0	125.45	9.6	0+00=9+52.8 LINE 1									
		134.4	125.62	8.8	0+56.8	4" STUB NE	4" STUB S	7894				4-20-83		

CONT'D NEXT PAGE

