


SCALE 1" = 150

Plot 8-25

LATERAL 31 MAIN 21 SAN SEWER N<sup>o</sup> 22  
BUILT BY: UTILITY CONTR, INC.  
PROJ. N<sup>o</sup> 468-76-245-80665-000-000-001  
BOOKED 8-13-80 FROM DCD 95

on map

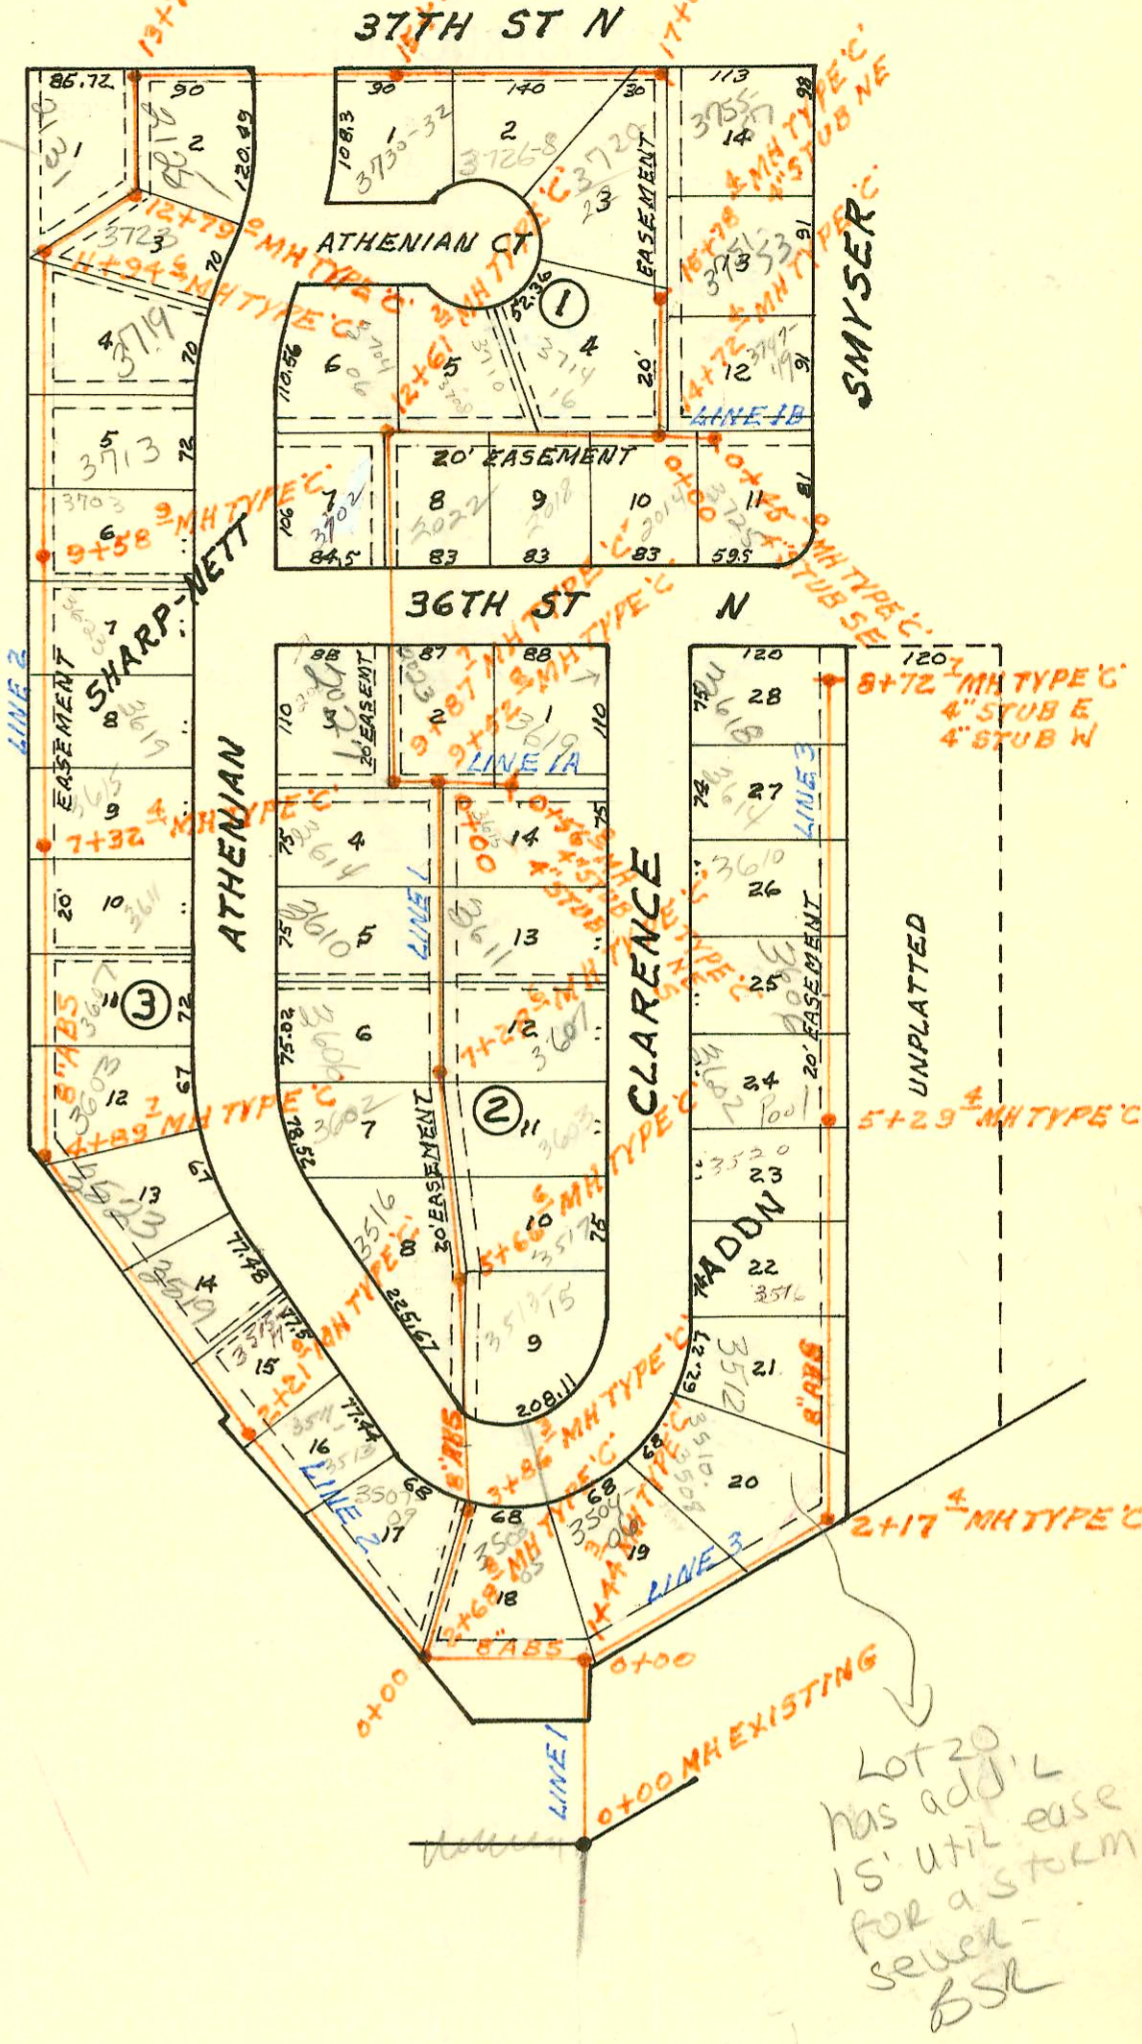

2002-01243 5/10a 3713 N Athenian - Reddi Root - Msmt good - tied to swrk 1' from main  
1022, 2 Dir co, 1 Fernco @ house 4" sch 40 (Replace Line)

CONSTRUCTION RECORD						SERVICE RECORD						
STATION	ELEVATION		Depth	MANHOLE	4-INCH "Y" BRANCHES		No. of Permit		House Number		DATE OF PERMITS	
	Ground	Grade			North West	South East	North West	South East	North West	South East	North West	South East
LAT 31 MAIN 21 SS N <sup>o</sup> 22 CONT'D												
LINE 1B 0+00	133.6	127.21	6.4	0+00=14+72.4 LINE 1								
	133.8	127.45	6.4	0+45.0	4" STUB SE		4975		3725 Smyser			12-28-81
LINE 2 0+00	133.7	123.30	10.4	0+00=2+68.8 LINE 1								
1+00	134.2	123.60	10.6		1+75.5 tap 1+77.0 tap		16711 7435 7436		3507-09 N Athenian 3511 N Athenian 3513 N Athenian			7-30-86 1-26-83 1-26-83
2+00	134.5	123.90	10.6									
	134.5	123.96	10.5	2+21.0	2+51.7 tap 2+63.3 tap		# 02931 802930		3515 N Athenian 3517 N Athenian			3-26-81 3-26-81
3+00	134.1	124.20	9.9									
					3+23.7 tap		1711		3519 Athenian			11-5-80
4+00	134.1	124.50	9.6									
	134.0	124.87	9.2	4+89.7	4+30.1 tap		1795		3523 Athenian			11-7-80
5+00	134.3	124.90	9.4		4" PVC 40 5+46.7		93 306107 94-		3603 Athenian 3607 section Athenian			12-9-93 1-5-94
6+00	134.5	125.20	9.3									
					6+68.9 tap		12570		3611 Athenian			11-8-84
7+00	134.6	125.50	9.1									
	134.8	125.60	9.2	7+32.4								
8+00	135.7	125.80	9.9		1+72.4 tap 8+59.4 tap		10979 15260		3615 Athenian 3619 Athenian			5-21-84 12-11-85
9+00	135.6	126.10	9.5									
	135.5	126.28	9.2	9+58.9	9+14.3 tap 9+83.9 tap		3137 3138		3623 N Athenian 3703 N Athenian			4-16-81 4-16-81
10+00	135.3	126.40	8.9									
					4" SCHED 10+52.9 tap		2002-01243 21048		3713 R see next Athenian pg			5-1-82 7-11-88
11+00	136.0	126.70	9.3									
	135.7	126.98	8.7	11+94.6	SDR 35 11+12.6 N/C		96-17407		3719 Athenian			2-9-86
12+00	135.5	127.10	8.4									
	135.0	127.34	7.7	12+79.0			97-		3723 Athenian			5-21-97
13+00	135.3	127.50	7.8									
	135.1	127.71	7.4	13+71.5			7783	7284	2131 W Athenian 3724 N Athenian	2135 W 3725 N	7-18-80	5-12-80
14+00	135.9	127.90	8.0									
15+00	134.2	128.20	6.0									
	133.7	128.44	5.3	15+78.7								
16+00	133.7	128.50	5.2		4" SDR 35 15+59.7 tap 4" SDR 35 15+89.7 tap 16+57.1 tap		92-3675-7 92-3675-7 1173		3730 N Athenian 3732 N Athenian 3726-27 Athenian			10-14-92 10-14-92 8-7-84
17+00	133.5	128.80	4.7									
	134.7	129.06	5.6	17+85.6	17+57.6 tap	4" STUB SE	19312	961033-7	3720 N Athenian 3725-27 Smyser		10/14/87	67496
LINE 3 0+00	133.7	122.91	10.8	0+00=1+44.3 LINE 1								
1+00	133.8	123.21	10.6		0+80.5 tap		25995		3504-06 Clarence			8-23-90
2+00	134.4	123.51	10.9		1+75.4 tap		9355		3508 N. Clarence			10-3-83
	134.5	123.56	10.9	2+17.4								
	134.5	123.66	10.8									
3+00	134.5	123.91	10.6		3+24.1 tap		215740		3512 N Clarence			12-17-79
4+00	134.5	124.21	10.3		4+36.7 tap 4+87.4 tap		7283 6783		3516 CLD RENEW 3720 N. Clarence			12-30-84 10-12-87
5+00	134.5	124.51	10.0									
	134.5	124.60	9.9	5+29.4	5+86.4 tap		1355		3602 Clarence			9-24-80
6+00	134.3	124.81	9.5		6+27.2 tap		275741		3606 N. Clarence			12-17-79
7+00	134.4	125.11	9.3		7+12.7 tap 7+90.7 tap		9128 4879		3610 N. Clarence 3614 Clarence			9-6-83 12-2-81
8+00	134.0	125.41	8.6									
	134.0	125.63	8.4	8+72.7		4" STUB W 4" STUB E	1714		3618 N. Clarence			11-7-80

94-3151-7-31-94-3607 N. Athenian = Tap 26 Fr. N. of E.S.P. property line = 4" SDR 35