

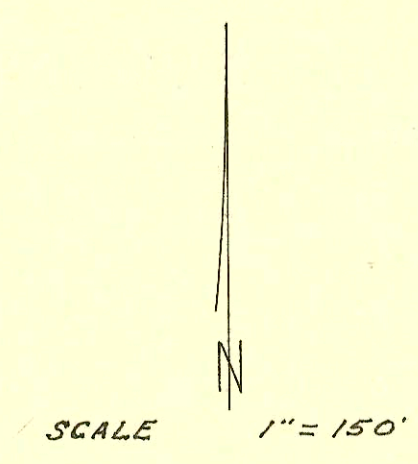


LINE RELOCATED SEE K-285 E276A

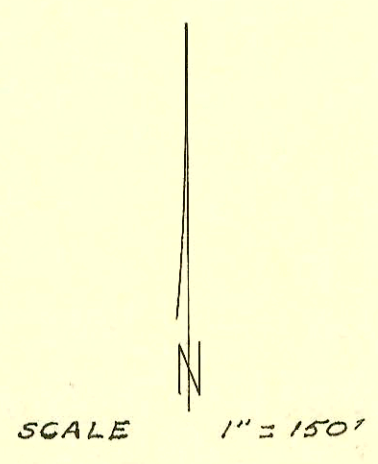

LATERAL 50 MAIN 1 SOUTHWEST INTERCEPTOR
 BUILT BY: CLEARWATER EXCAVATION CO.
 PROJ. NO 468-76-245-80512-000-000-001
 BOOKED 8-2-80 FROM JLA 22

ON MAP

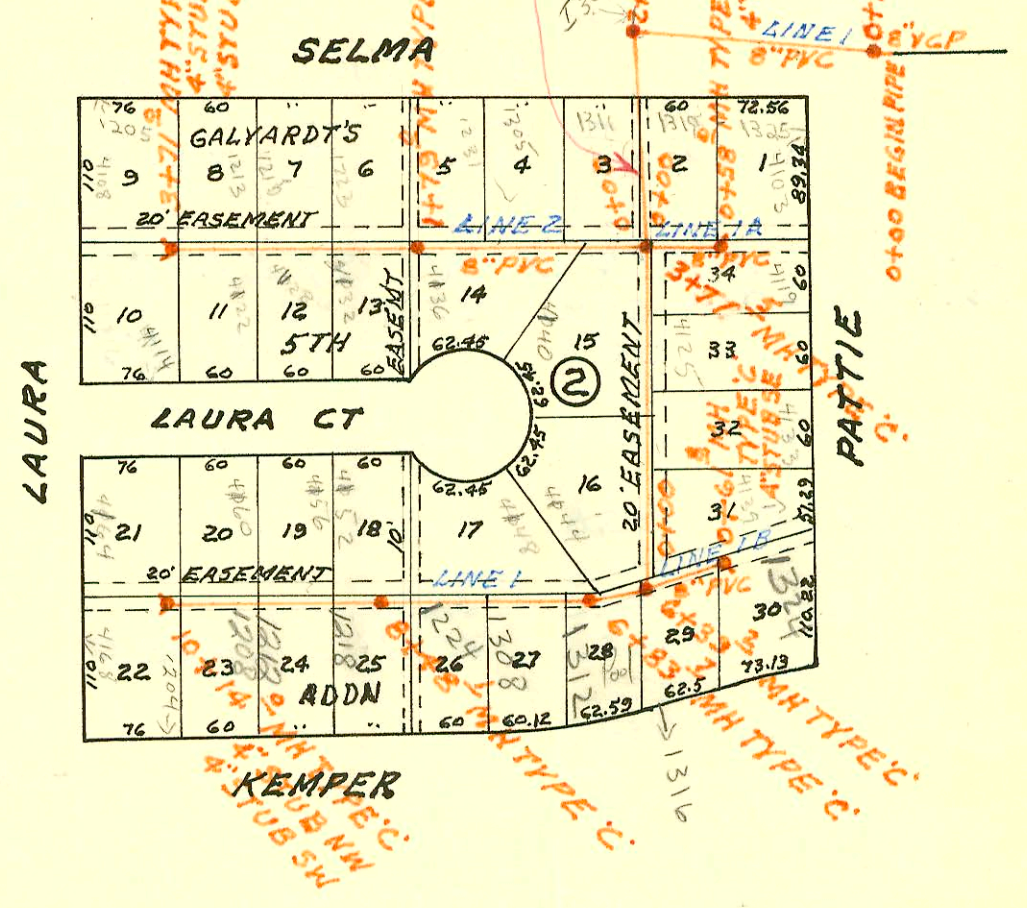

LATERAL 20 MAIN 3 WESTLINK SEWER
 BUILT BY: DEAN EXCAVATION
 PROJ. NO 468-76-245-80815-000-000-001
 BOOKED 8-9-80 FROM AG 13

ON MAP

