


LINE RELOCATED SEE K-285 E276A

SCALE 1" = 150'

LATERAL 50 MAIN 1 SOUTHWEST INTERCEPTOR
 BUILT BY: CLEARWATER EXCAVATION CO.
 PROJ. NO 468-76-245-80512-000-000-001
 BOOKED 8-2-80 FROM JLA 22


ON MAP

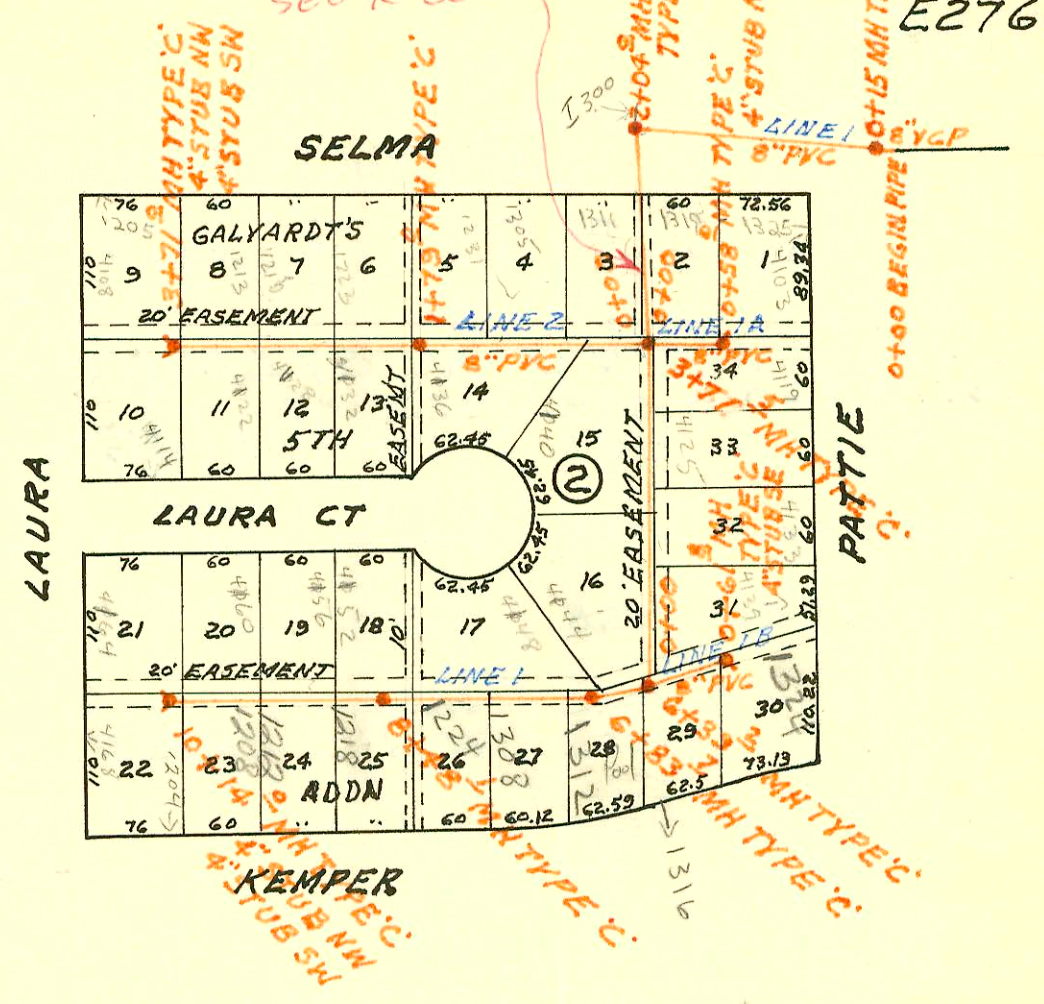

SCALE 1" = 150'

LATERAL 20 MAIN 3 WESTLINK SEWER
 BUILT BY: DEAN EXCAVATION
 PROJ. NO 468-76-245-80815-000-000-001
 BOOKED 8-9-80 FROM AG 13

ON MAP

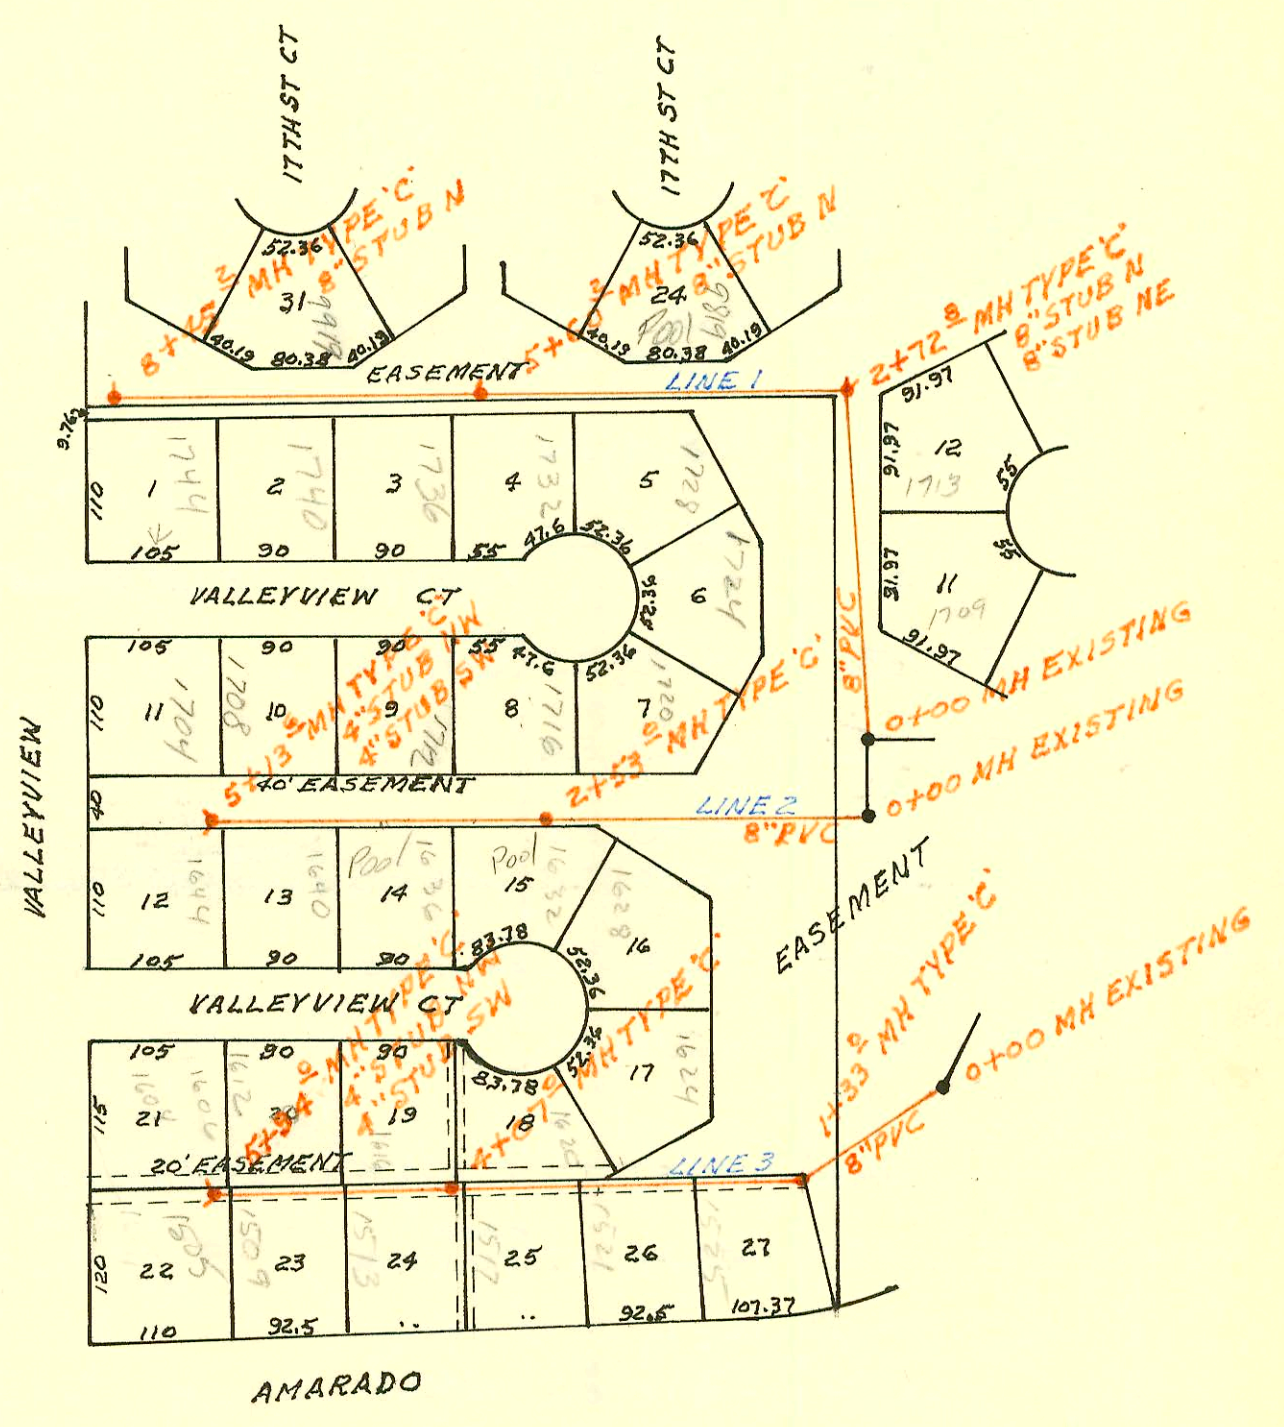

CONSTRUCTION RECORD

SERVICE RECORD

STATION	ELEVATION		Depth	MANHOLE	4-INCH "Y" BRANCHES		No. of Permit		House Number		DATE OF PERMITS			
	Ground	Grade			North West	South East	North West	South East	North West	South East	North West	South East	North West	South East
LAT 20 MAIN 3 WESTLINK (CONT'D)														
LINE 1 CONT'D	8+00	155.9 156.1	147.64 147.78	8.3 8.3										
					8+45.2	8" STUB N								
LINE 2	0+00	153.2	146.10	7.1	0+00 EXISTING									
	1+00	153.8	146.30	7.5		1+27.0		6267		1730 Valleyview		7-30-82		
	2+00	154.2 154.3	146.50 146.61	7.7 7.7			2+20.4	7396		1628 Valleyview		1-20-83		
					2+53.0			2000-02219		1636 N/E Valleyview		10-10-80		
	3+00	154.7	146.70	8.0		3+14.8	3+05.0	3091		1716 Valleyview	4-9-81	11-8-83		
						3+53.0	3+81.0	8297		1712 Valleyview	6-2-83	10-3-81 10-10-80		
	4+00	154.9	146.90	8.0		4+67.8	4+36.6	11510		1708 Valleyview		7-18-84		
								2262			1-5-81			
	5+00	155.0 155.0	147.10 147.13	7.9 7.9		5+13.6	4" STUB NW	102457	10853	1704 Valleyview	1-22-81	5-7-84		
LINE 3	0+00	153.0	146.65	8.4	0+00 EXISTING									
	1+00	153.5 153.6	146.95 147.05 147.15	6.6 6.6 6.5		1+33.0				1525 Amarado		8-27-80		
							1+41.0		1102					
	2+00	153.6	147.35	6.3				3707	7393	1624 Valleyview	1521 B Amarado	7-21-81	9-11-80 1-20-83	
	3+00	153.8	147.65	6.2				3651		1620 Valleyview	1517 Amarado	7-10-81	9-16-80	
	4+00	154.2 154.2	147.95 147.97	6.3 6.2		4+07.0	4+61.0		12112	1616 Valleyview		9-25-84		
							4+66.2		8610	1513 Amarado		7-5-83		
	5+00	154.5 154.7	148.25 148.53	6.3 6.2		5+94.0	4" STUB NW	3468	15679	1612 Valleyview	1509 Amarado	6-9-81	6-23-81	
							4" STUB SW	2239		1505 Amarado		5-5-81	2-19-86	
LATERAL 17 MAIN 3 WESTLINK SEWER														
LINE 1	0+00	156.0	147.88	8.1	0+00 EXISTING									
	1+00	156.6	148.18	8.4					10980	9927 1725 CT		5-21-84		
									13963	9923 1725 CT		6-7-85		
	2+00	156.7 156.6	148.48 148.68	8.2 8.2		2+65.3	4" STUB NE		10797	9923 W 1725		4-26-84		
LINE 2	0+00	153.0	147.03	7.9	0+00 EXISTING									
	1+00	156.0	147.23	8.8					9346	9823 W 1725		9-30-83		
									15212	9911 1725 CT	10-16-85			
	2+00	156.0 155.4	147.43 147.56	8.6 7.8		2+66.5	4" STUB NW	16010	9974	9929 W 1725	9827 W 1725 CT	3-28-86	3-11-85	
							4" STUB NE	14344		9923 W 1725 N	9922 1725 CT	1-9-84	7-26-85	
LINE 3	0+00	153.8	146.34	7.5	0+00 EXISTING									
	1+00	154.1	146.54	7.6					6943	9813 W 1725 CT		5-11-82		
									9621	1725 Amarado		3-2-83		
	2+00	154.6 154.6	146.74 146.87	7.9 7.7		2+65.5	4" STUB NW	9630	9356	9809 W 1725	1739 Amarado	11-8-83	8-9-83	
							4" STUB E	8949		1725 W 1725		10-4-83		
LINE 4	0+00	154.0	146.34	7.7	0+00 EXISTING									
	1+00	153.5 155.0	146.54 146.64 146.74	7.0 8.4 8.3		1+50.1			11554	1713 Amarado		7-23-84		
									8409	1721 Amarado		6-17-83		
	2+00	154.0 154.7	146.84 146.91 147.01	7.2 7.8 7.7		2+35.9			10798	1717 Amarado		4-26-84		
							4" STUB SE	13099		1721 Amarado		2-26-85		
							2+65.3	7860		1727 Amarado		4-15-83		
	3+00	153.7	147.14	6.6										
	4+00	154.2 155.3	147.34 147.35	6.9 8.0		4+07.0	4" STUB NW	8933	8934	1743 Amarado	1749 Amarado	8-8-83	8-8-83	

CONT'D NEXT PAGE