


SCALE 1" = 150'

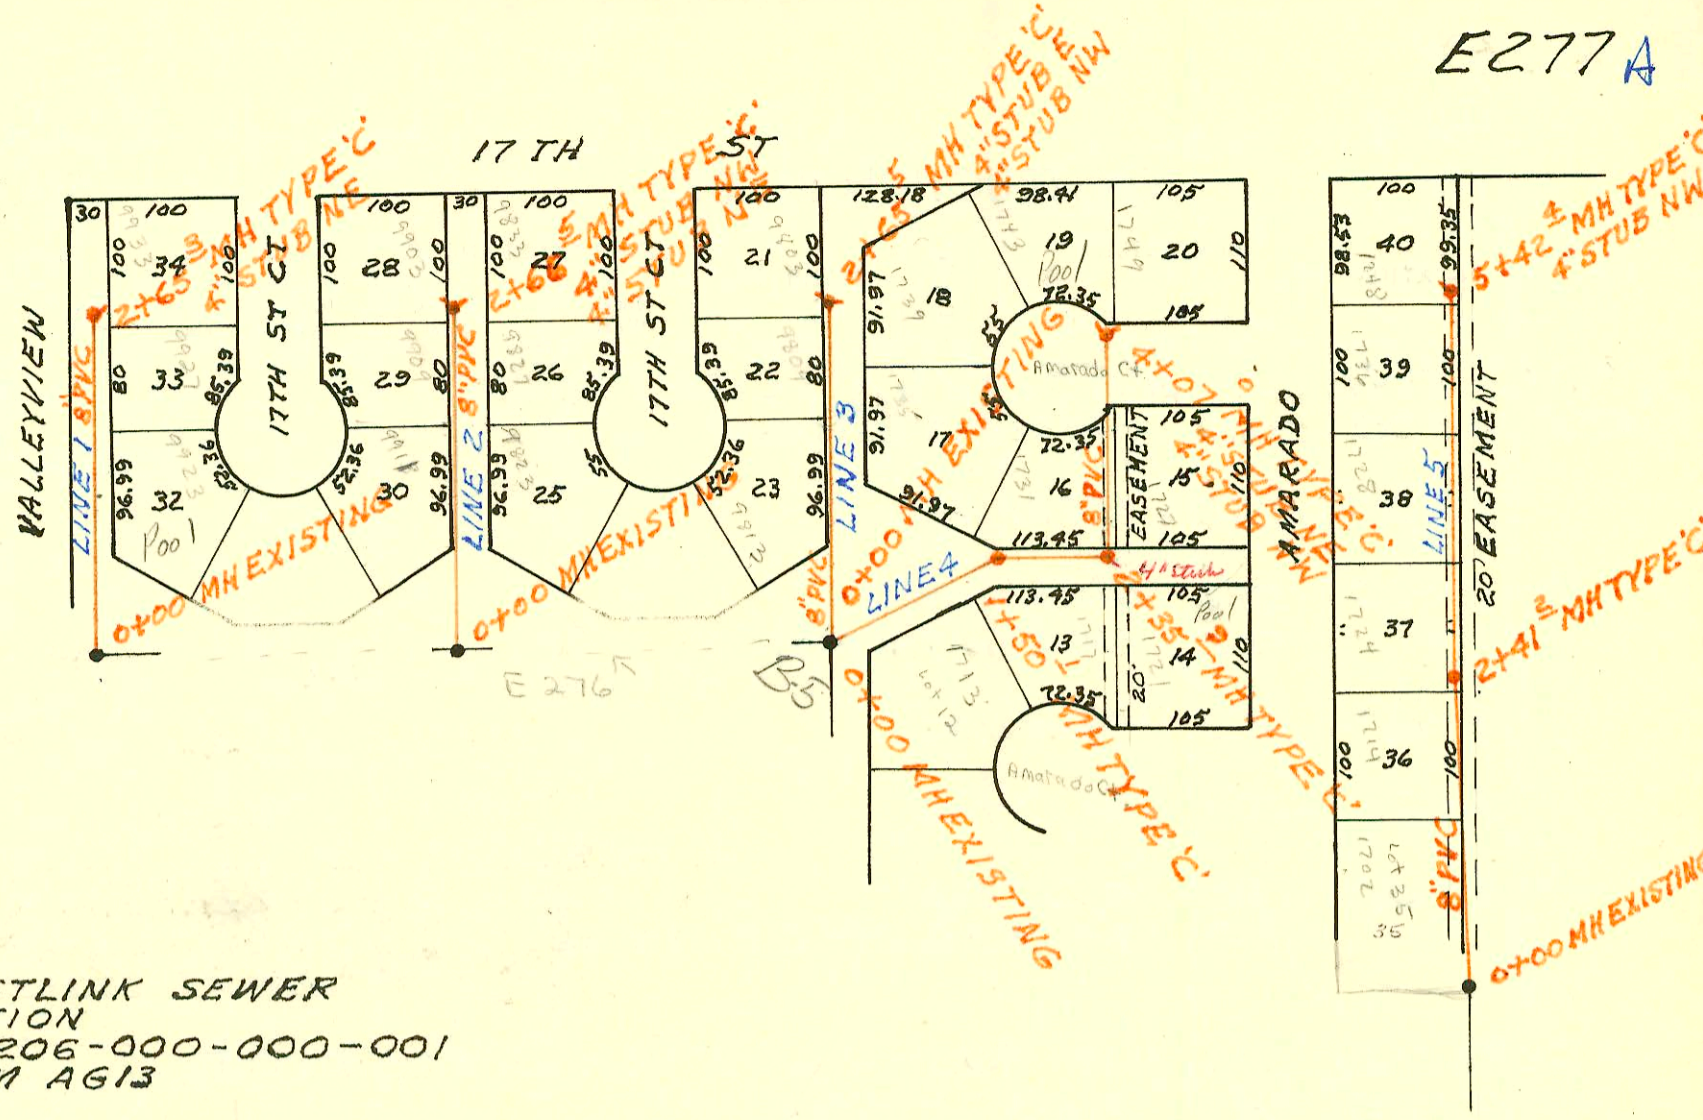

LATERAL 17 MAIN 3 WESTLINK SEWER  
 BUILT BY: DEAN EXCAVATION  
 PROJ. NO 468-76-245-80206-000-000-001  
 BOOKED 8-11-8 FROM AG13

*on map*

